
MAR-BERN COAL CO
MINE WORKING

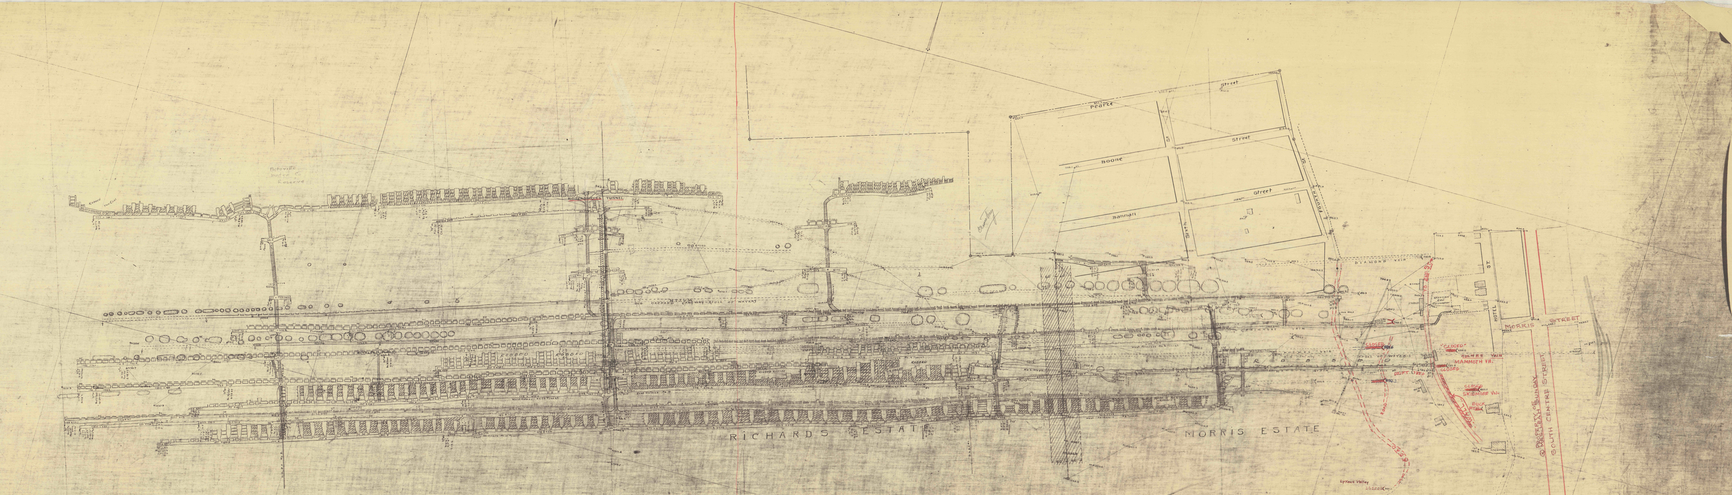

..Southern Coal Fields..
SHERMAN Colliery: WORKINGS, Veins West of
CENTRE ST., 1"=100'. NORWEGIAN TWP. SCHUYLKILL COUNTY, PA. POTTSVILLE
..POSTED: 9-18-1925; 9-21-1926; 3-21-1927; 4-24-1928; 7-7-1930; 1-15-1931; 8-11-1931; 7-31-1932.

STATE MINE INSPECTOR'S