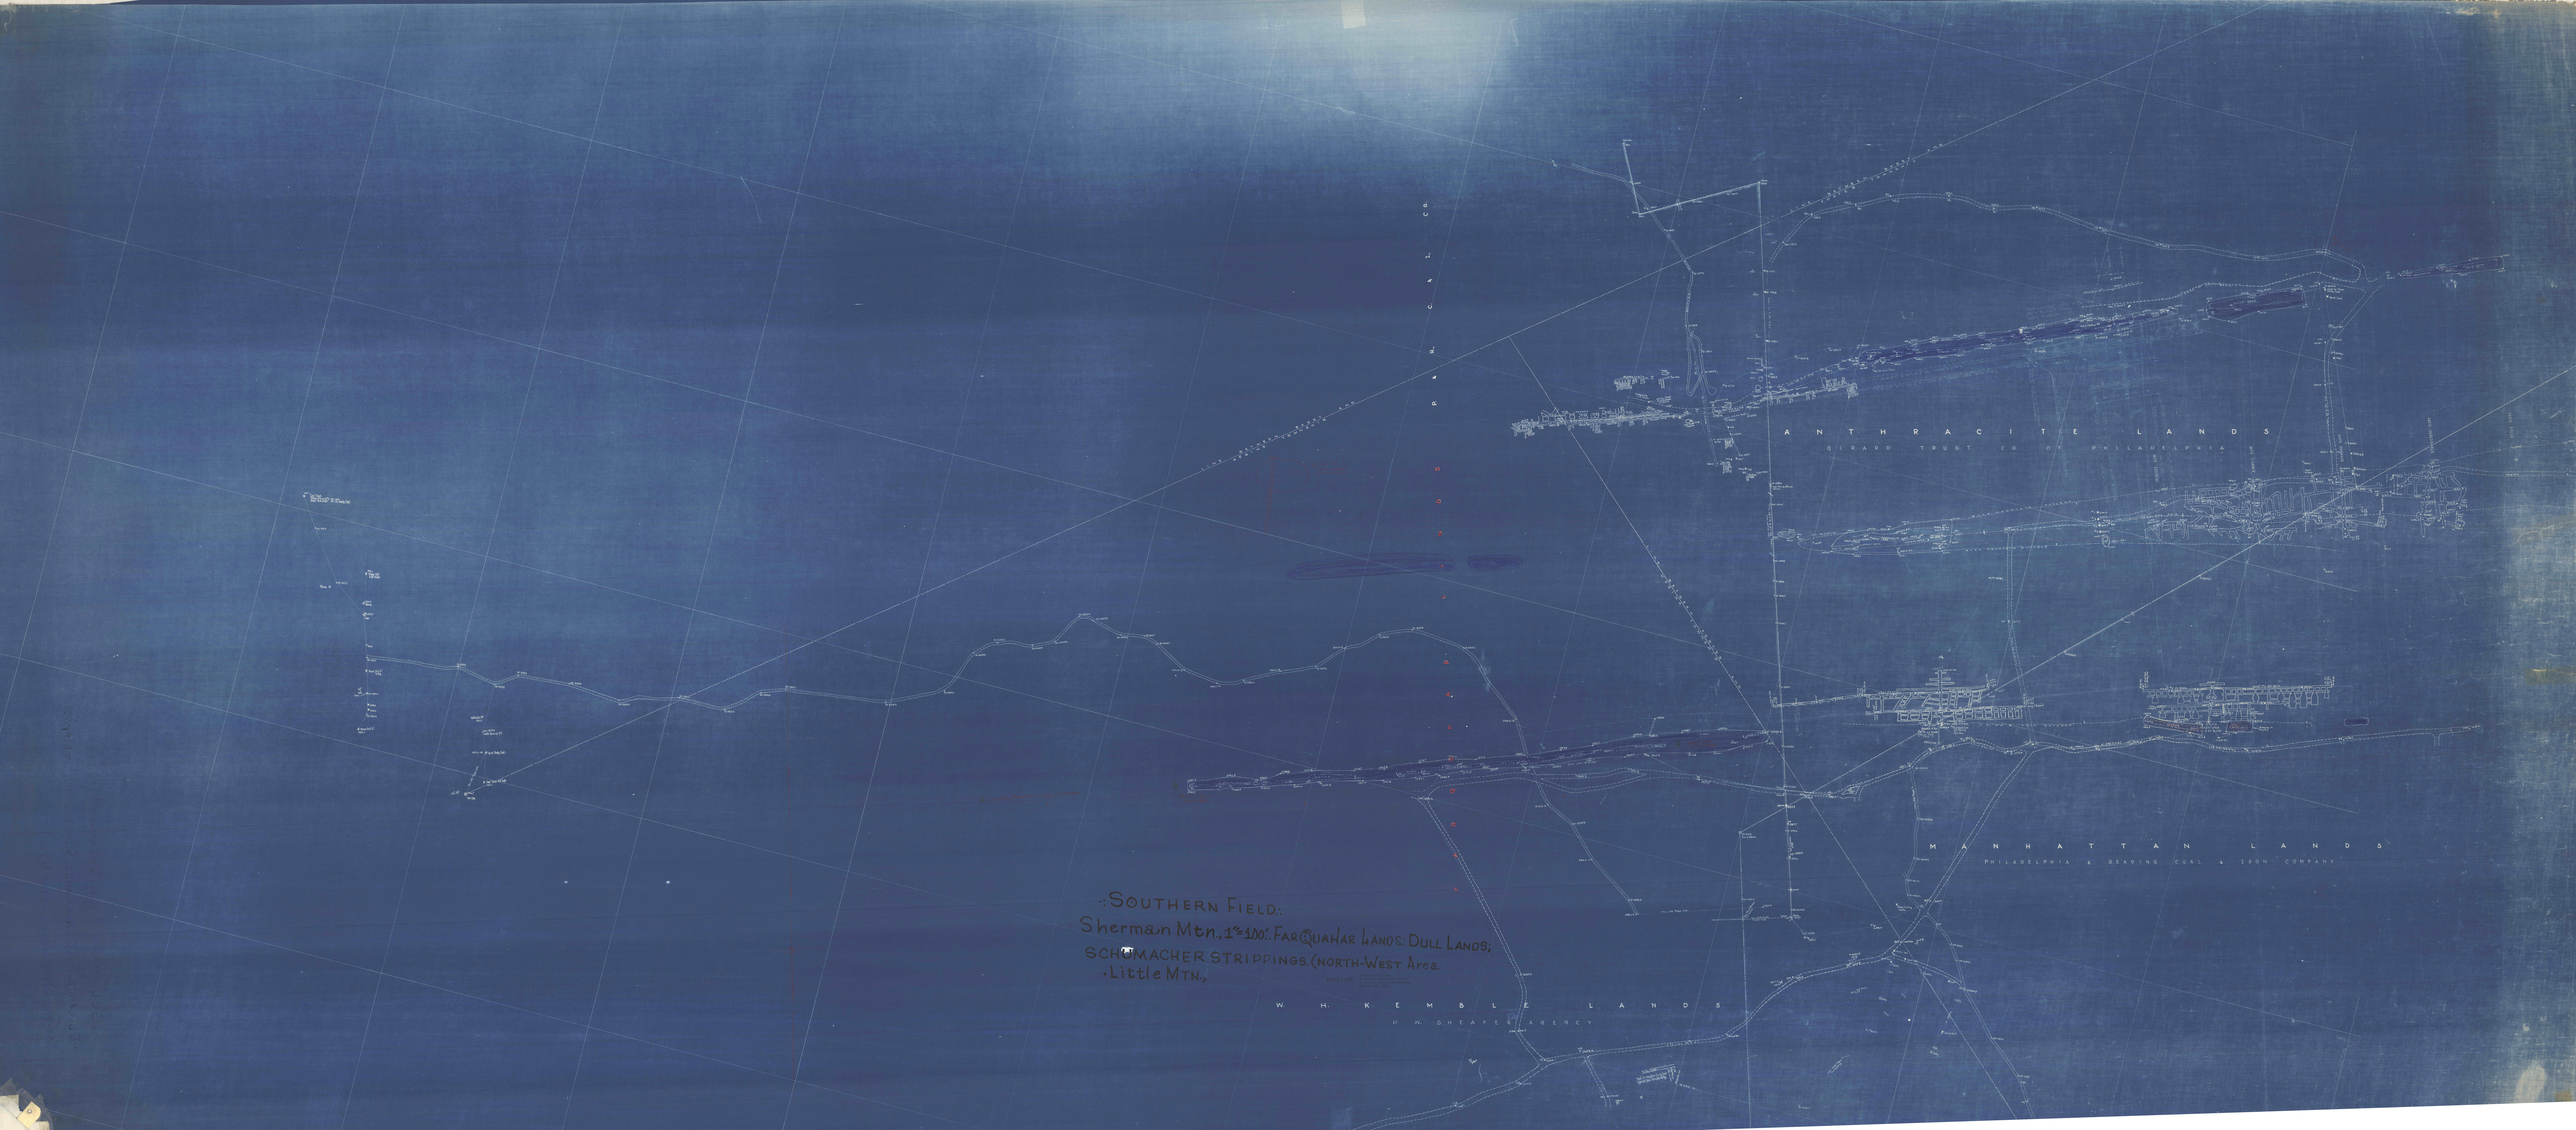

ANTHRACITE LANDS
GIRARD TRUST CO. OF PHILADELPHIA
MANHATTAN LANDS
PHILADELPHIA & READING COAL & IRON COMPANY
W. H. KEMBLE LANDS
P. W. SHEAFER AGENCY
SOUTHERN FIELD:
Sherman Mtn., 1"=100'. FARQUAHAR LANDS: DULL LANDS;
SCHUMACHER STRIPPINGS (NORTH-WEST Area.
Little Mtn.,