
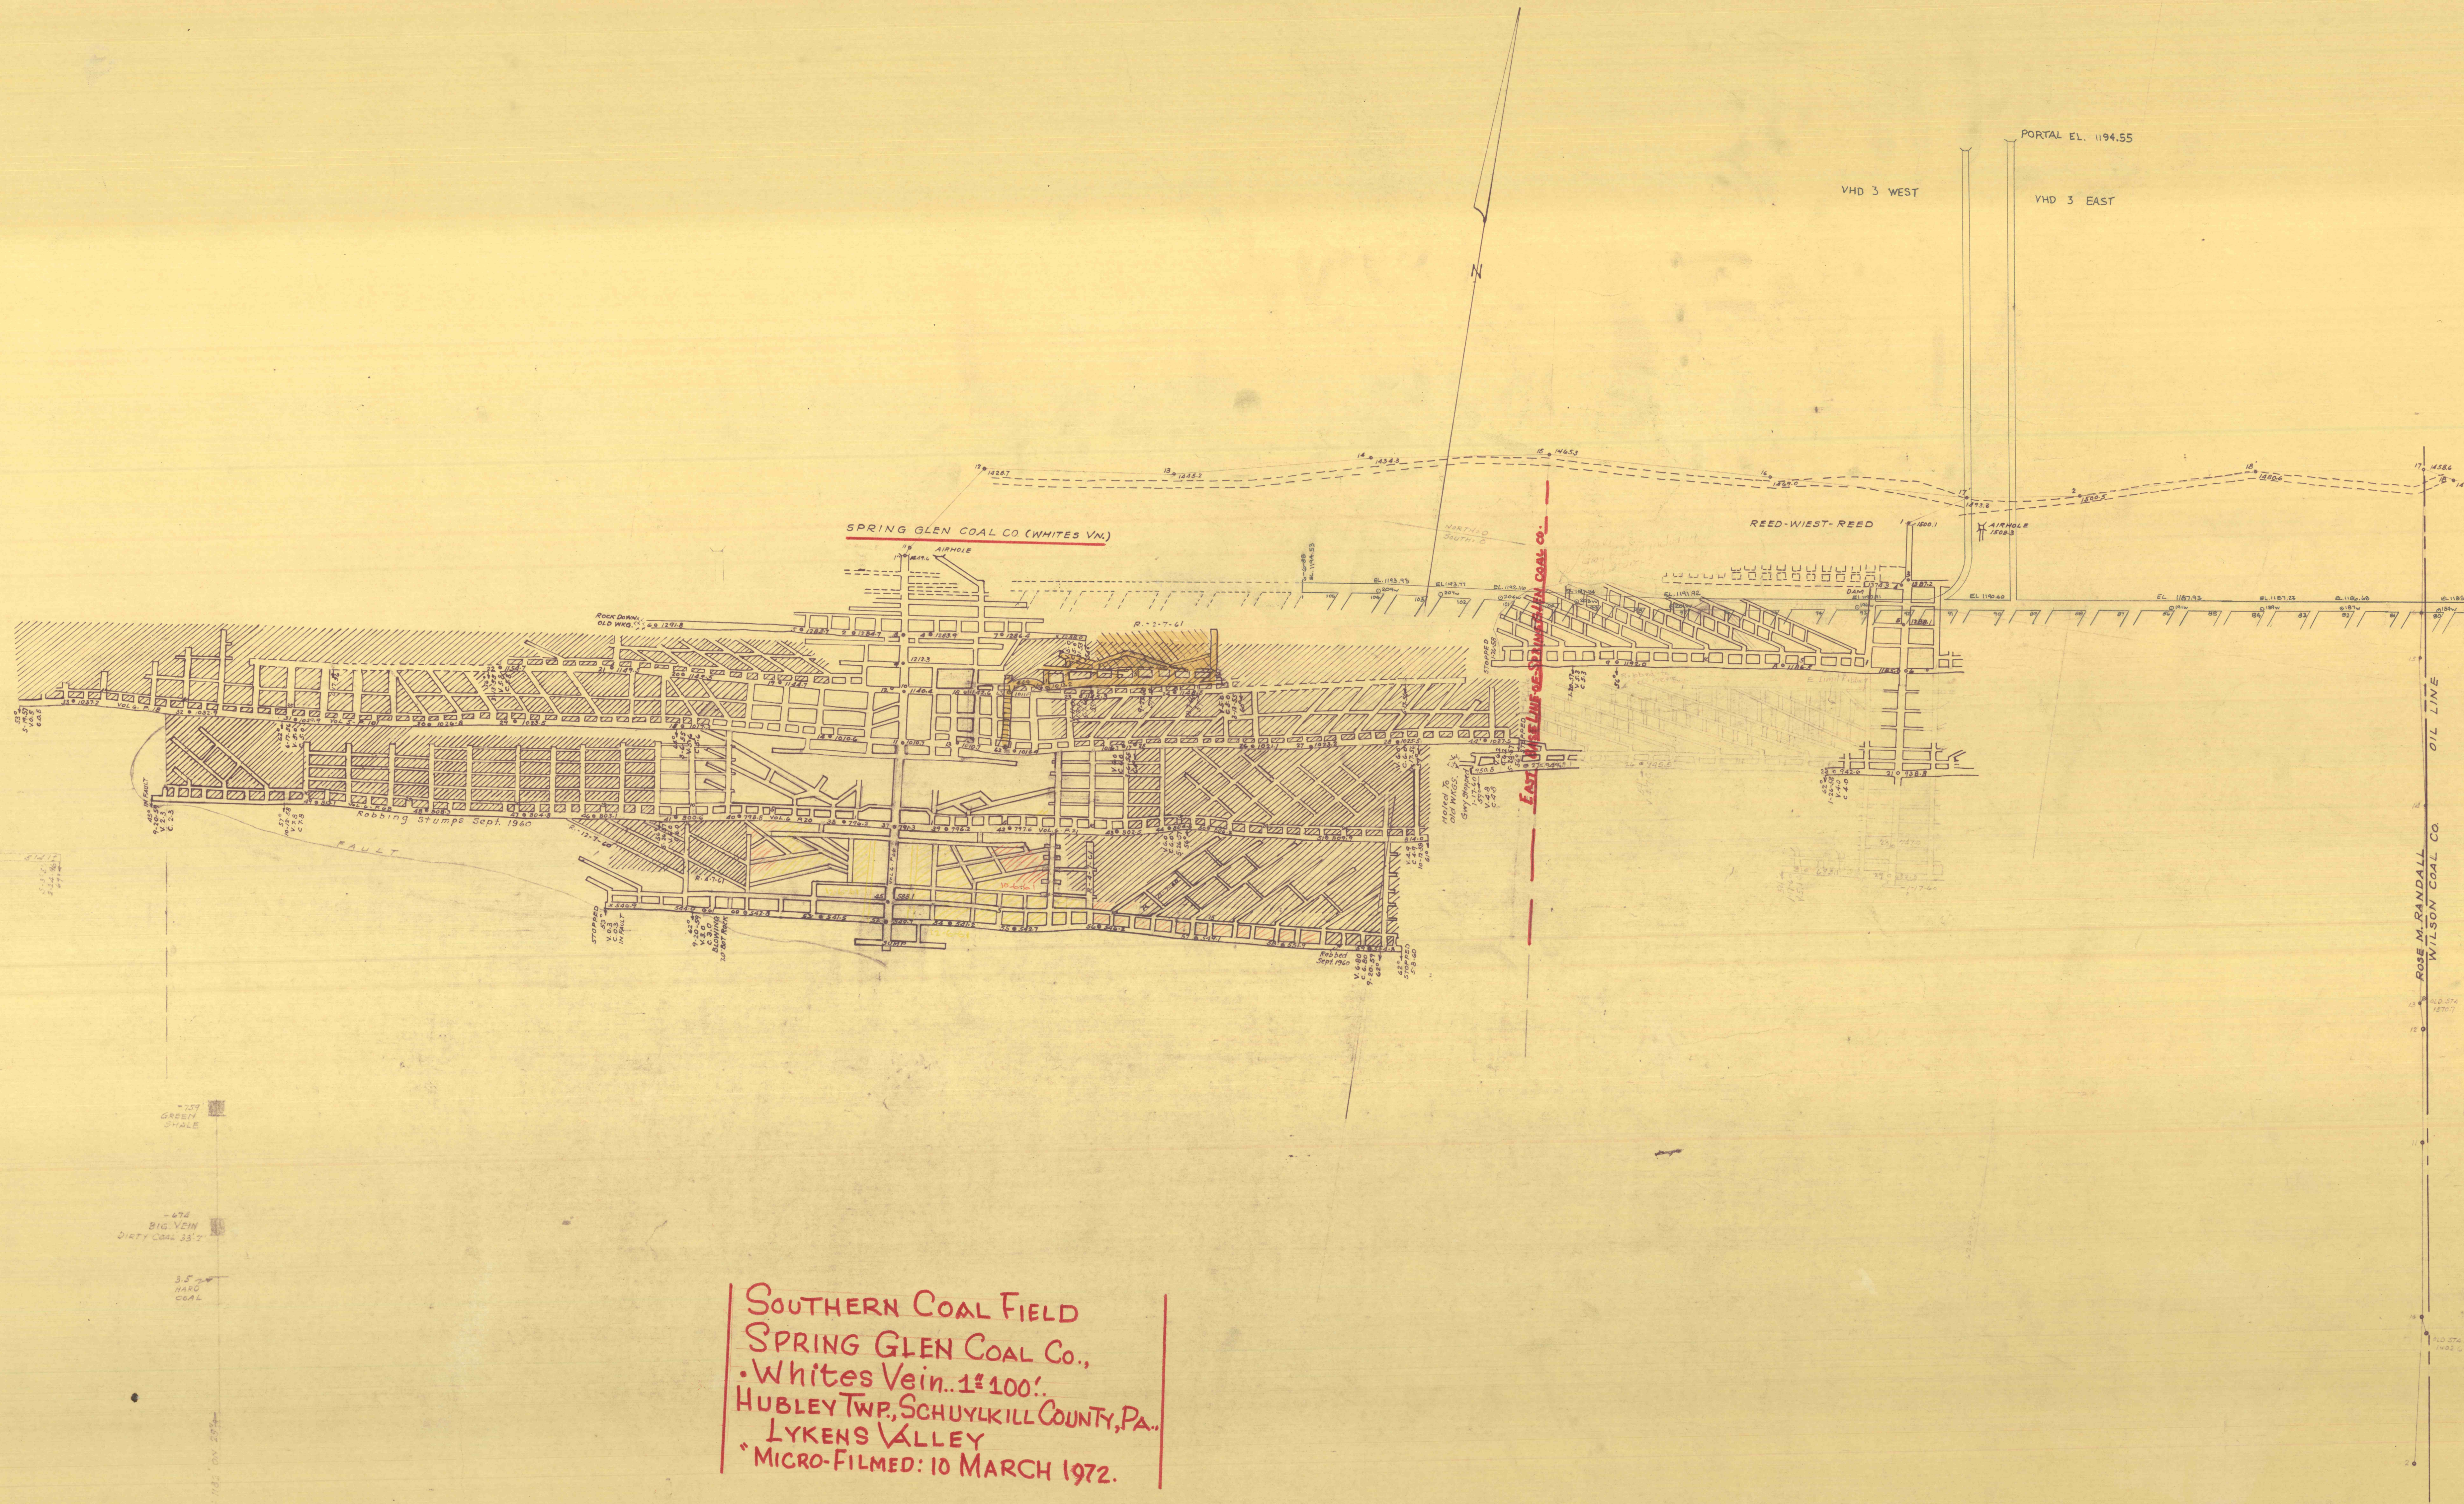


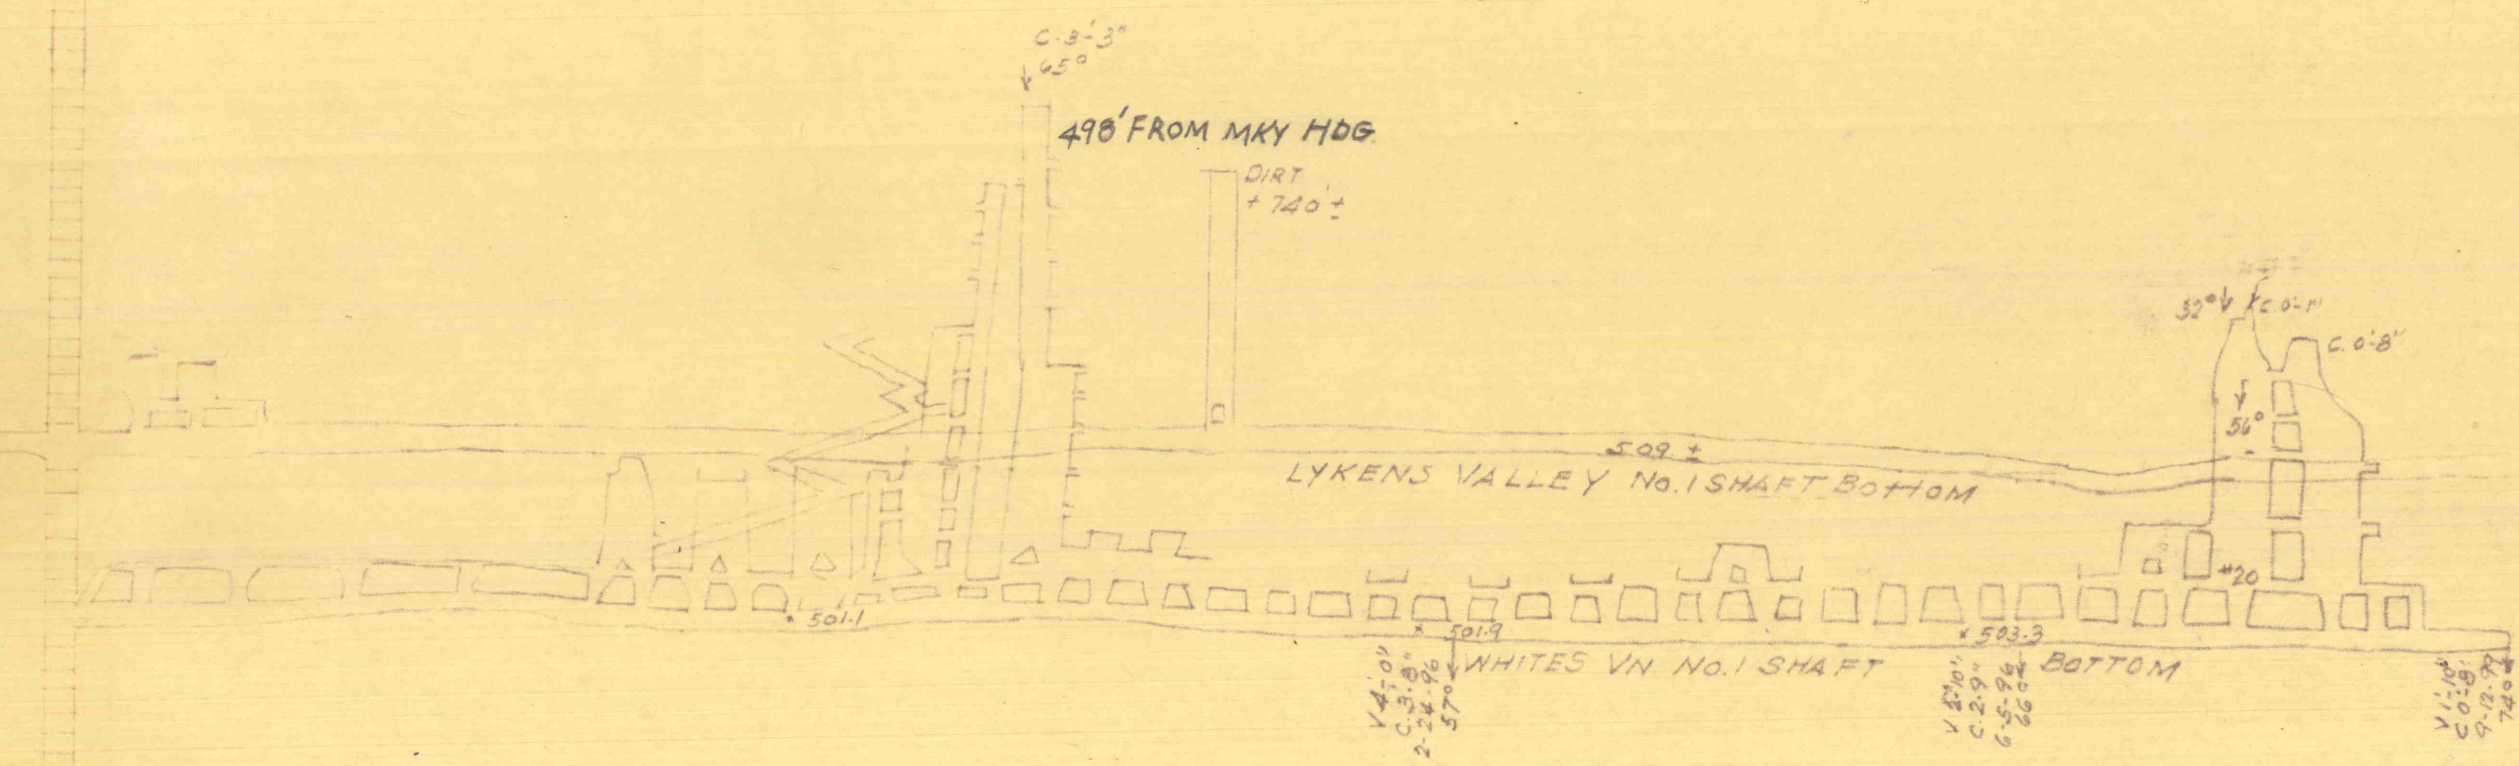

SOUTHERN COAL FIELD
 SPRING GLEN COAL CO.,
 • Whites Vein...1±100'.
 HUBLEY TWP, SCHUYLKILL COUNTY, PA.,
 LYKENS VALLEY
 * MICRO-FILMED: 10 MARCH 1972.

MF
 MAR 10 1972

No. 1
 SHAFT.