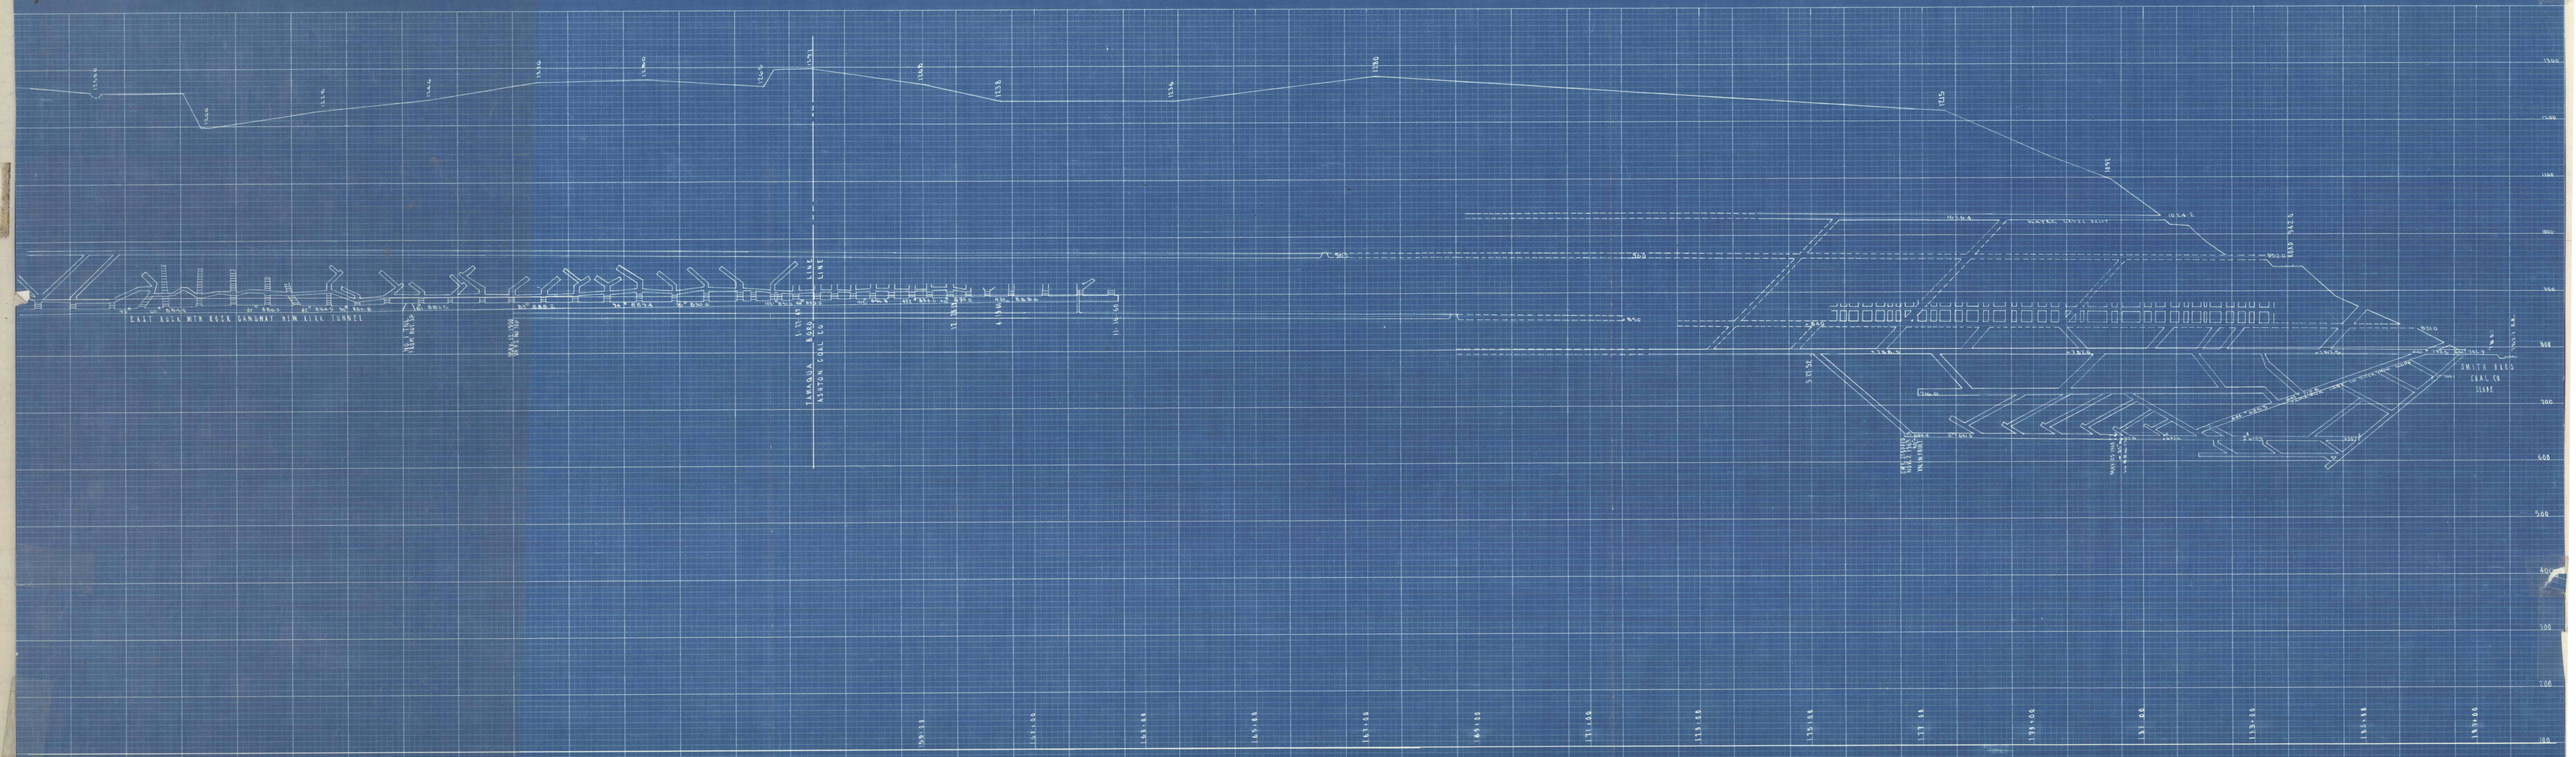
EAST BLOCK WITH BLOCK GANGWAY NEW LINE TUNNEL
TARAGUA & ALSTON COAL CO
LINE
LINE
WATER LEVEL RIGHT
SMITH BROS COAL CO SLOPE