
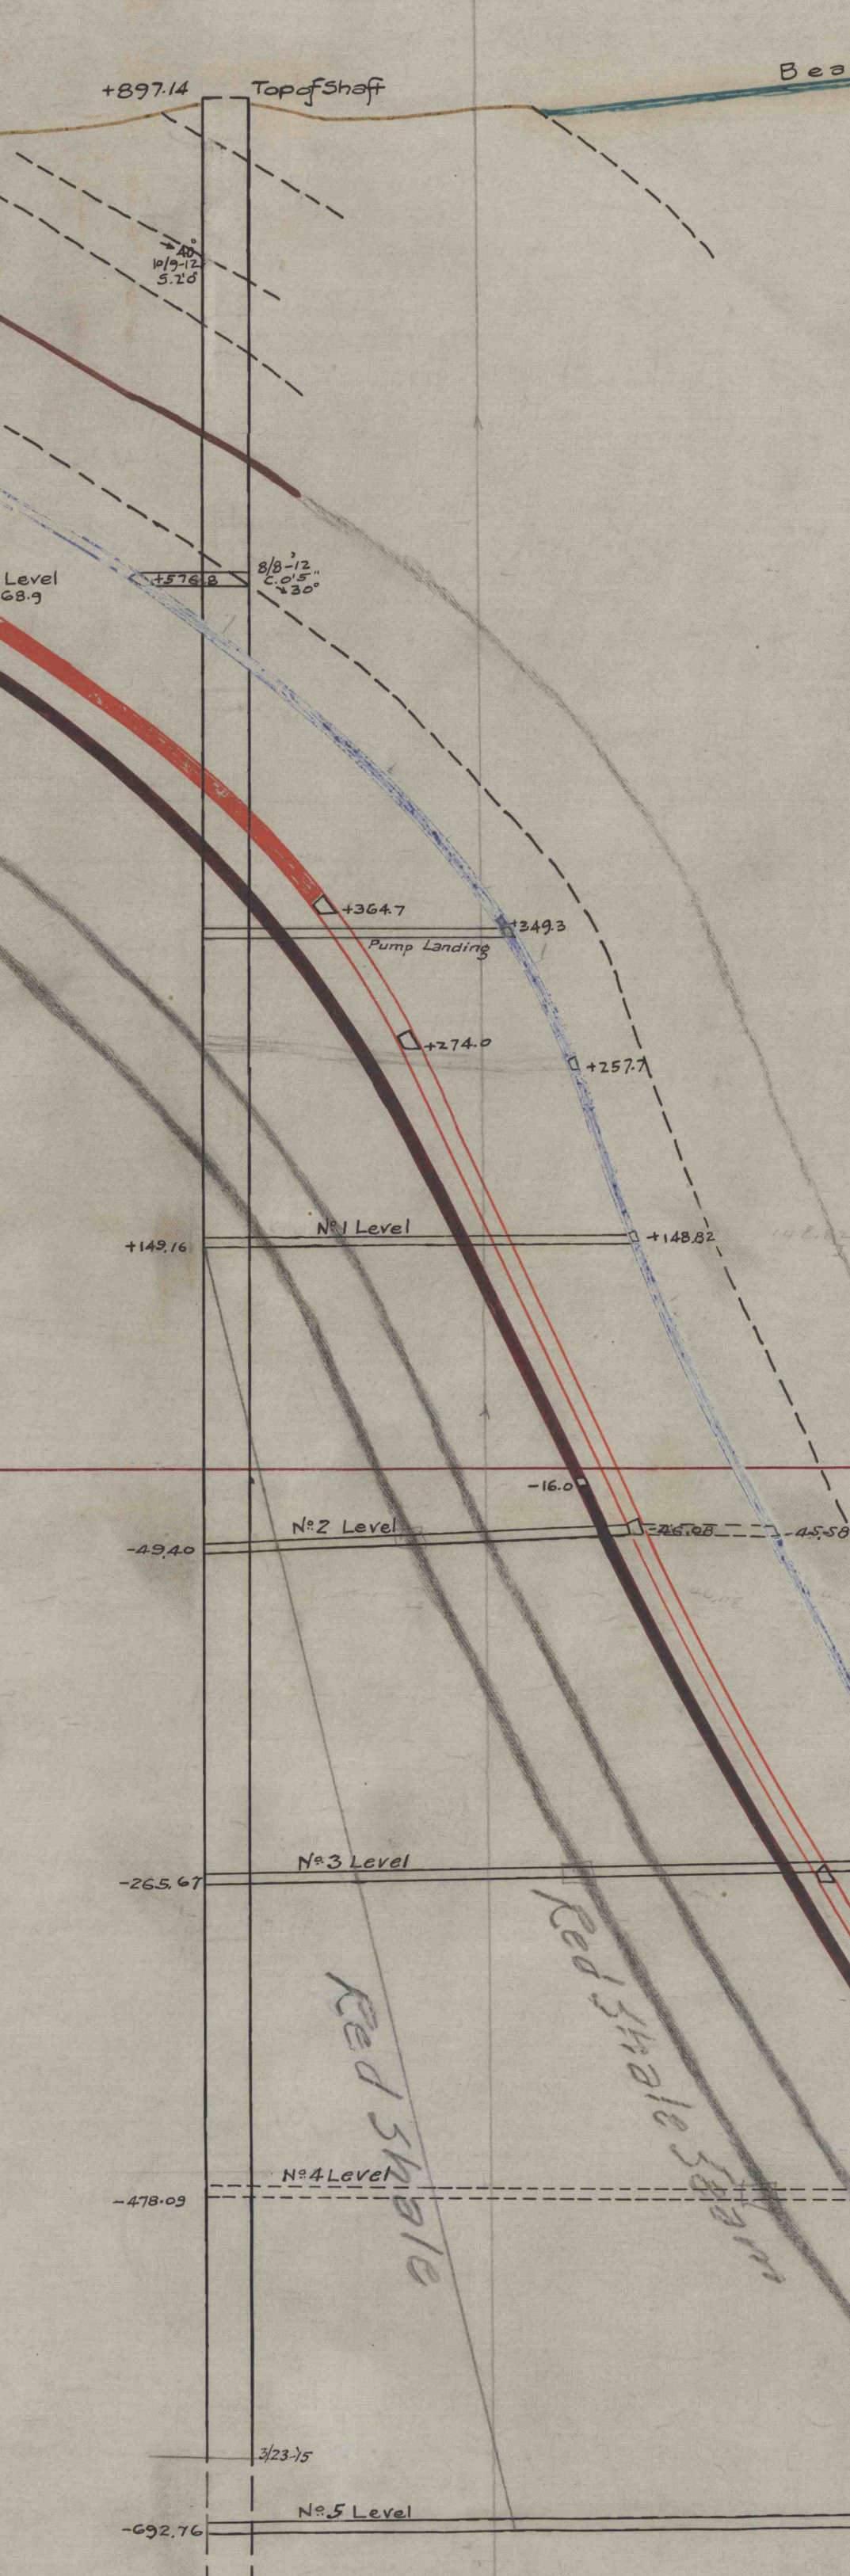


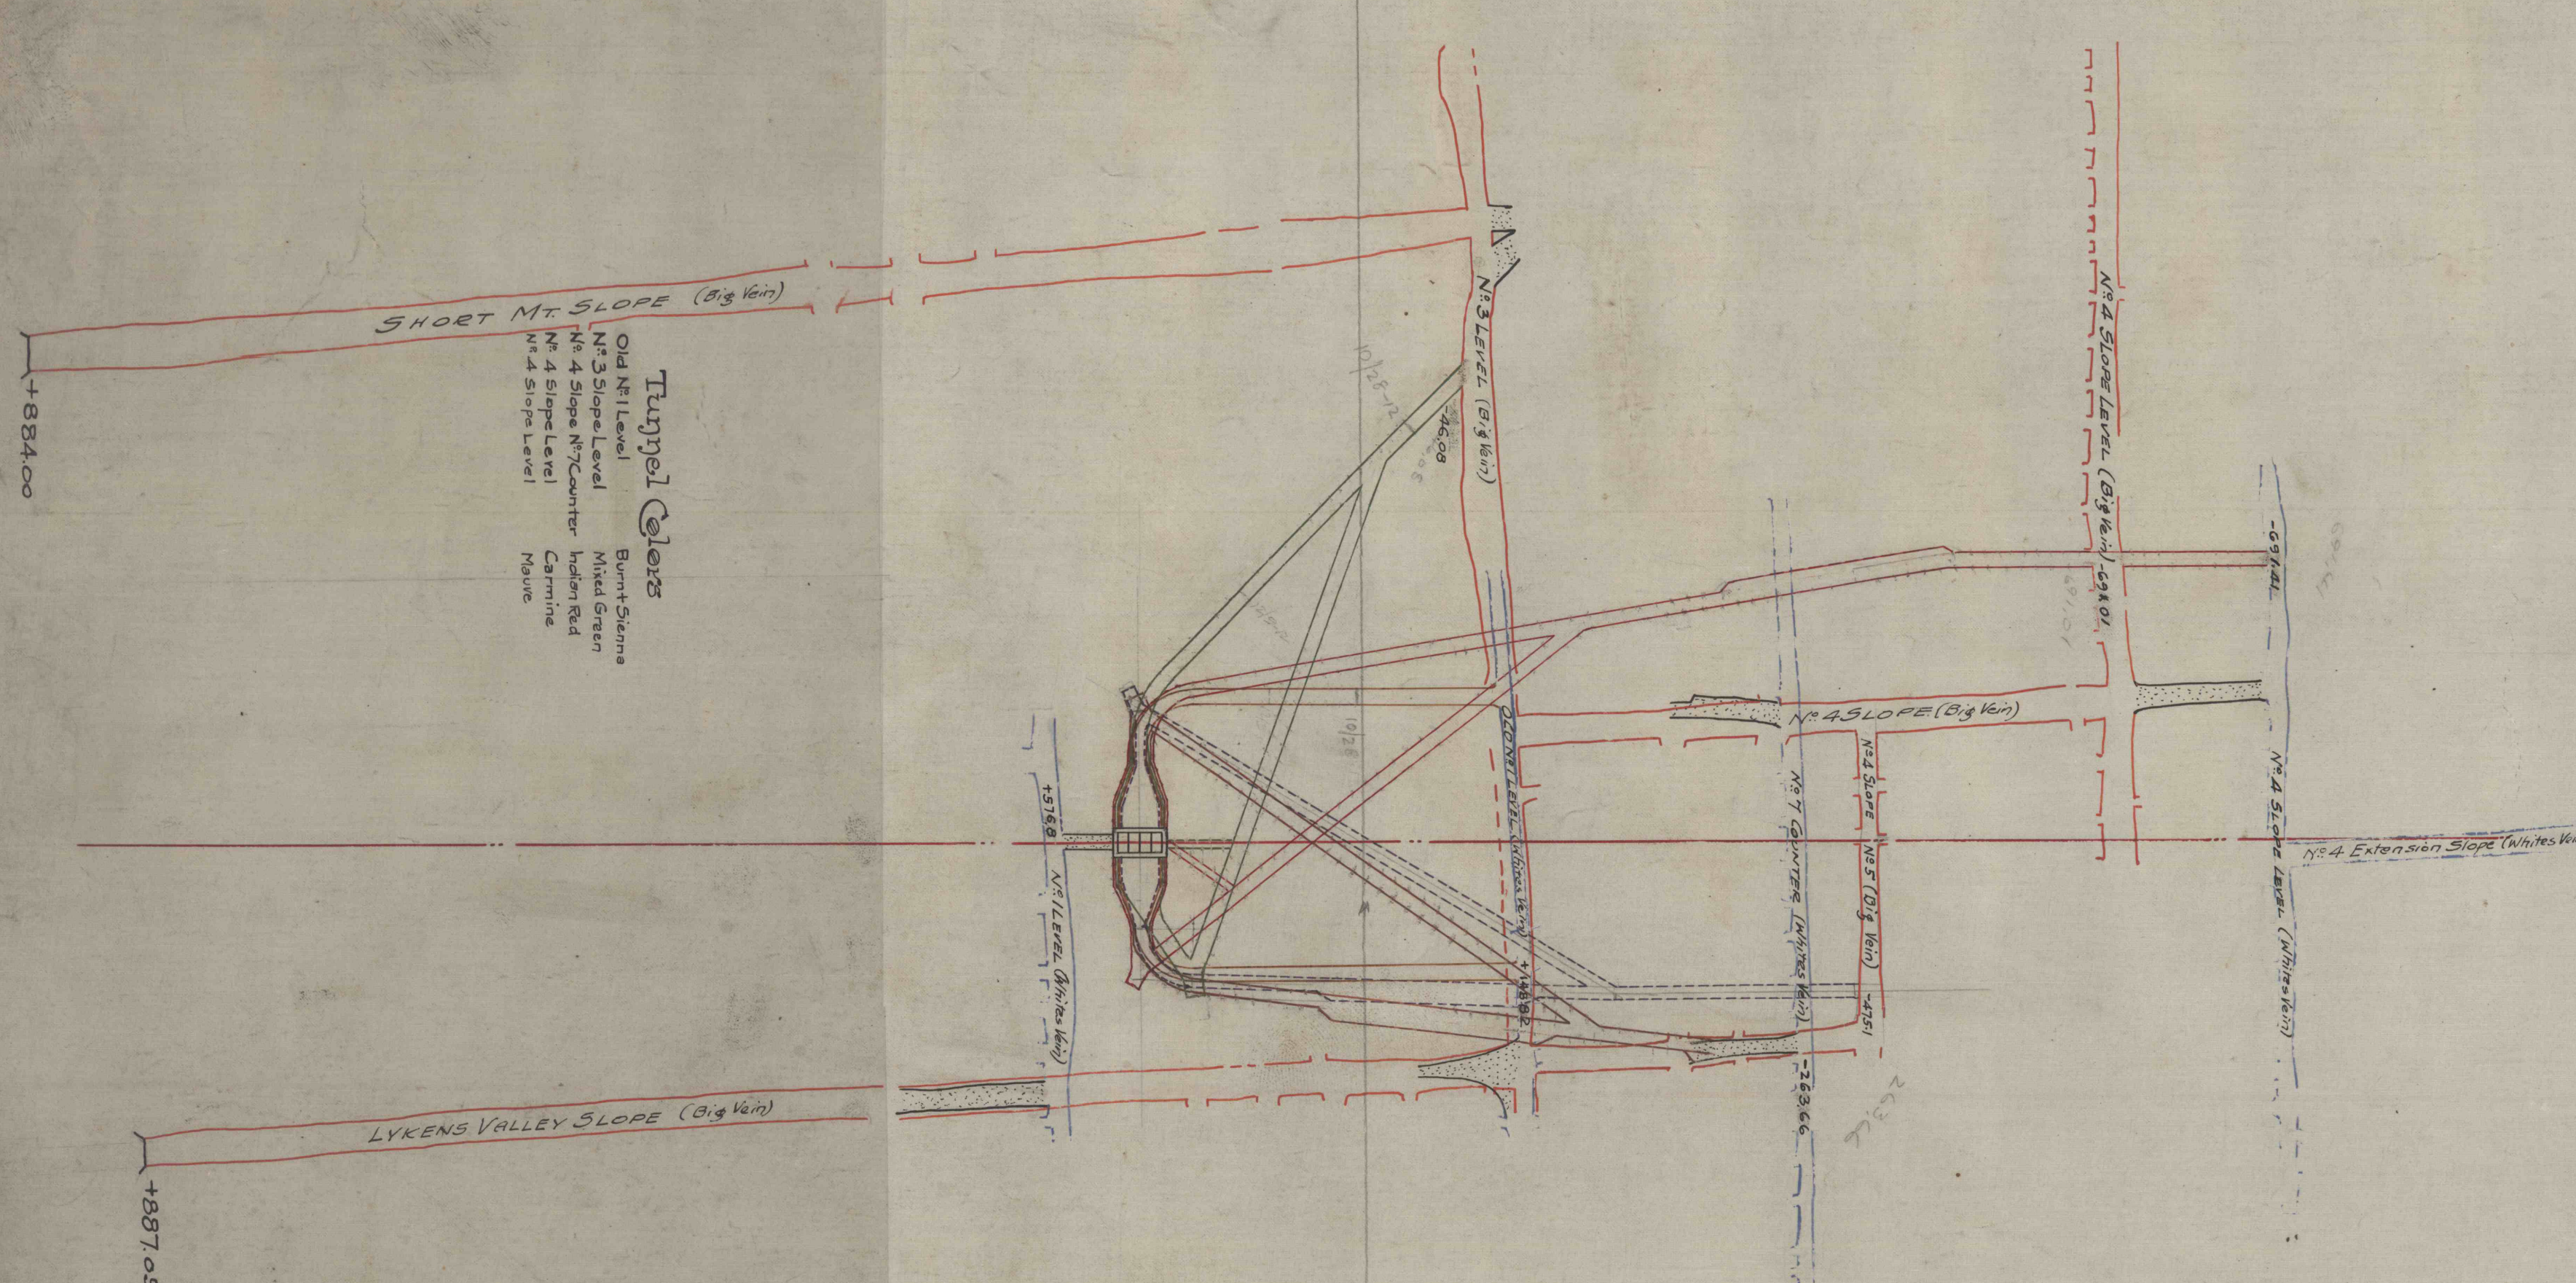

Section Colors

Purple Lake	Little Ven
Vermilion	Big
New Blue	White
Indian Red	MS
Mixed Green	White Am
Green	Not Named
Burnt Sienna	
Black	
Dark	Unknown Veins

Profile of Red Ash & White Ash Measures on line of N^o 1 Shaft and Plan of Tunnels to Shaft — Short Mountain Colliery. Lykens, Pa. Scale 1 in. = 100 ft. Oct 10, 1912.