
SECTION No 28
SCALE 1"=100'

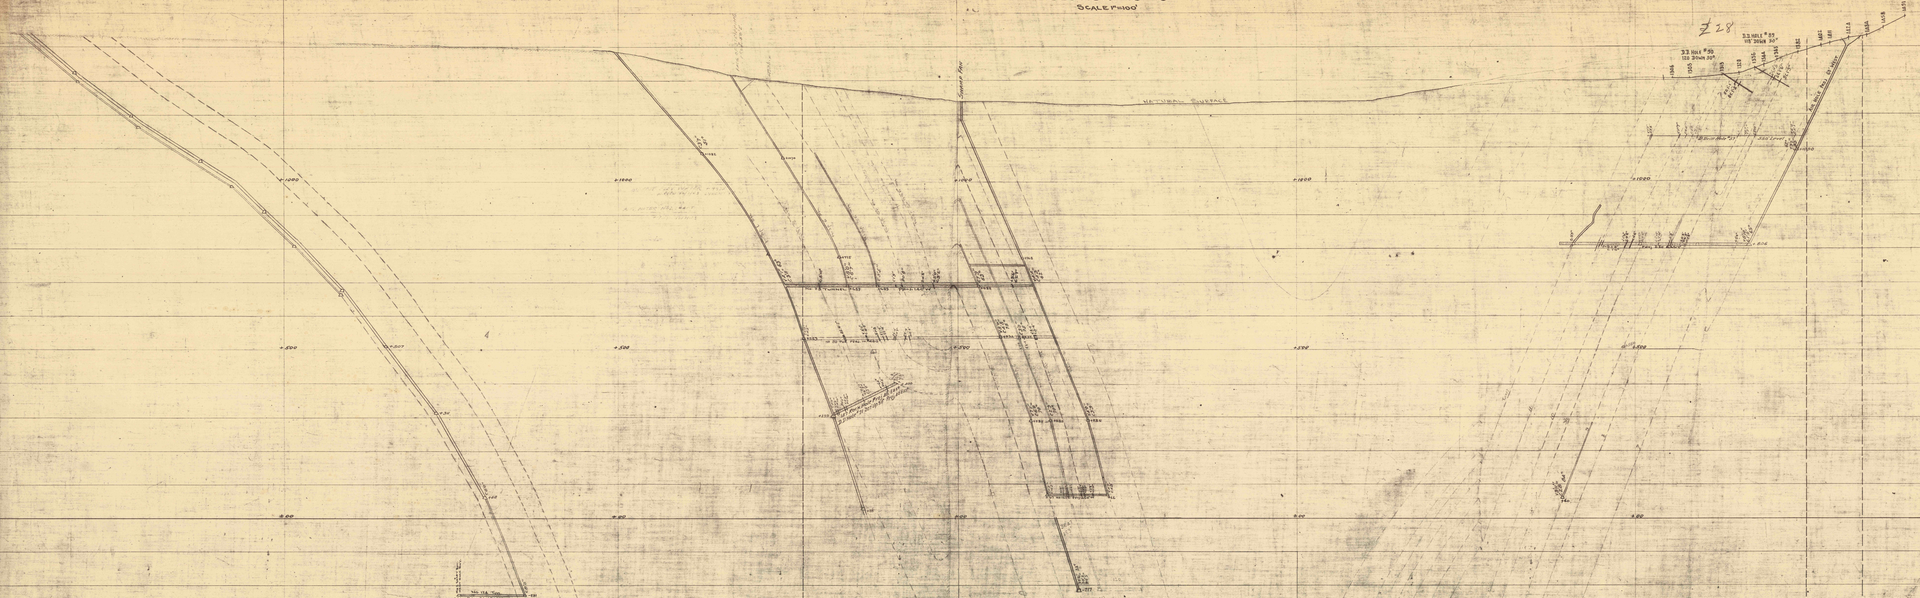

..SOUTHERN FIELD..

SHORT Mtn., COLLIERY

*X^s SECTION No: 28·1"=100' WICONISCO TWP.

DAUPHIN COUNTY PA., 17. LYKENS VALLEY DIST.

SUSQUEHANNA Collieries.

28