


DIAMOND DRILL TEST HOLES SHORT MOUNTAIN COLLIERY


Scale 100' = 1"

November 95

HOLES LYKENS VALLEY VEIN & WHITES VEIN

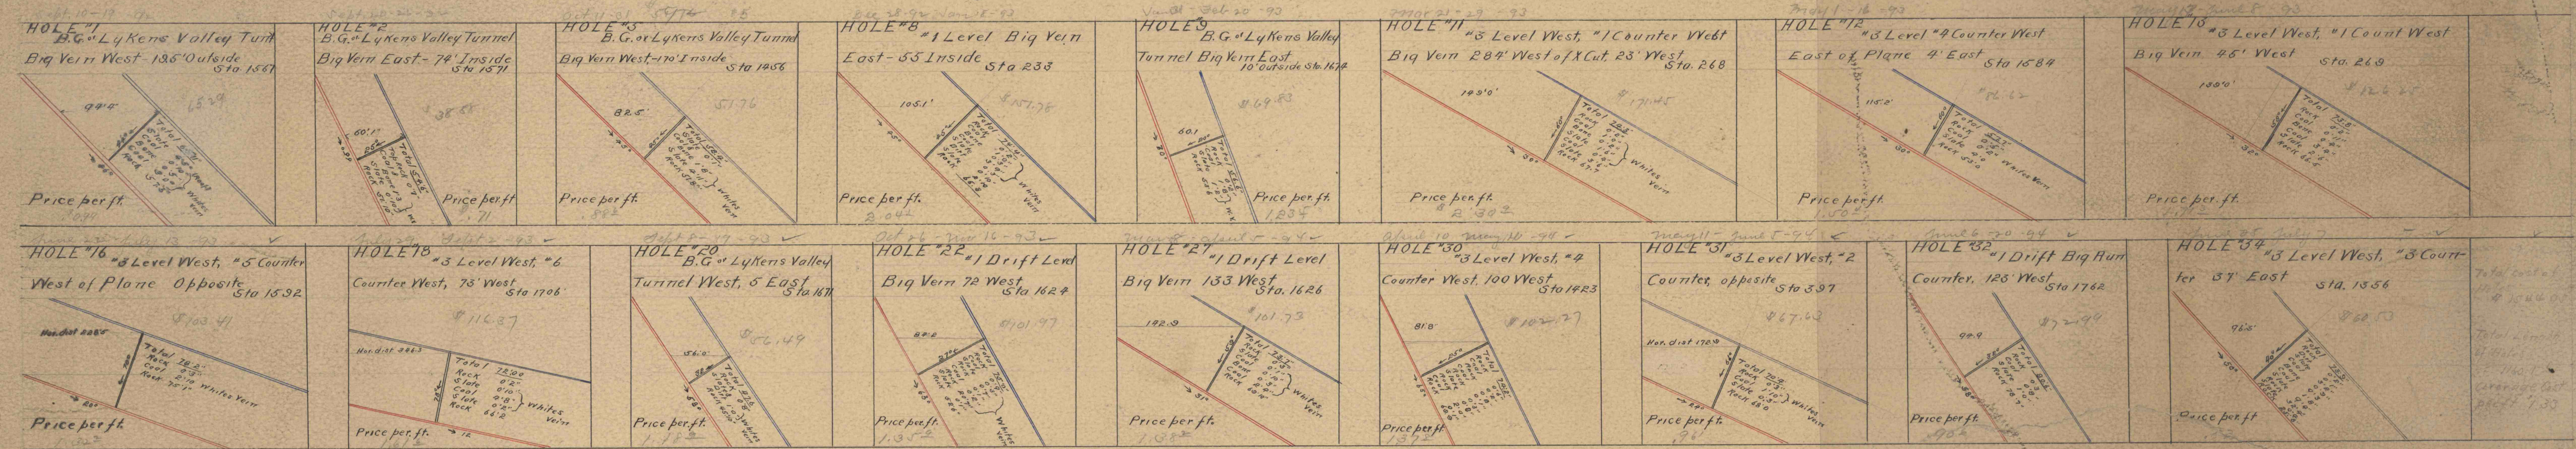

HOLES LYKENS VALLEY VEIN & LITTLE VEIN

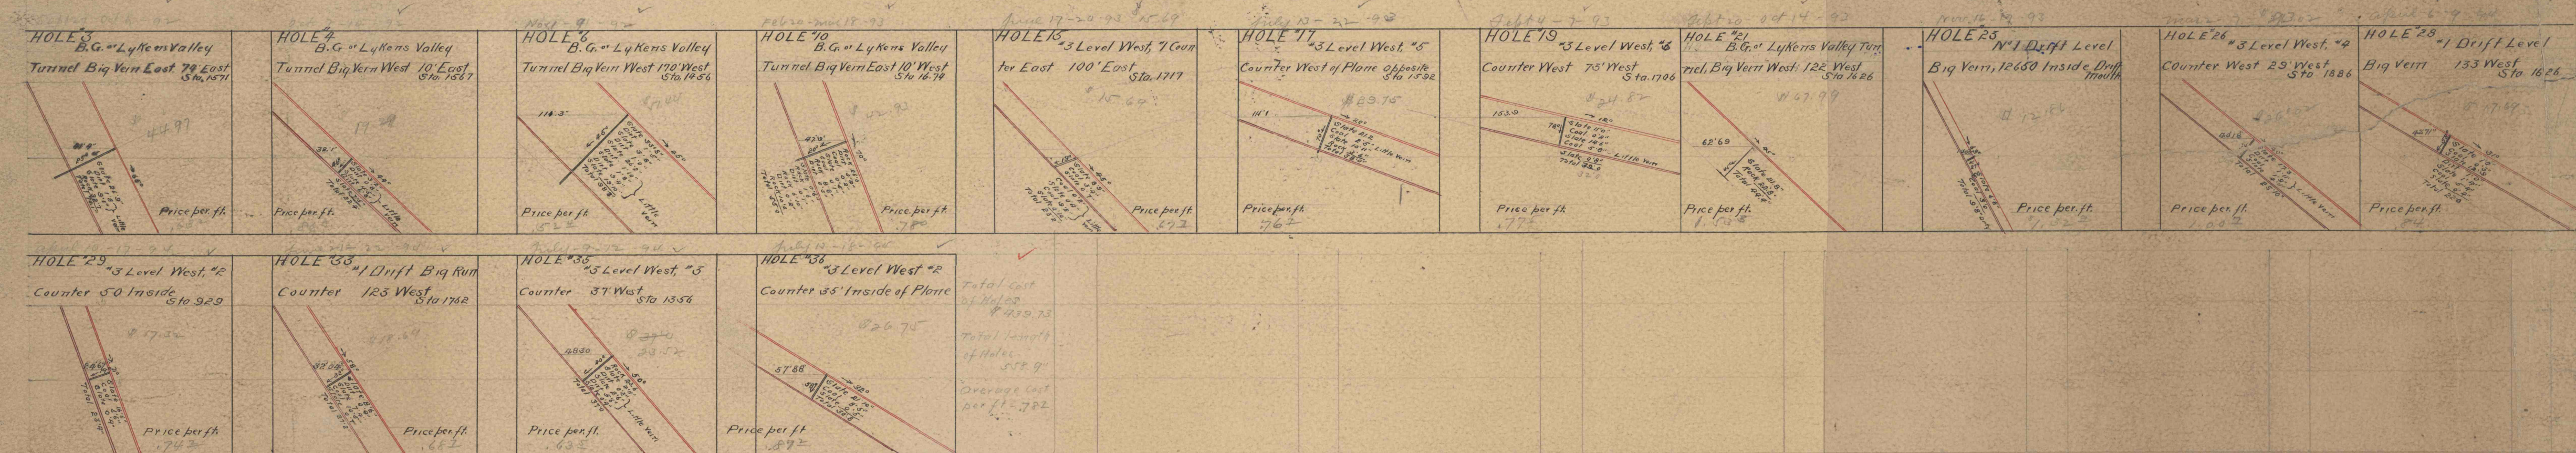

MISCELLANEOUS

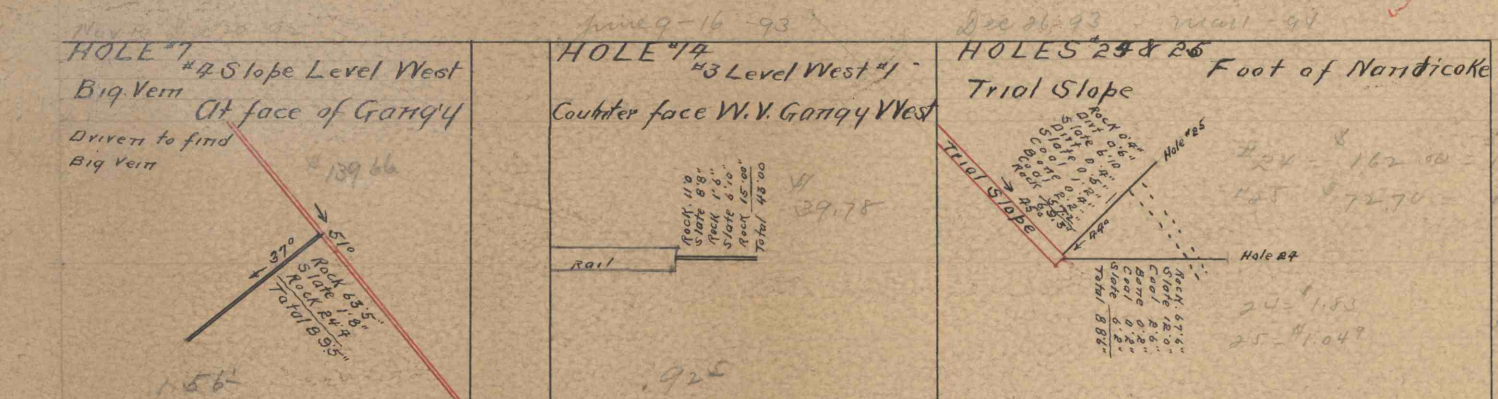


TABLE OF COST.

Holes where Driven	Total length of holes	Total Cost of Holes	Average Cost per foot
Big Vein to Whites Vein	1160' 1"	\$1544.95	\$1.33
Big Vein to Little Vein	558' 9"	\$439.73	78
Miscellaneous	290' 2"	\$14.14	1.42
Grand Total	2009' 0"	\$2398.82	1.19

"DUE TO CONDITION OF THIS PAPER...
NOTE: TOTAL COSTS OF HOLES figures converted to tracing, 28 AUG. 1975.
ALEX. D. DEEP MINE SAFETY.