


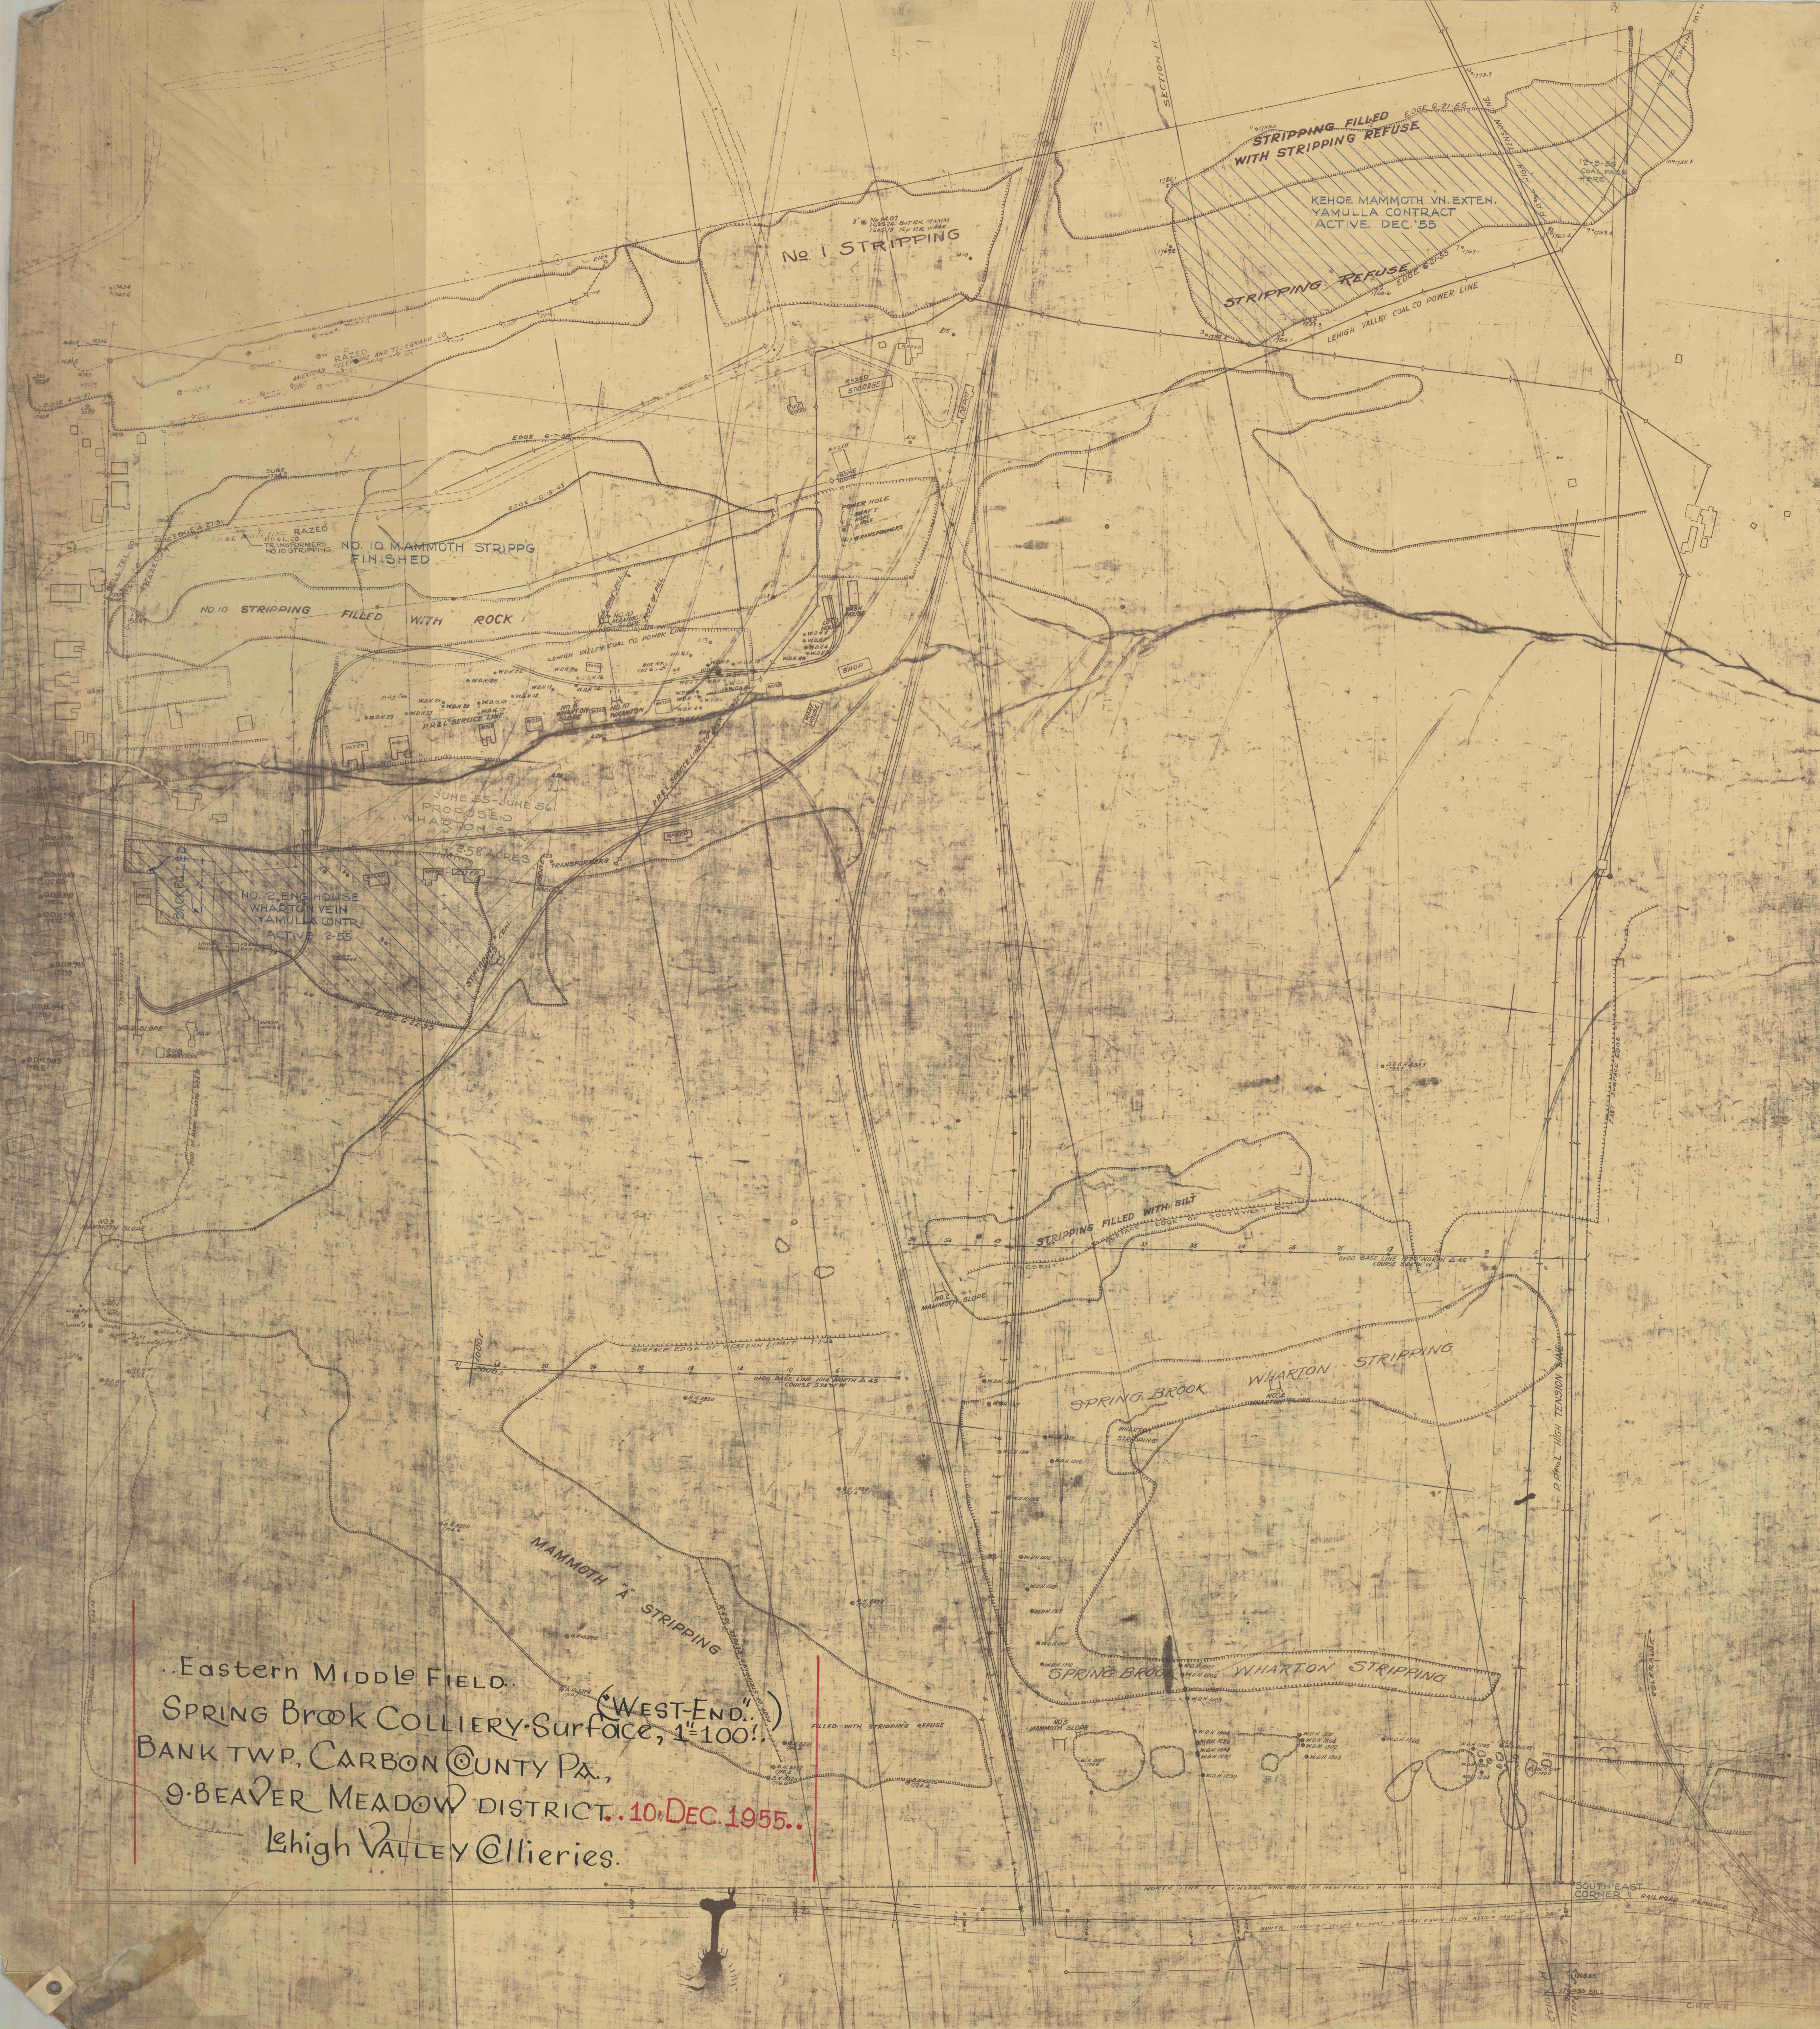

Eastern Middle Field.
(WEST-END.)
SPRING BROOK COLLIERY SURFACE, 1"=100!
BANK TWP, CARBON COUNTY PA.,
9-BE AVER MEADOW DISTRICT. 10 DEC 1955.
Lehigh Valley Collieries.