


STATE MINE INSPECTOR
SPRING BROOK GAMMA VEIN

C. J. MCDONALD CO.

No. 1 Slope

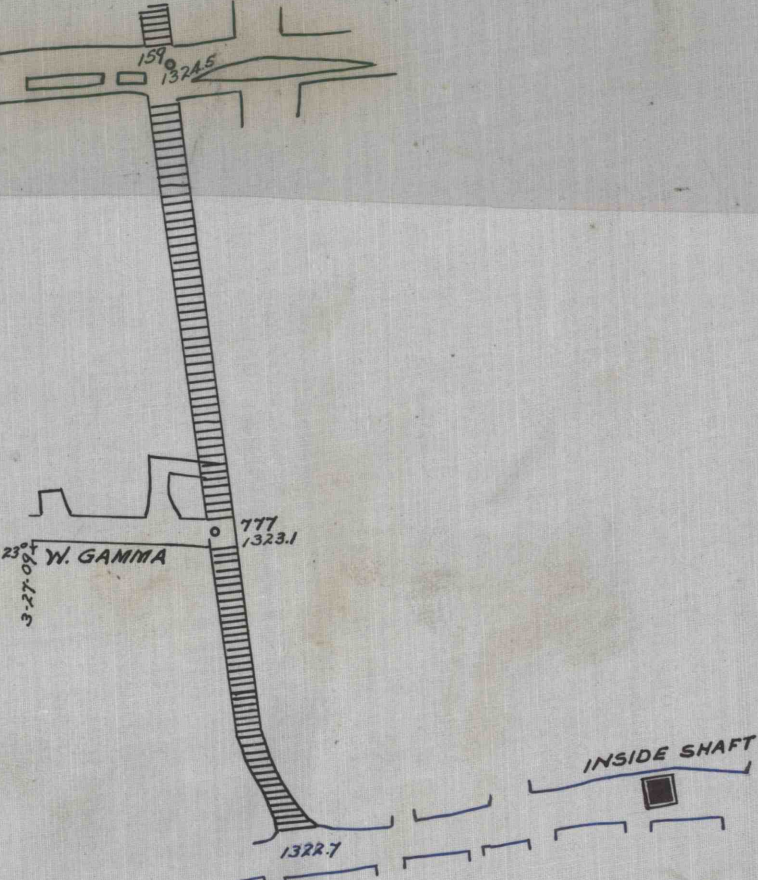

SPRING MOUNTAIN COLLIERY

LEHIGH VALLEY
COAL CO.

No. 2 Slope



LEHIGH VALLEY
COAL CO.

LEHIGH VALLEY
COAL CO.

Eastern Middle Field

Spring Brook Gamma Vein BANK TWSP.,
COLLIERY.. CARBON COUNTY PA.,
Scale: 1 inch = 100 feet LEHIGH VALLEY CO. L.L.R.S.
9-BEAVER MEADOW DISTRICT

REVISED TO AUG. 1925

JULY - 1937

NOT WORKED

MARCH 1942

MARCH 1944

APRIL 1945

OCTOBER 1948

REVISED TO

APRIL 1946

OCT 1946

APRIL 1946

JANUARY 1948

OCTOBER 1948