


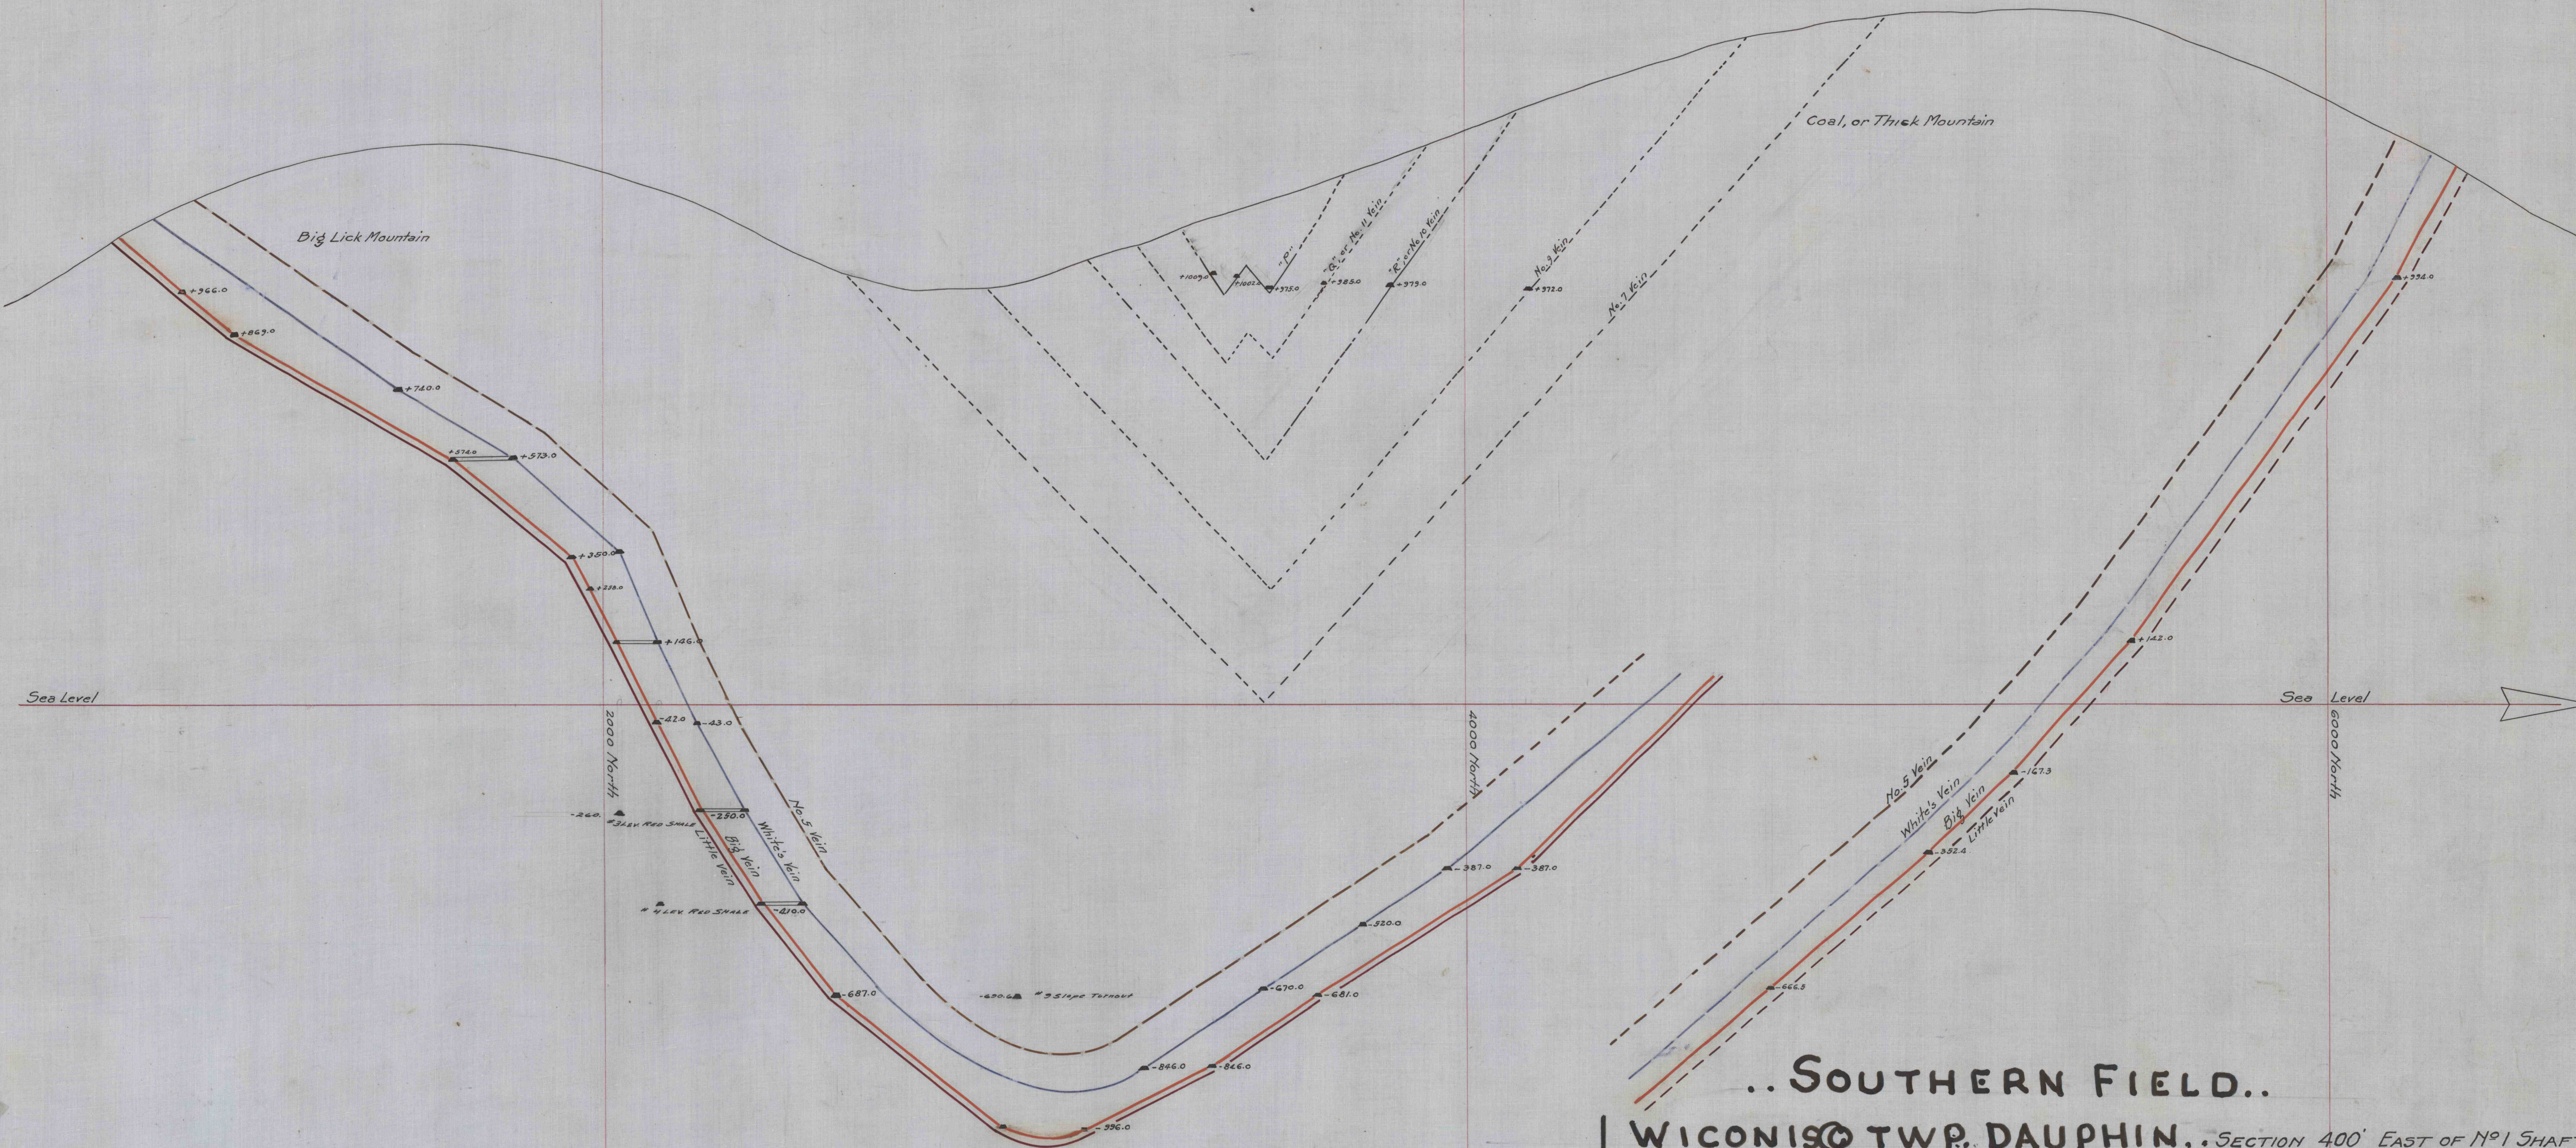

.. SOUTHERN FIELD..

WICONIS TWP. DAUPHIN.. SECTION 400' EAST OF N^o 1 SHAFT.

.. SHORT MOUNTAIN COLLIERY ..

COUNTY. 17-LYKENS DISTRICT-SUSQUEHANNA COLLIERIES CO. LYKENS, PA.

SCALE 1"=200' 4/22/26 • John A. Butz DIKENGAR