


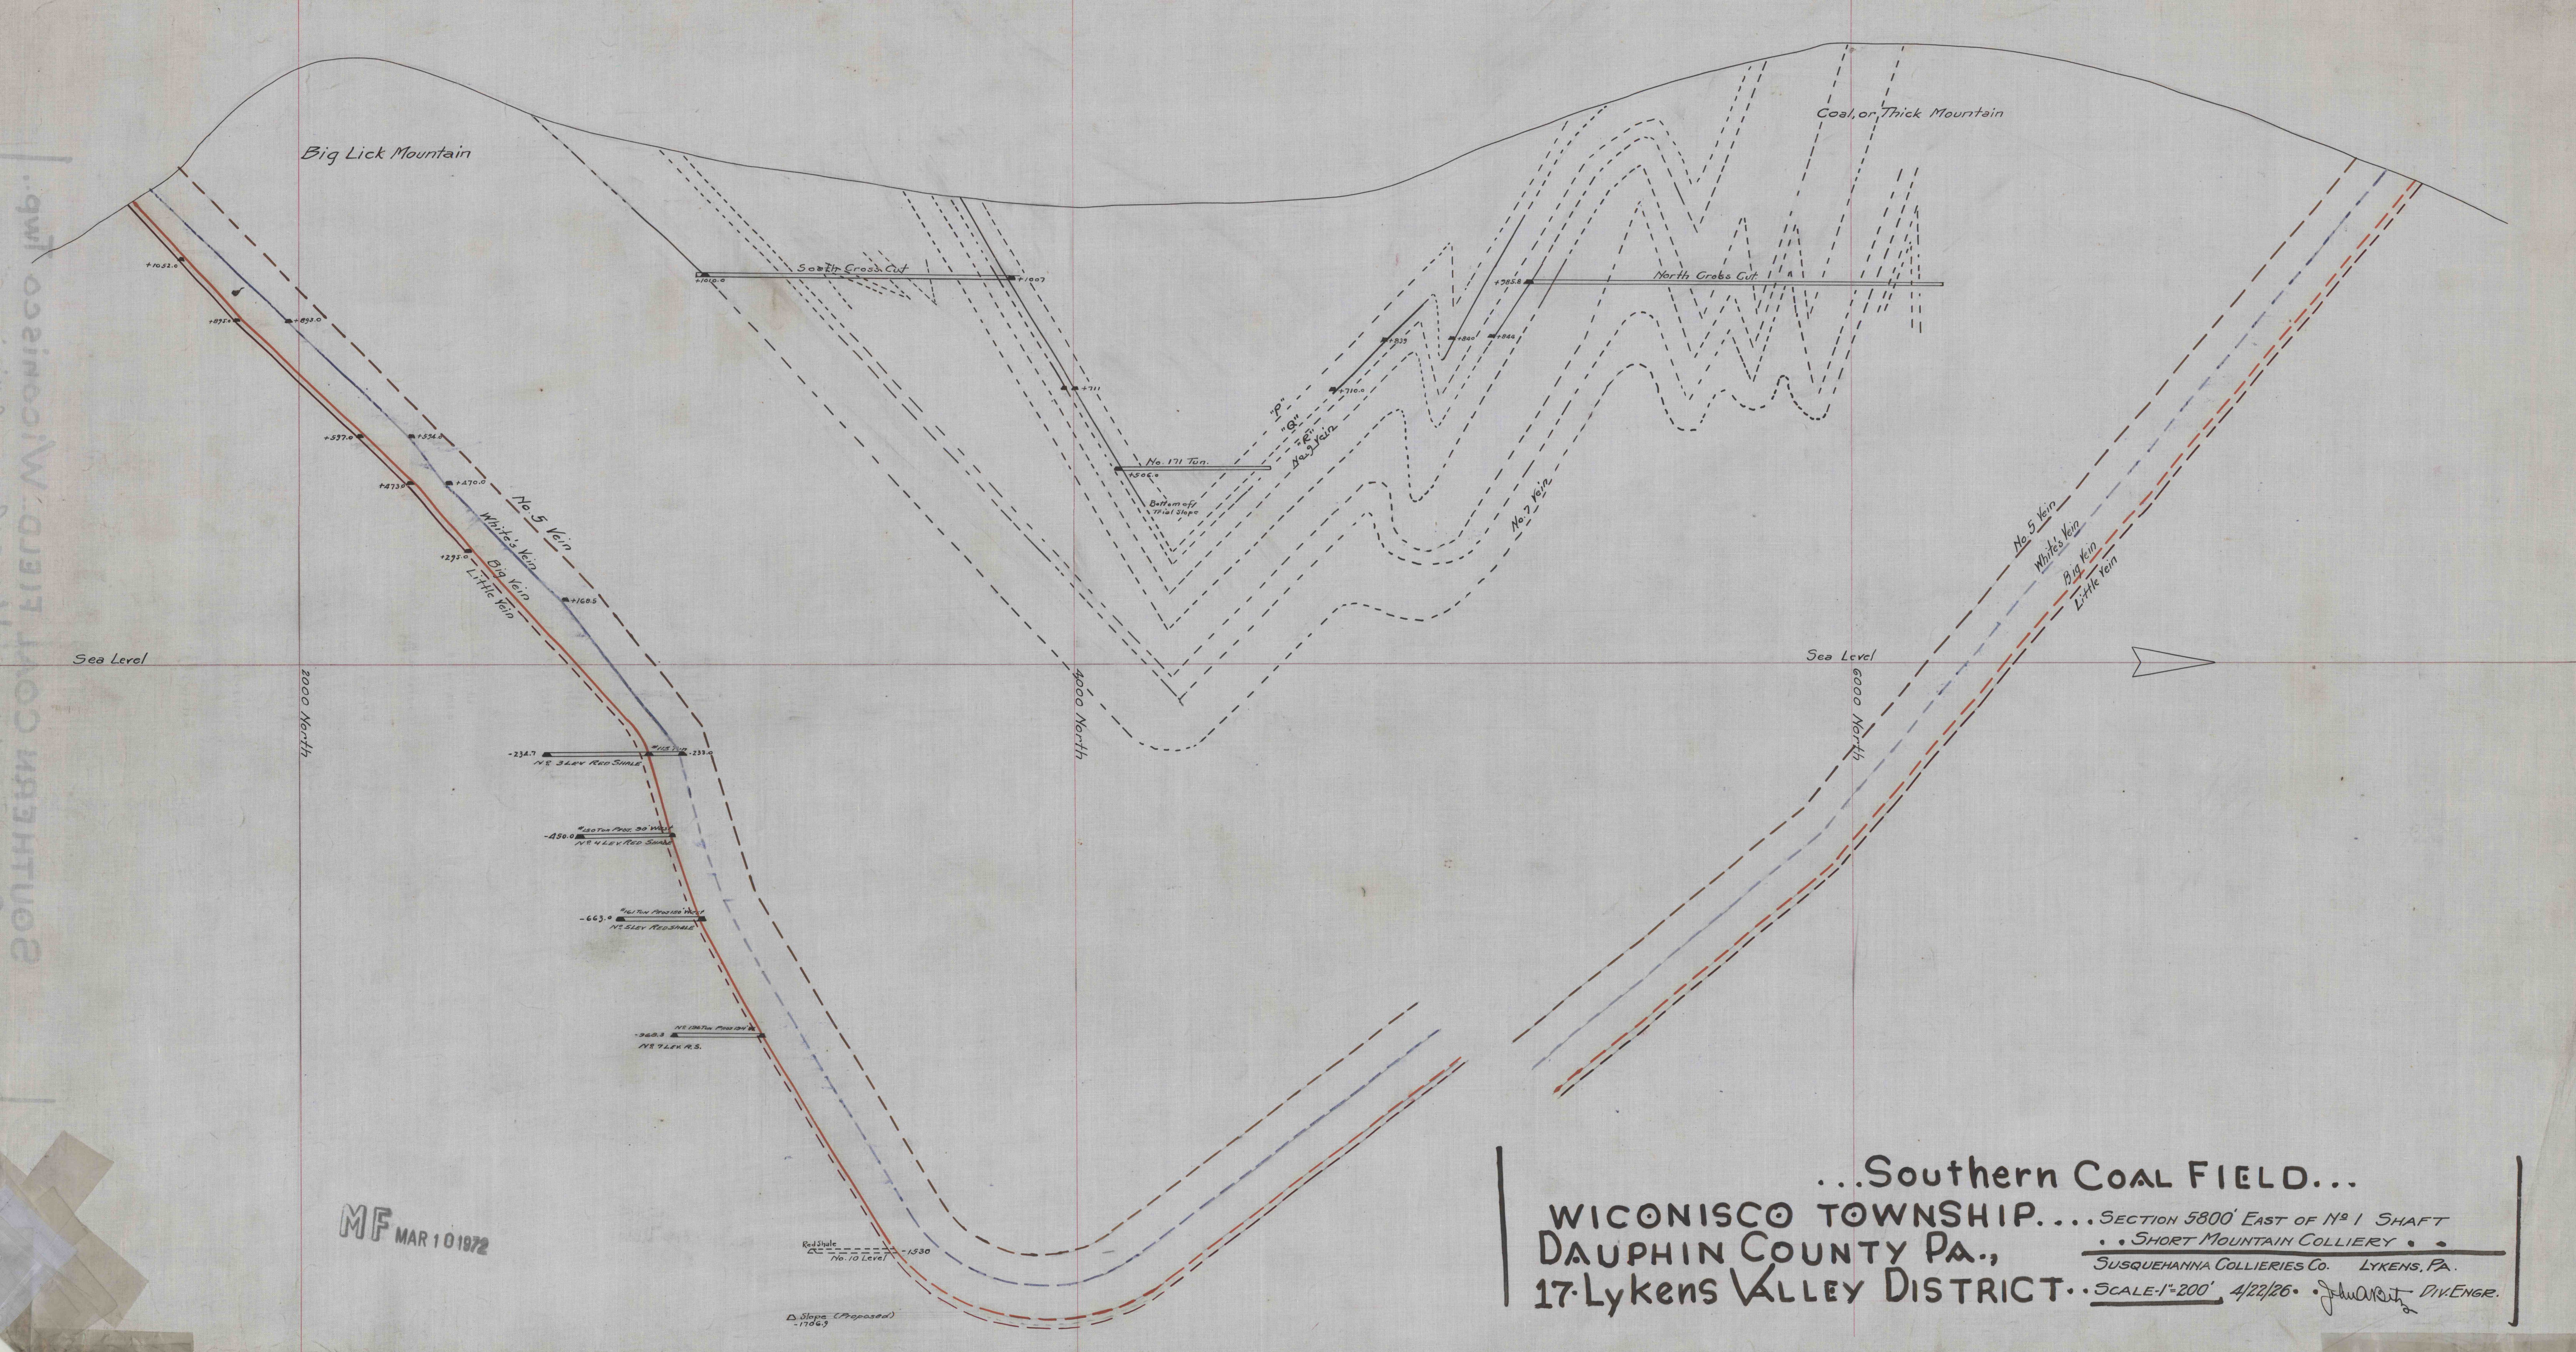

MF MAR 10 1972

...Southern Coal Field...
WICONISCO TOWNSHIP.... SECTION 5800' East of No 1 Shaft
DAUPHIN COUNTY PA., .. SHORT MOUNTAIN COLLIERIES ..
17-Lykens VALLEY DISTRICT.. SUSQUEHANNA COLLIERIES CO. LYKENS, PA.
SCALE-1"=200' 4/22/26 • J. H. [Signature] DIV ENGR.