


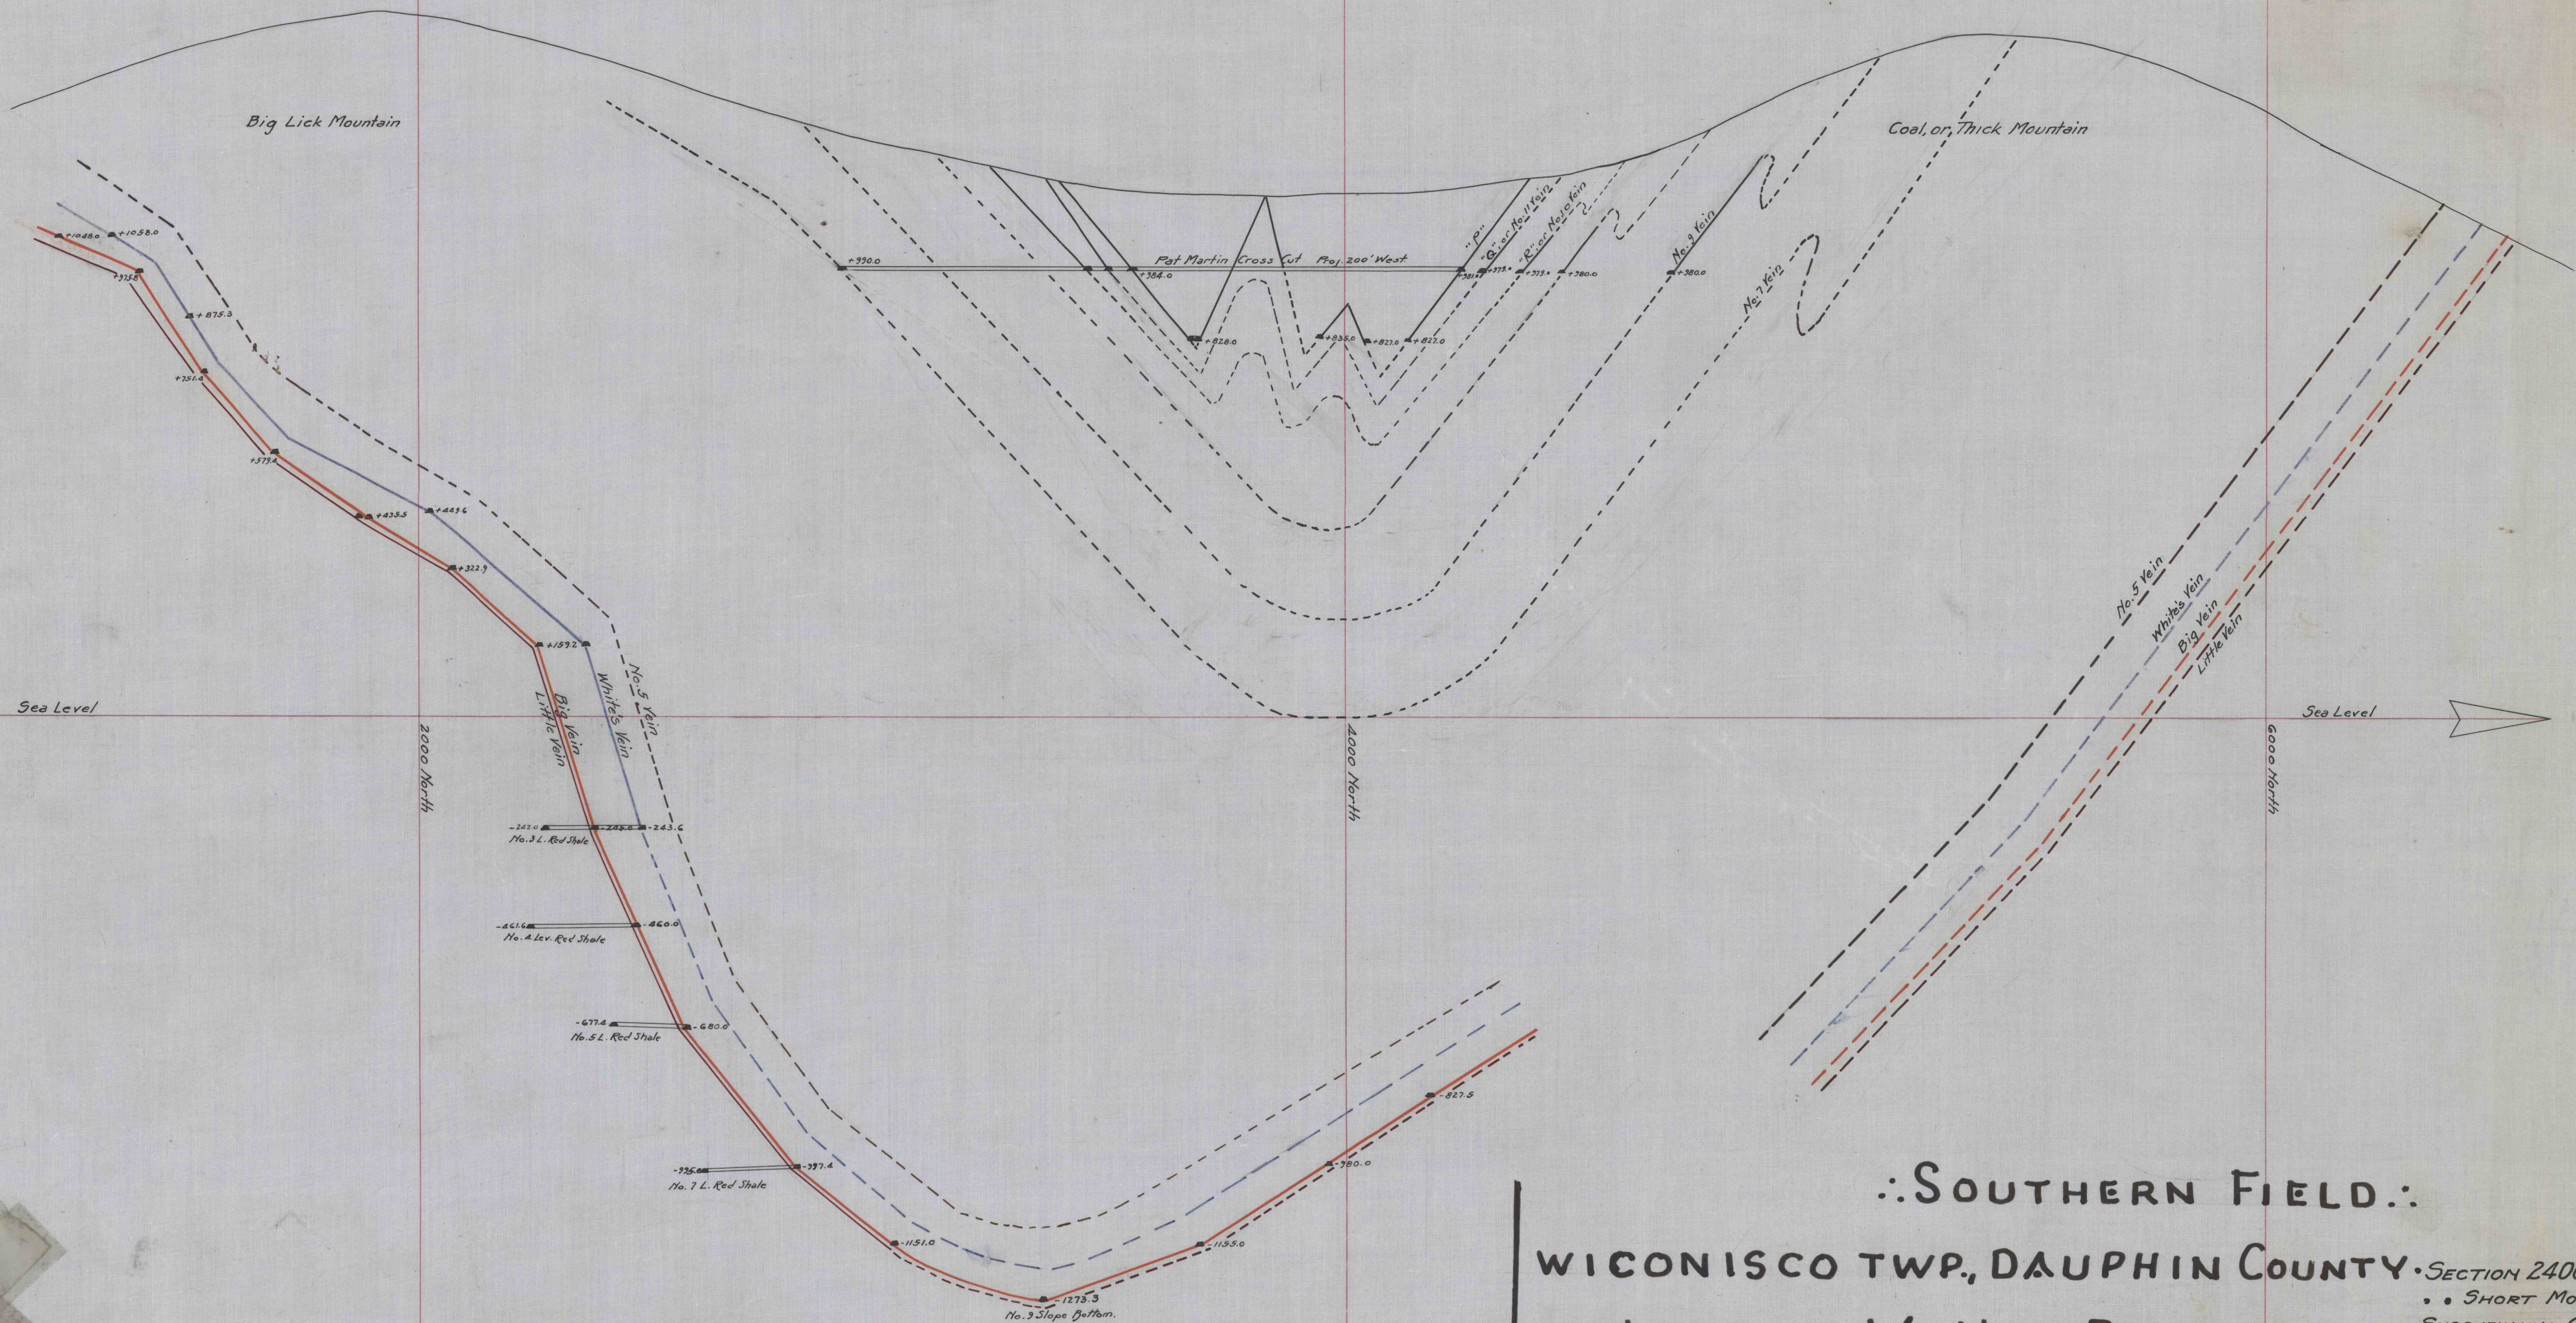

:: SOUTHERN FIELD ::
 WICONISCO TWP., DAUPHIN COUNTY • SECTION 2400' EAST OF N^o 1 SHAFT •
 17. LYKENS Valley District.

• • SHORT MOUNTAIN COLLIERY • •
 SUSQUEHANNA COLLIERIES CO. LYKENS, PA.
