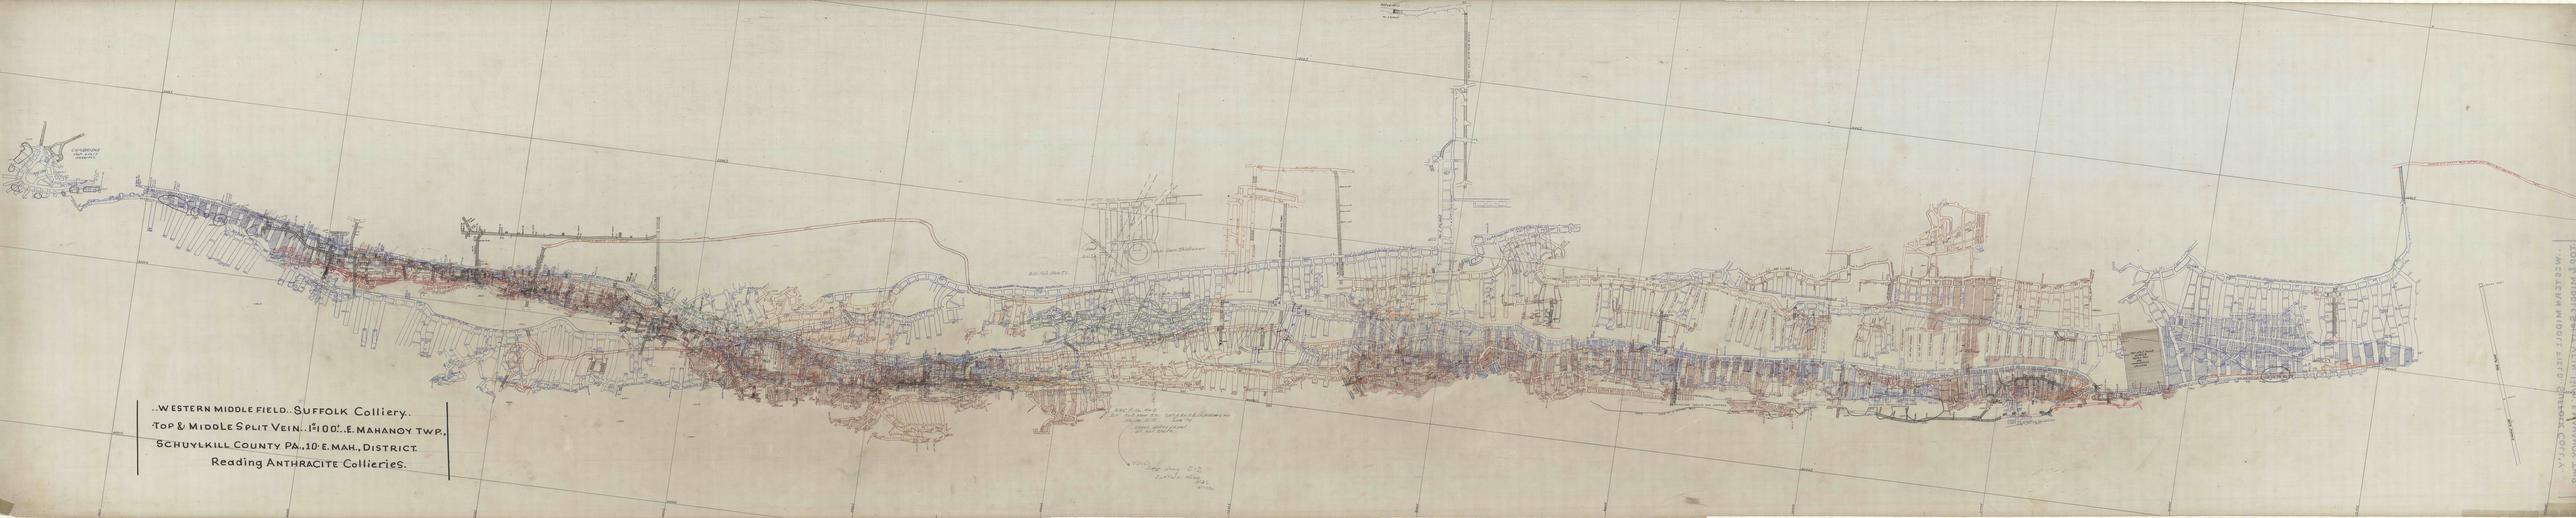
..WESTERN MIDDLE FIELD..SUFFOLK Colliery..
TOP & MIDDLE SPLIT VEIN..1"=100'..E. MAHANOY TWP.,
SCHUYLKILL COUNTY PA..10 E. MAH., DISTRICT.
Reading ANTHRACITE Collieries.