


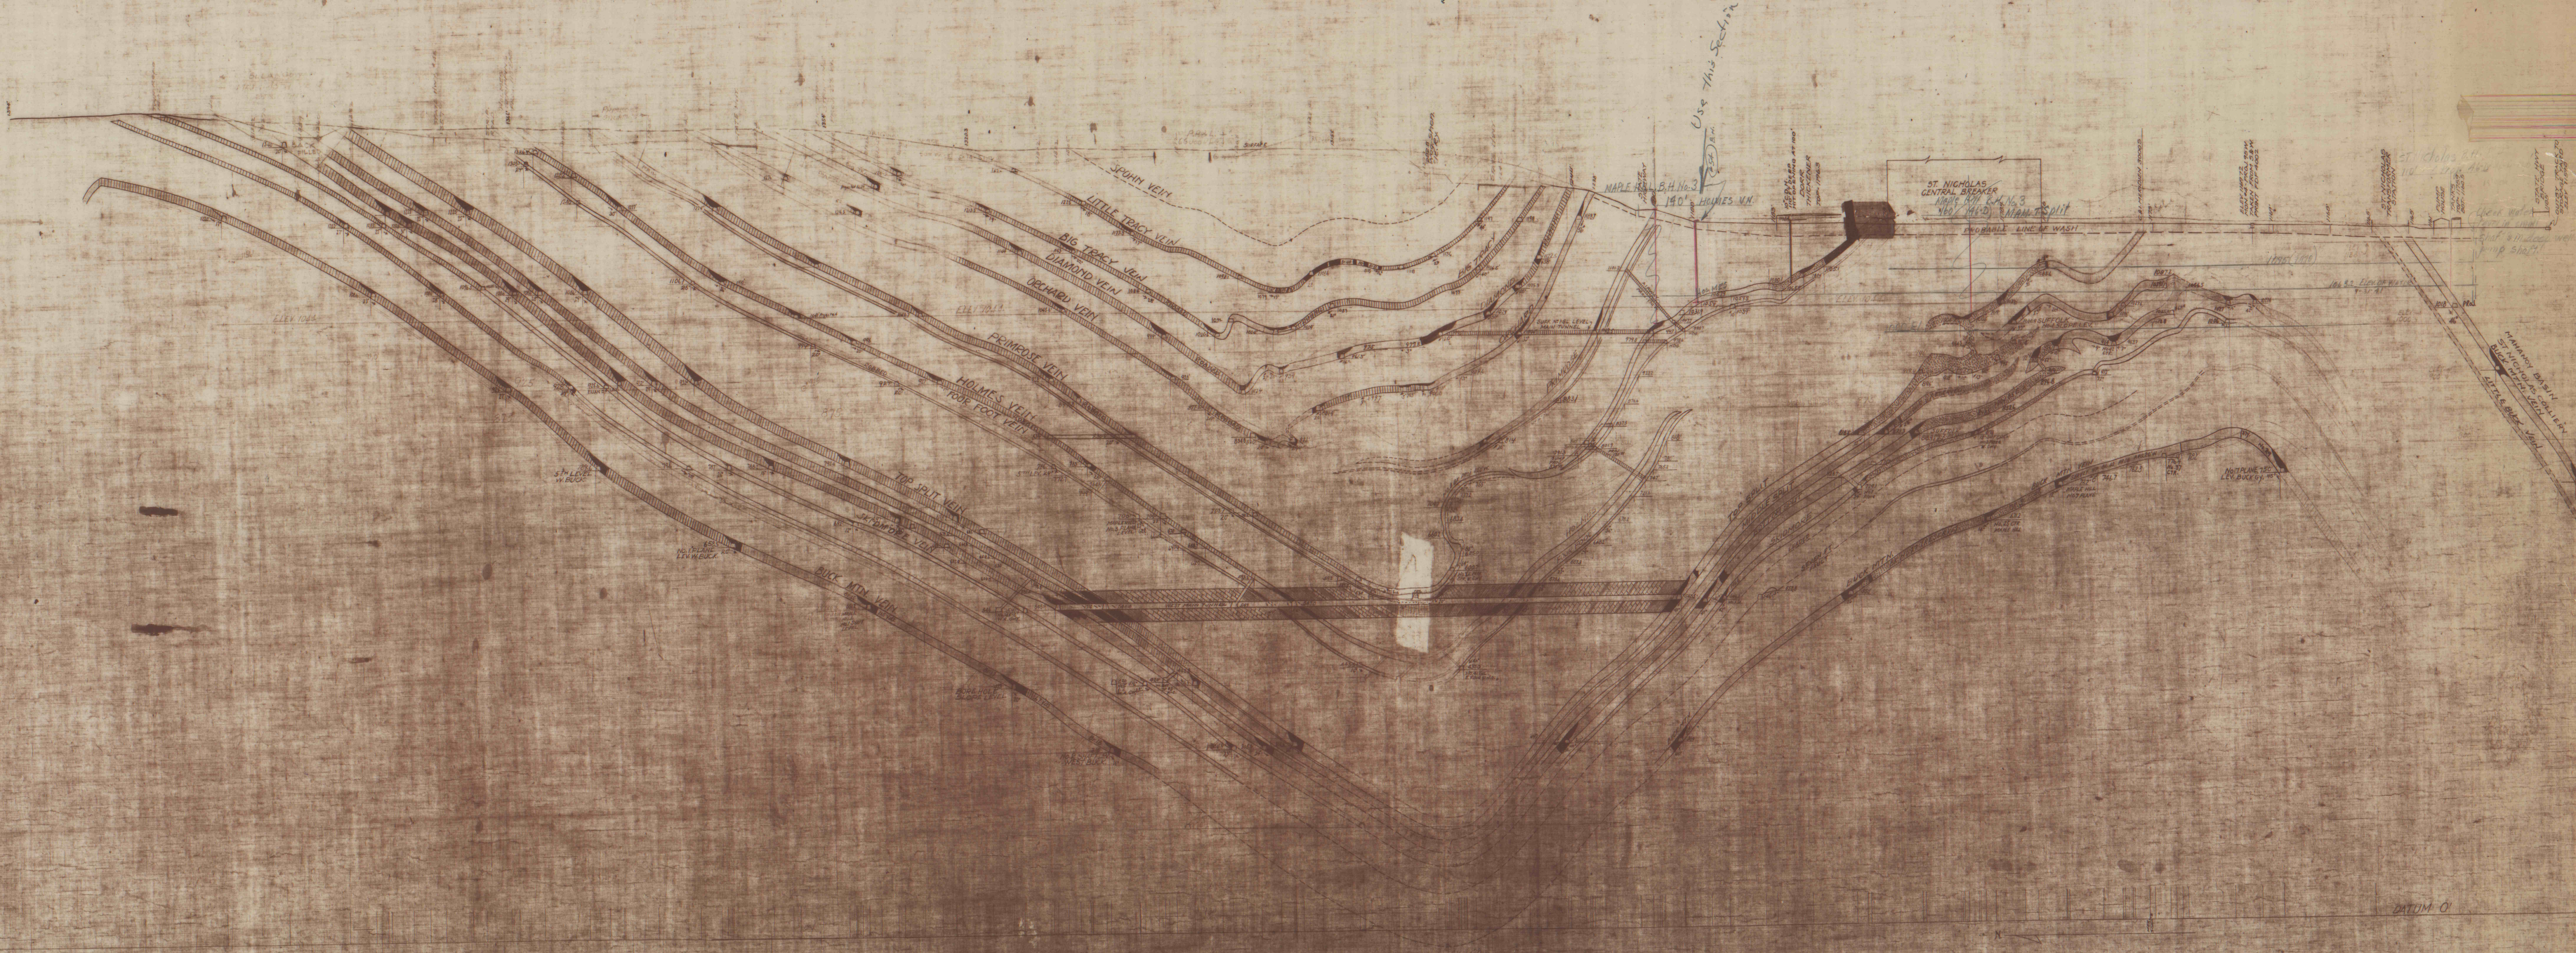

WESTERN Middle Field . . . MAPLE HILL COLLIERY.
E. MAHANOY TWP, Schuylkill County, PA. "X" SECTION No. 6. 1"=100'.
10. E. MAH, District. READING ANTHRACITE Collieries.