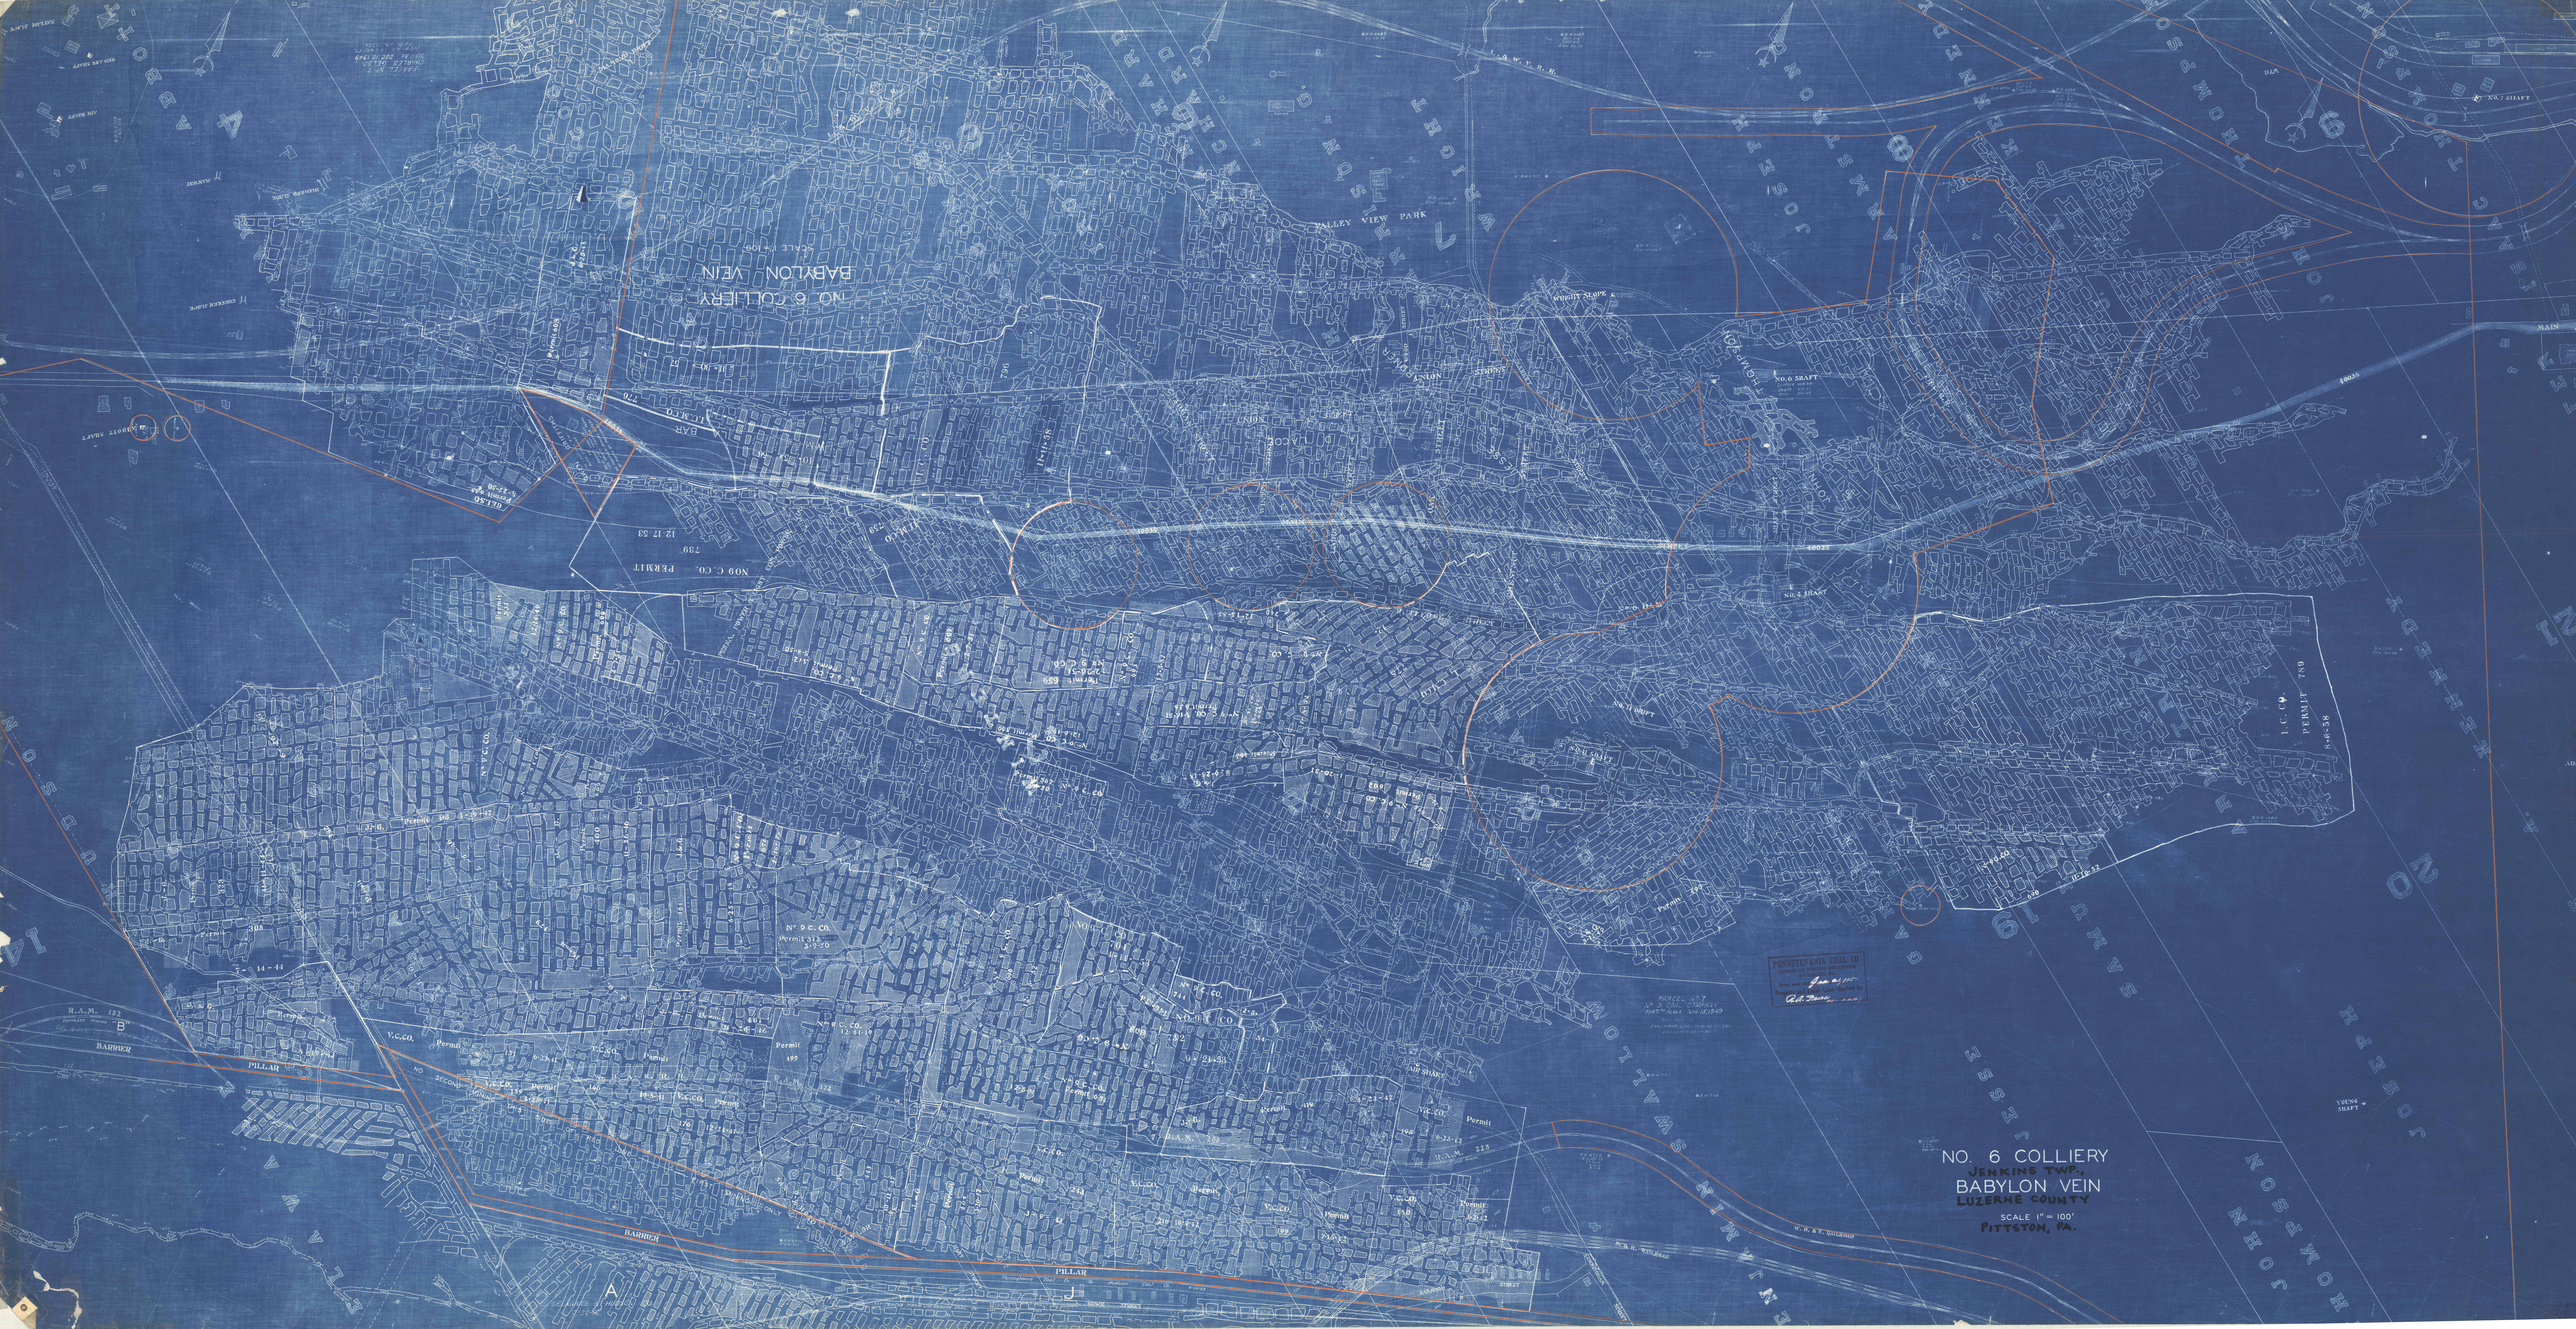

NO. 6 COLLIERY
JENKINS TWP.,
BABYLON VEIN
LUZERNE COUNTY
SCALE 1" = 100'
PITTSTON, PA.
BABYLON VEIN
NO. 6 COLLIERY
SCALE 1"=100'
NO. 6 SHAFT
NO. 5 SHAFT
NO. 7 SHAFT
AIR SHAFT
NO. 9 C. CO. PERMIT
I. C. CO. PERMIT 789
PENNSYLVANIA COAL CO.
BARRIER
PILLAR
MAIN
VALLEY VIEW PARK