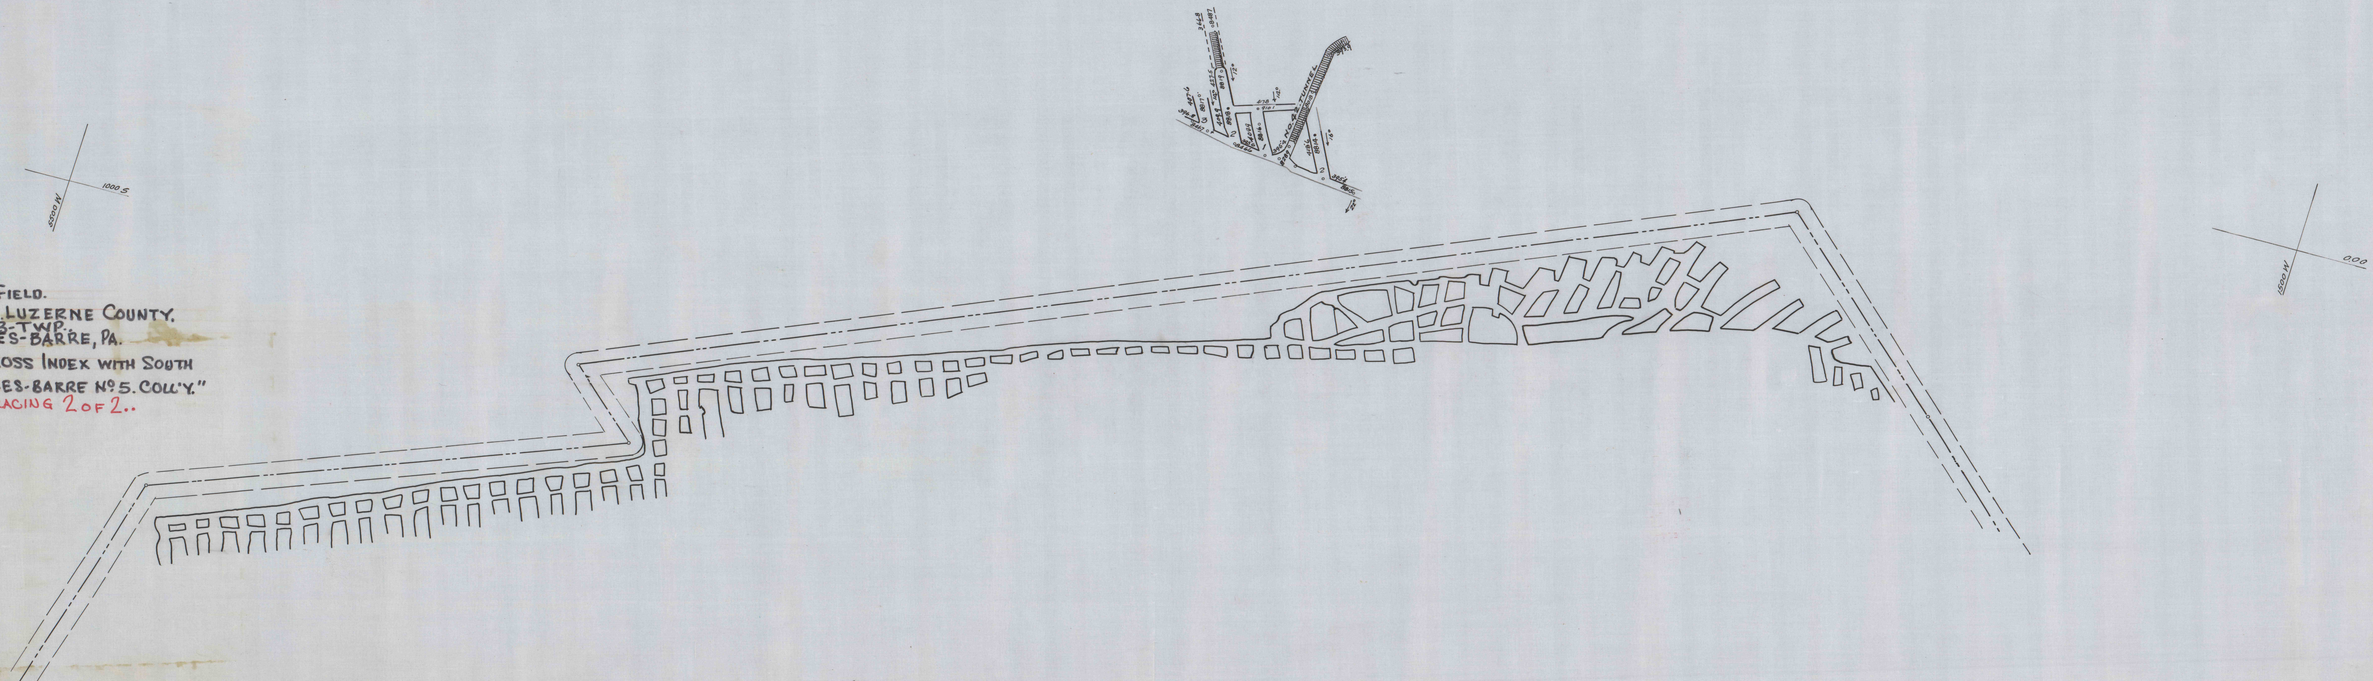

NORTHERN COAL FIELD.
STANTON No 7 LUZERNE COUNTY.
COLLIERY...W-B-TWP.
•NO. 1 VEIN...WILKES-BARRE, PA.

MADE APRIL-19-1945.
EXTENDED APRIL-21-1947.
" March-18-1948.

"...CROSS INDEX WITH SOUTH WILKES-BARRE No 5. COLL'Y."

••TRACING 2 OF 2..

MINING ENGINEERING DEPT.
GLEN ALDEN COAL CO.
SOUTHERN DIVISION
WILKES-BARRE, PA.
Date
Inspector