


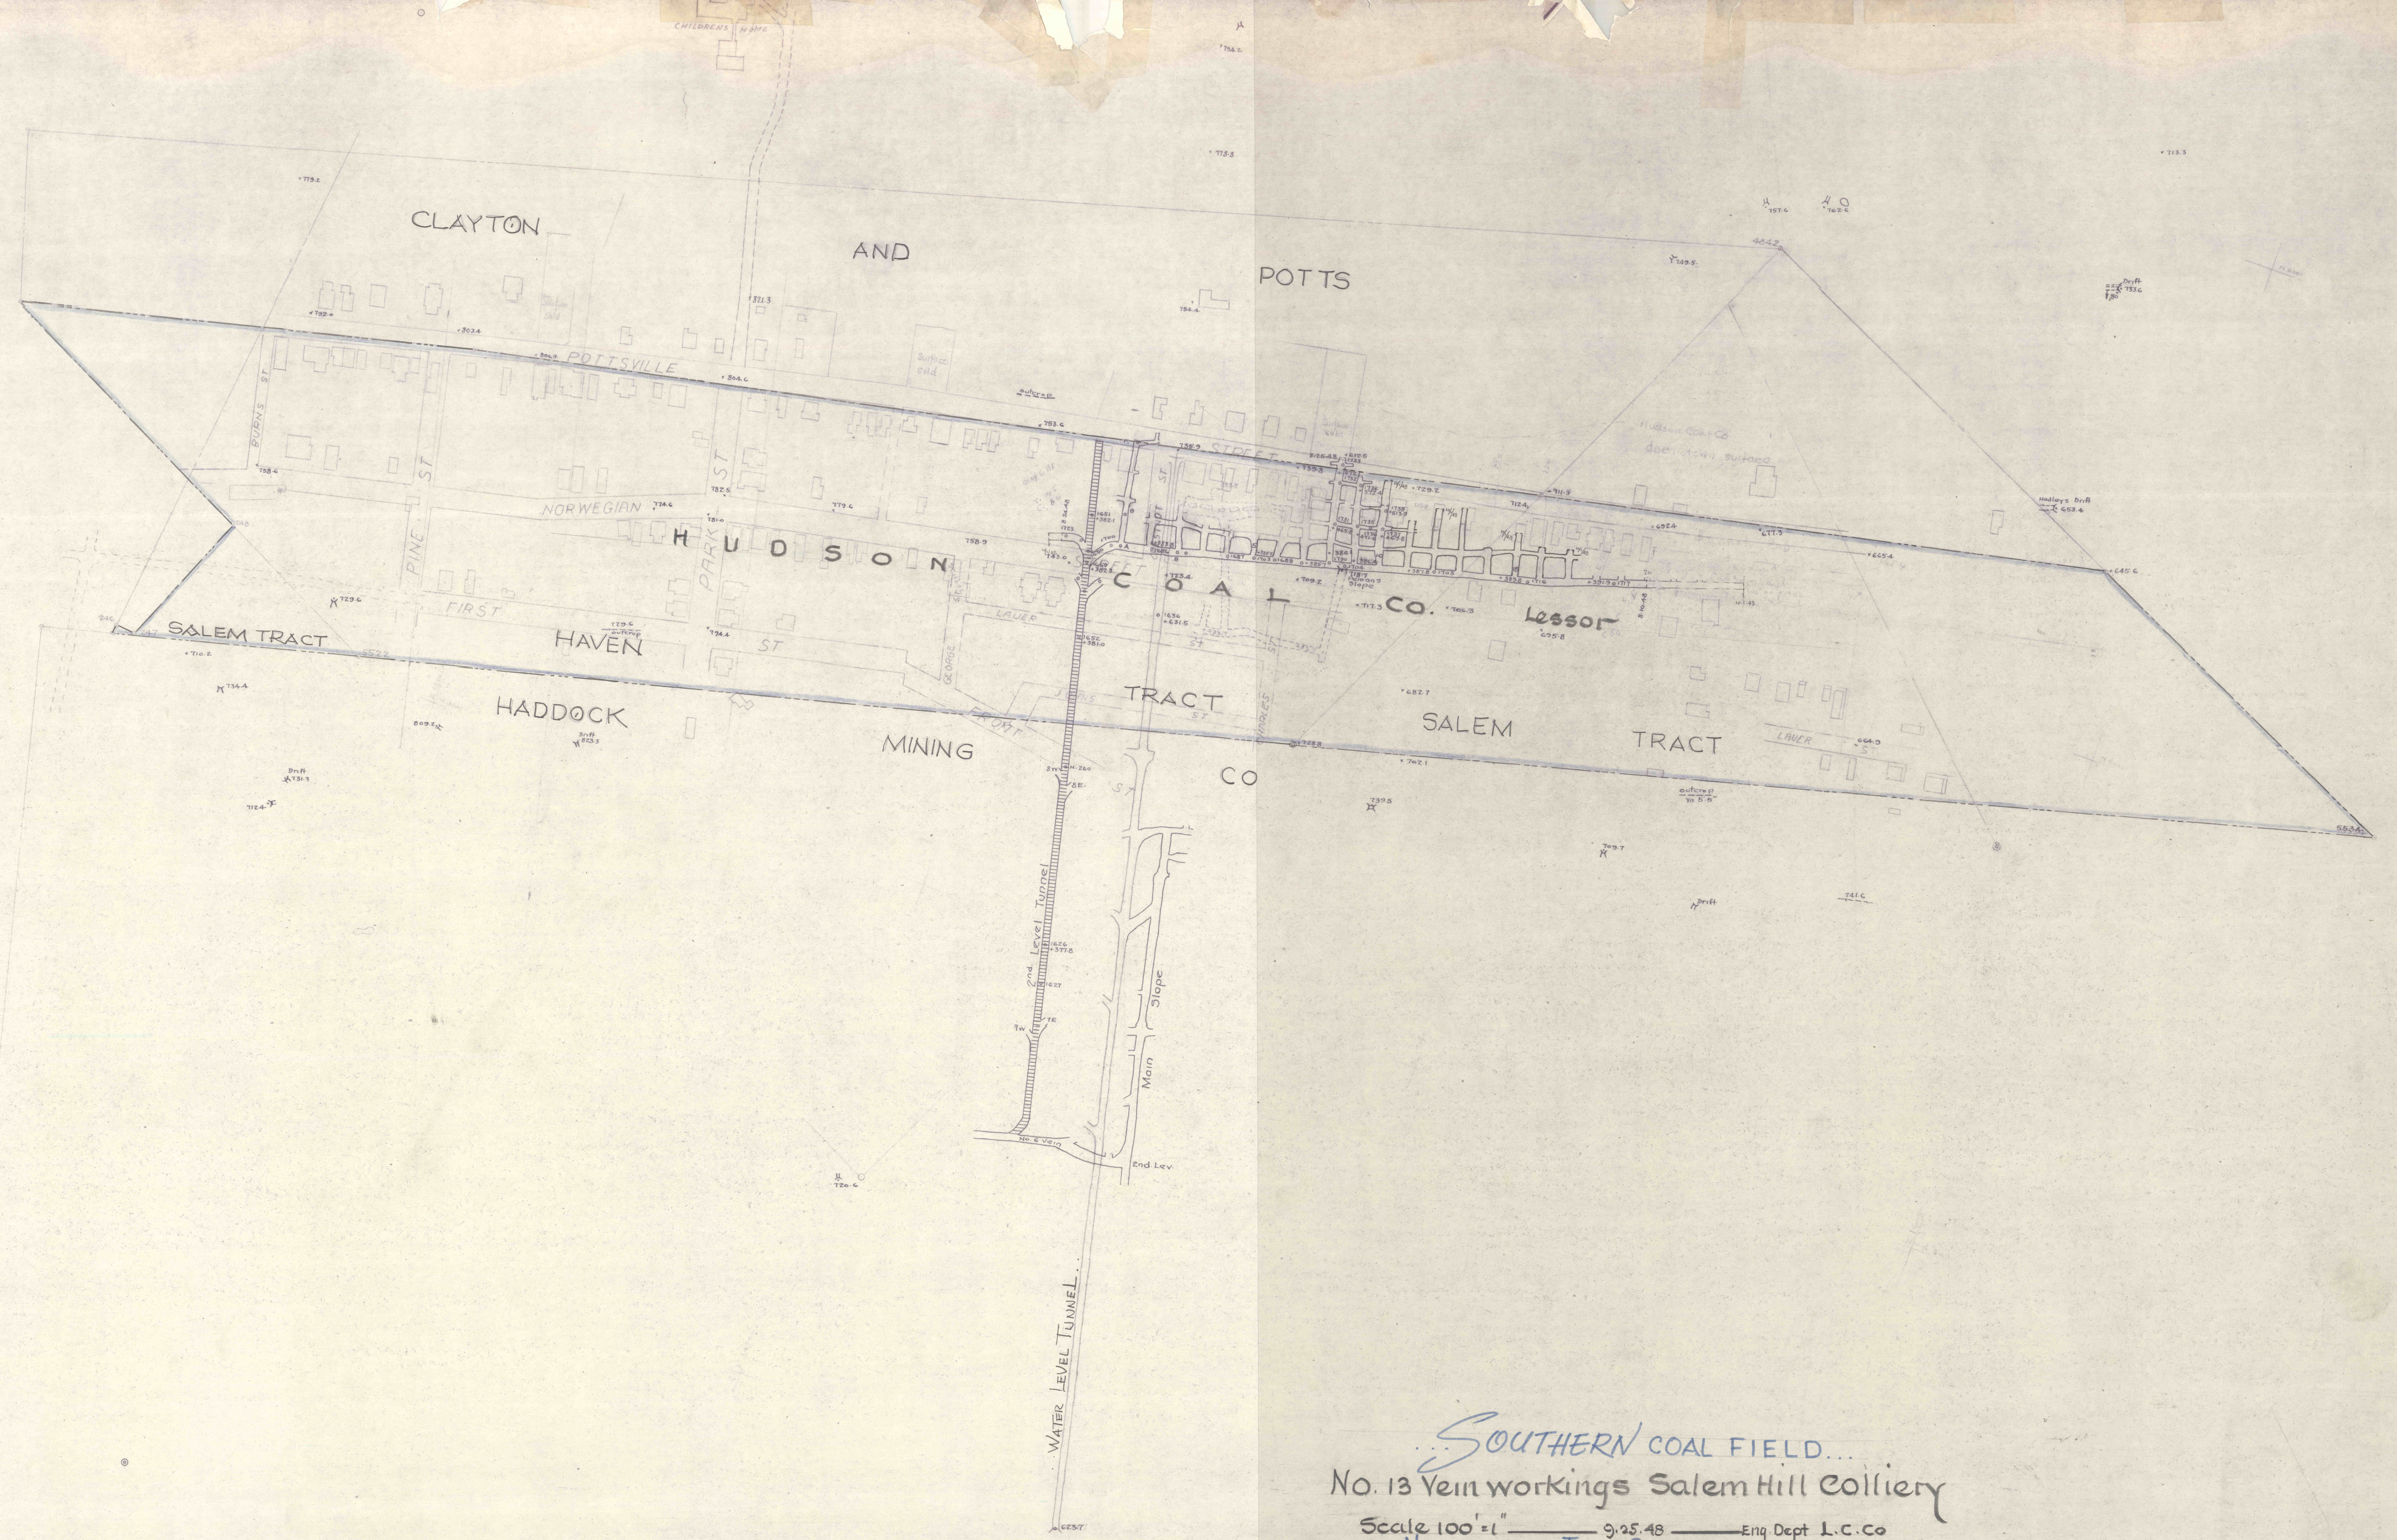

SOUTHERN COAL FIELD...
No. 13 Vein workings Salem Hill Colliery
Scale 100' = 1" — 9.25.48 — Eng Dept L.C.Co
EAST NORWEGIAN TWP., SCHUYLKILL COUNTY, PA.,
PALO ALTO..

MF
MAY 13 1905