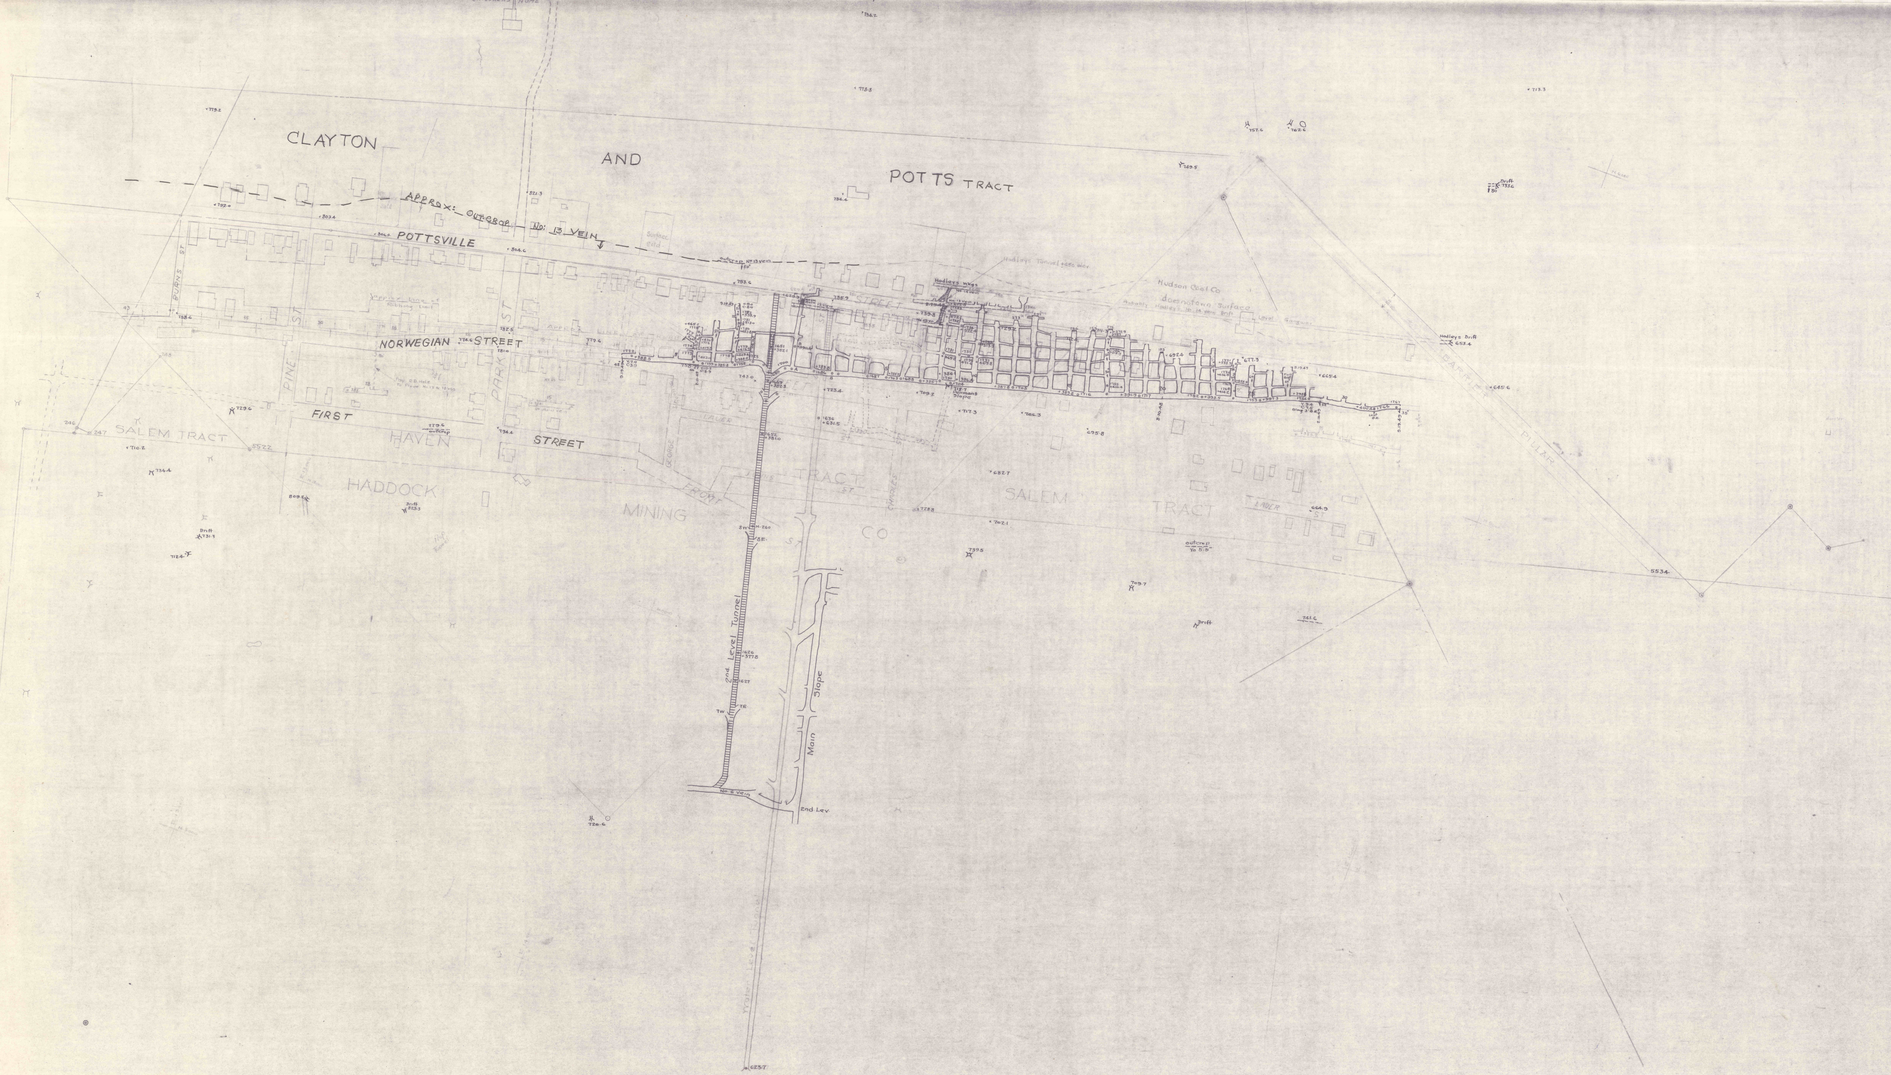

..SOUTHERN COAL FIELD..

E. NORWEGIAN TWP. SCHUYLKILL COUNTY PA.,

SALEM HILL COAL CO.

SALEM HILL COLLIERY

No. 13 VEIN TRACING

Scale: 100' = 1". · 12-27-48 Eng Dept L C Co

Posted: 9-15-1949.