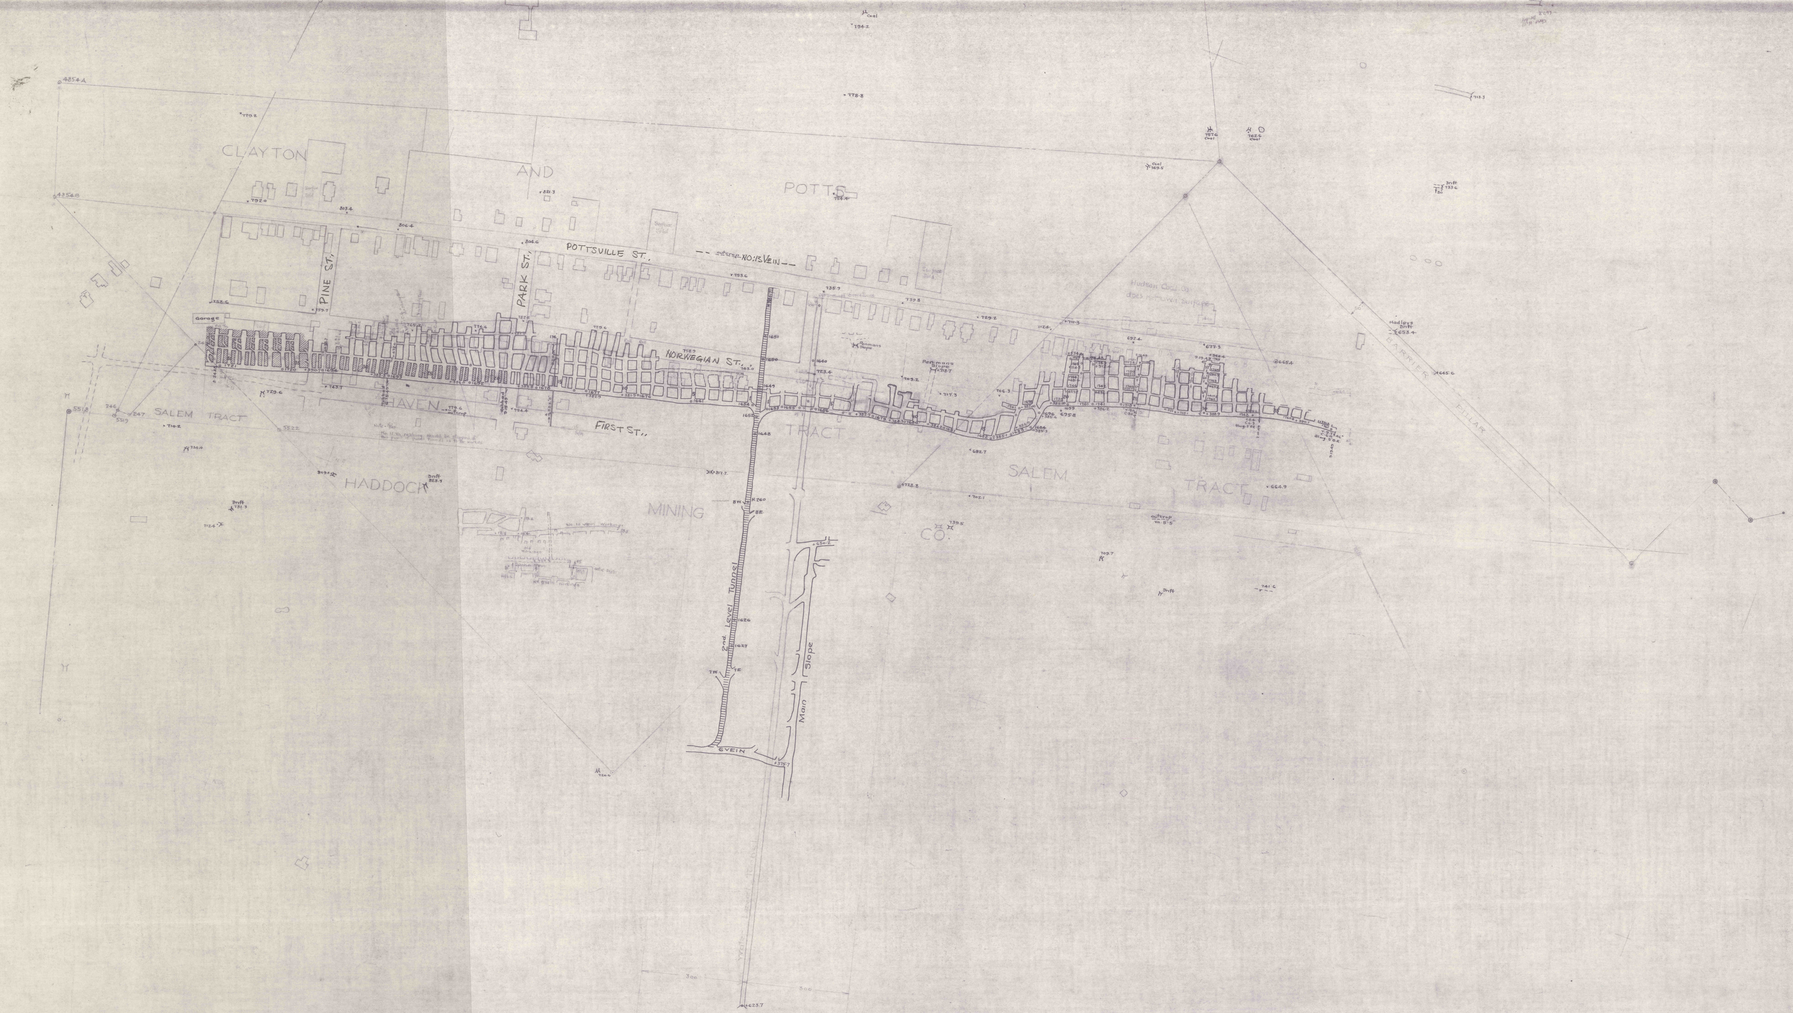


1 OF 2.

SOUTHERN FIELD

SALEM HILL COAL CO.

EAST NORWEGIAN TWP. SCHUYLKILL CO. PA.

SALEM HILL COLLIERY

No 11 VEIN TRACING

Scale 100' = 1" 12-27-48 Eng. Dept. L. C. Co.

Posted 2-9-49