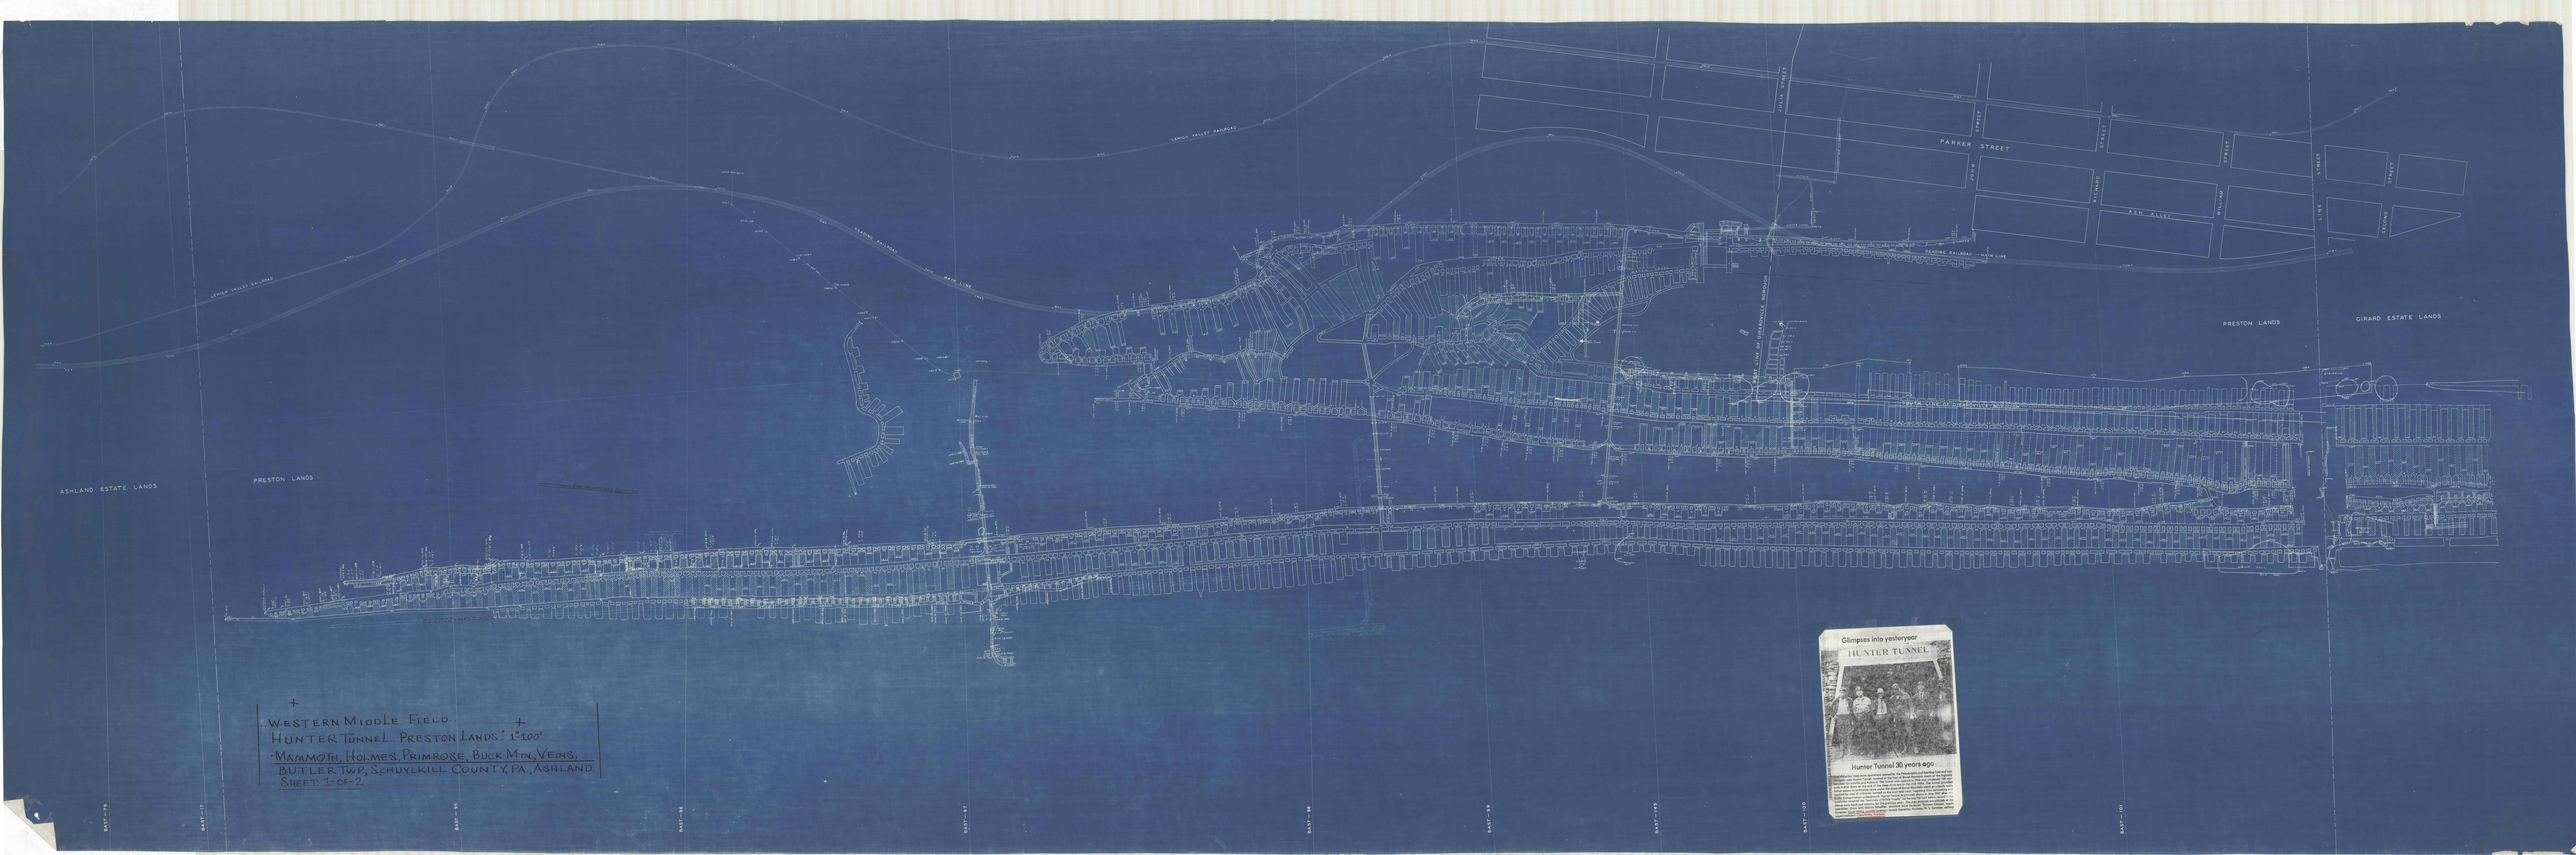

WESTERN MIDDLE FIELD.
HUNTER TUNNEL. PRESTON LANDS. 1"=100'
MAMMOTH, HOLMES, PRIMROSE, BUCK MTN. VEINS.
BUTLER TWP, SCHUYLKILL COUNTY, PA., ASHLAND.
SHEET 1 OF 2.

Glimpses into yesteryear

HUNTER TUNNEL

Hunner Tunnel 30 years ago