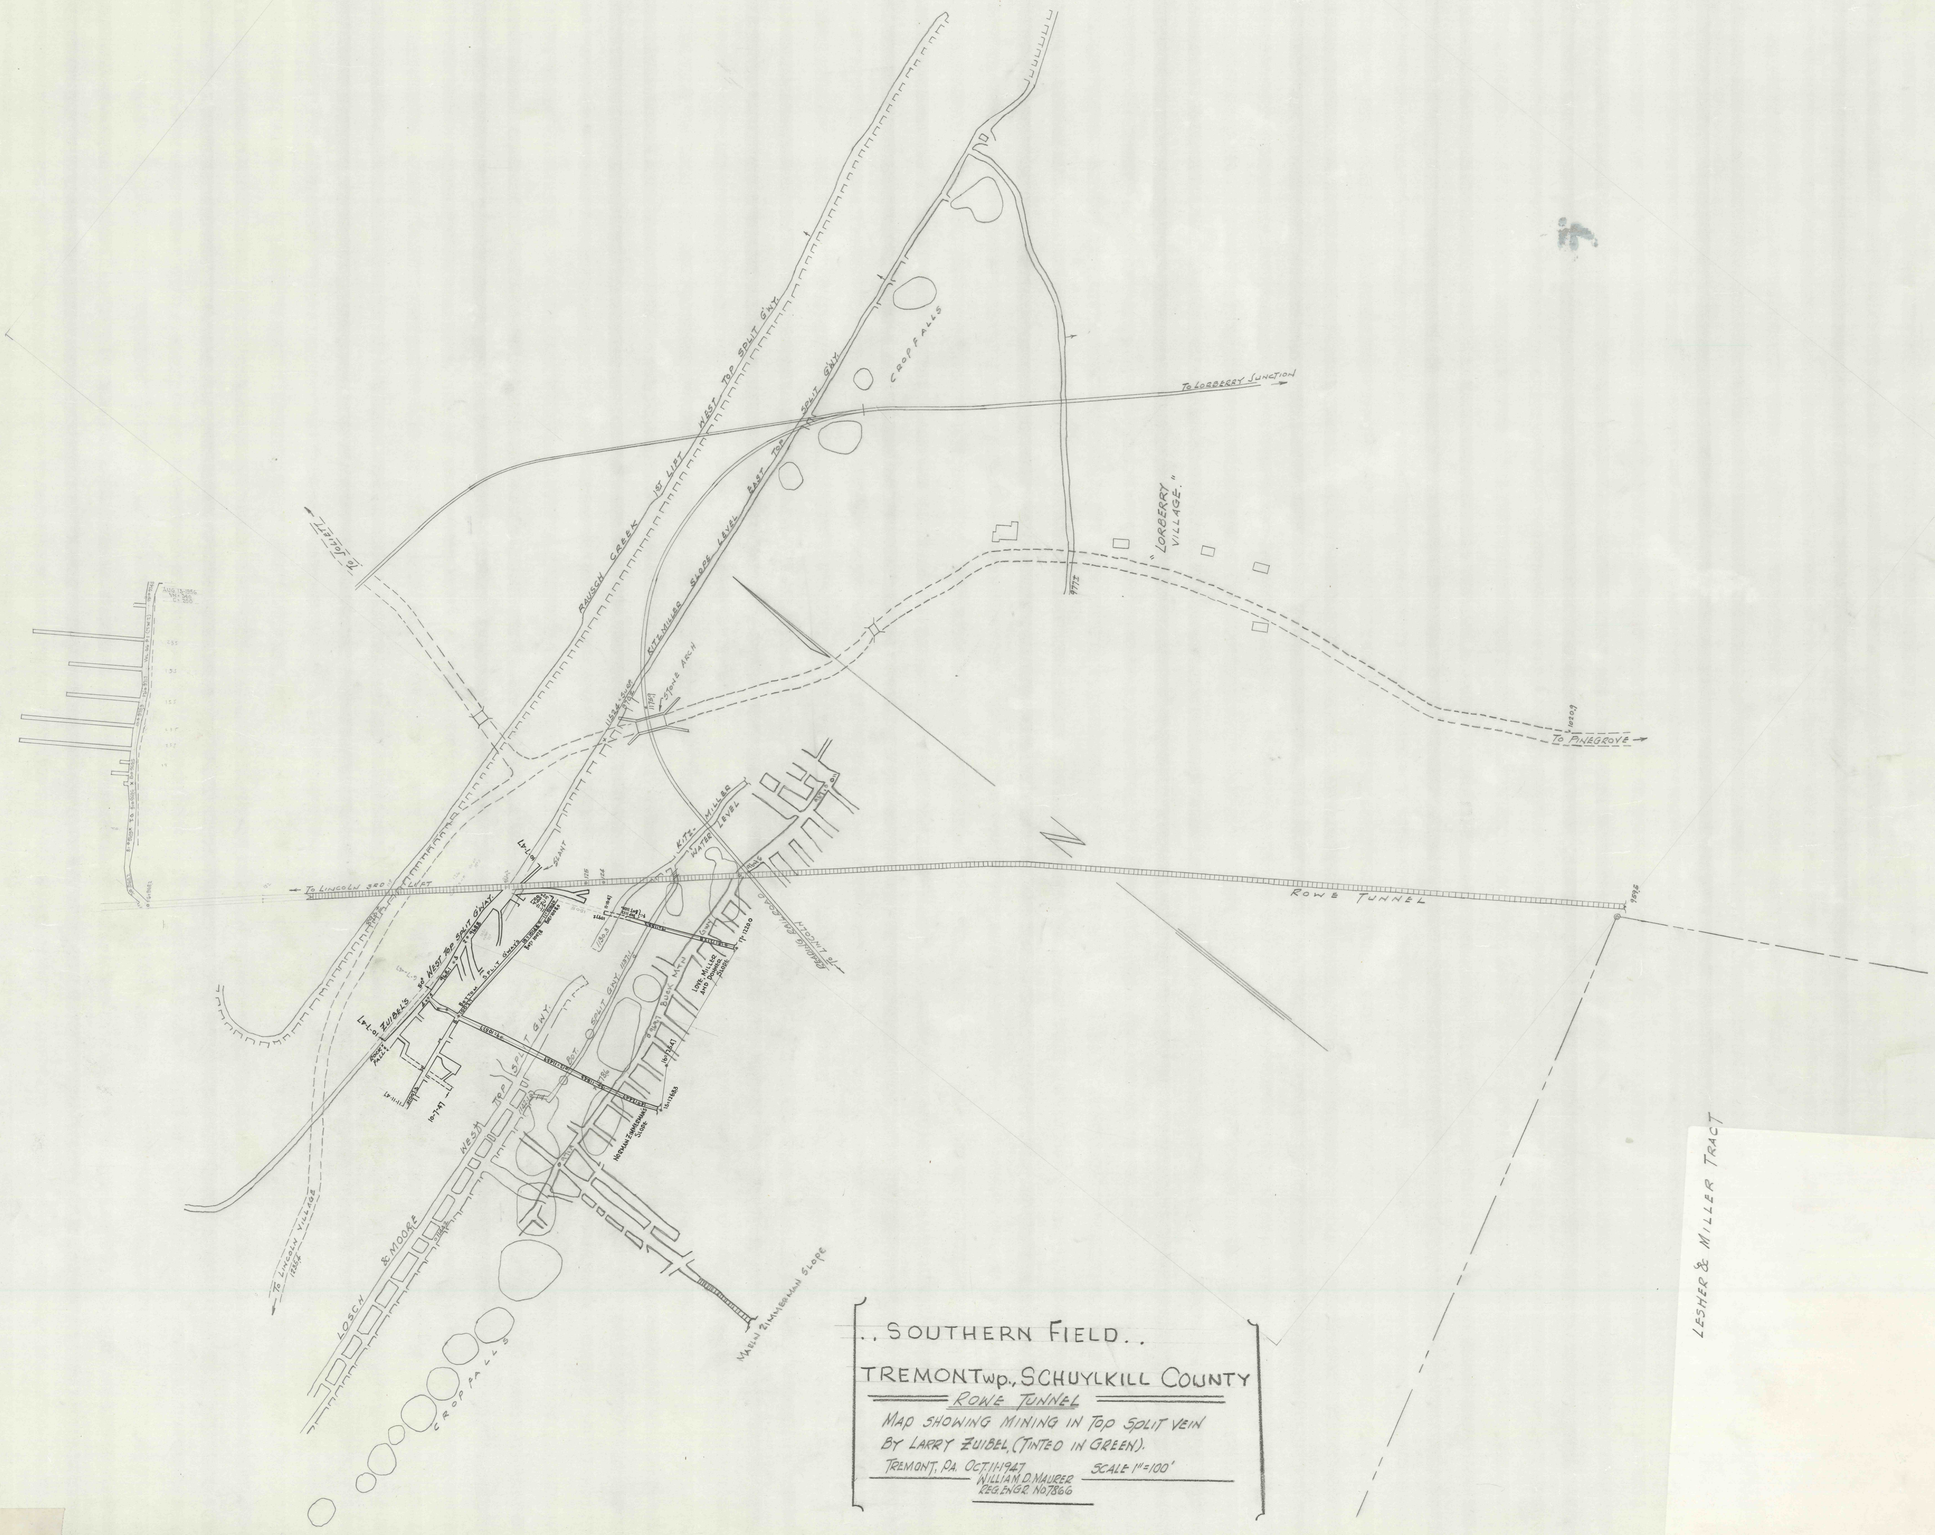
To Lorberry Junction
Crop Falls
Kitzmiller Slope Level
Kitz. Miller Water Level
Rowe Tunnel
To Pinegrove
Lorberry Village
To Lincoln Village
Losch & Moore
Crop Falls
