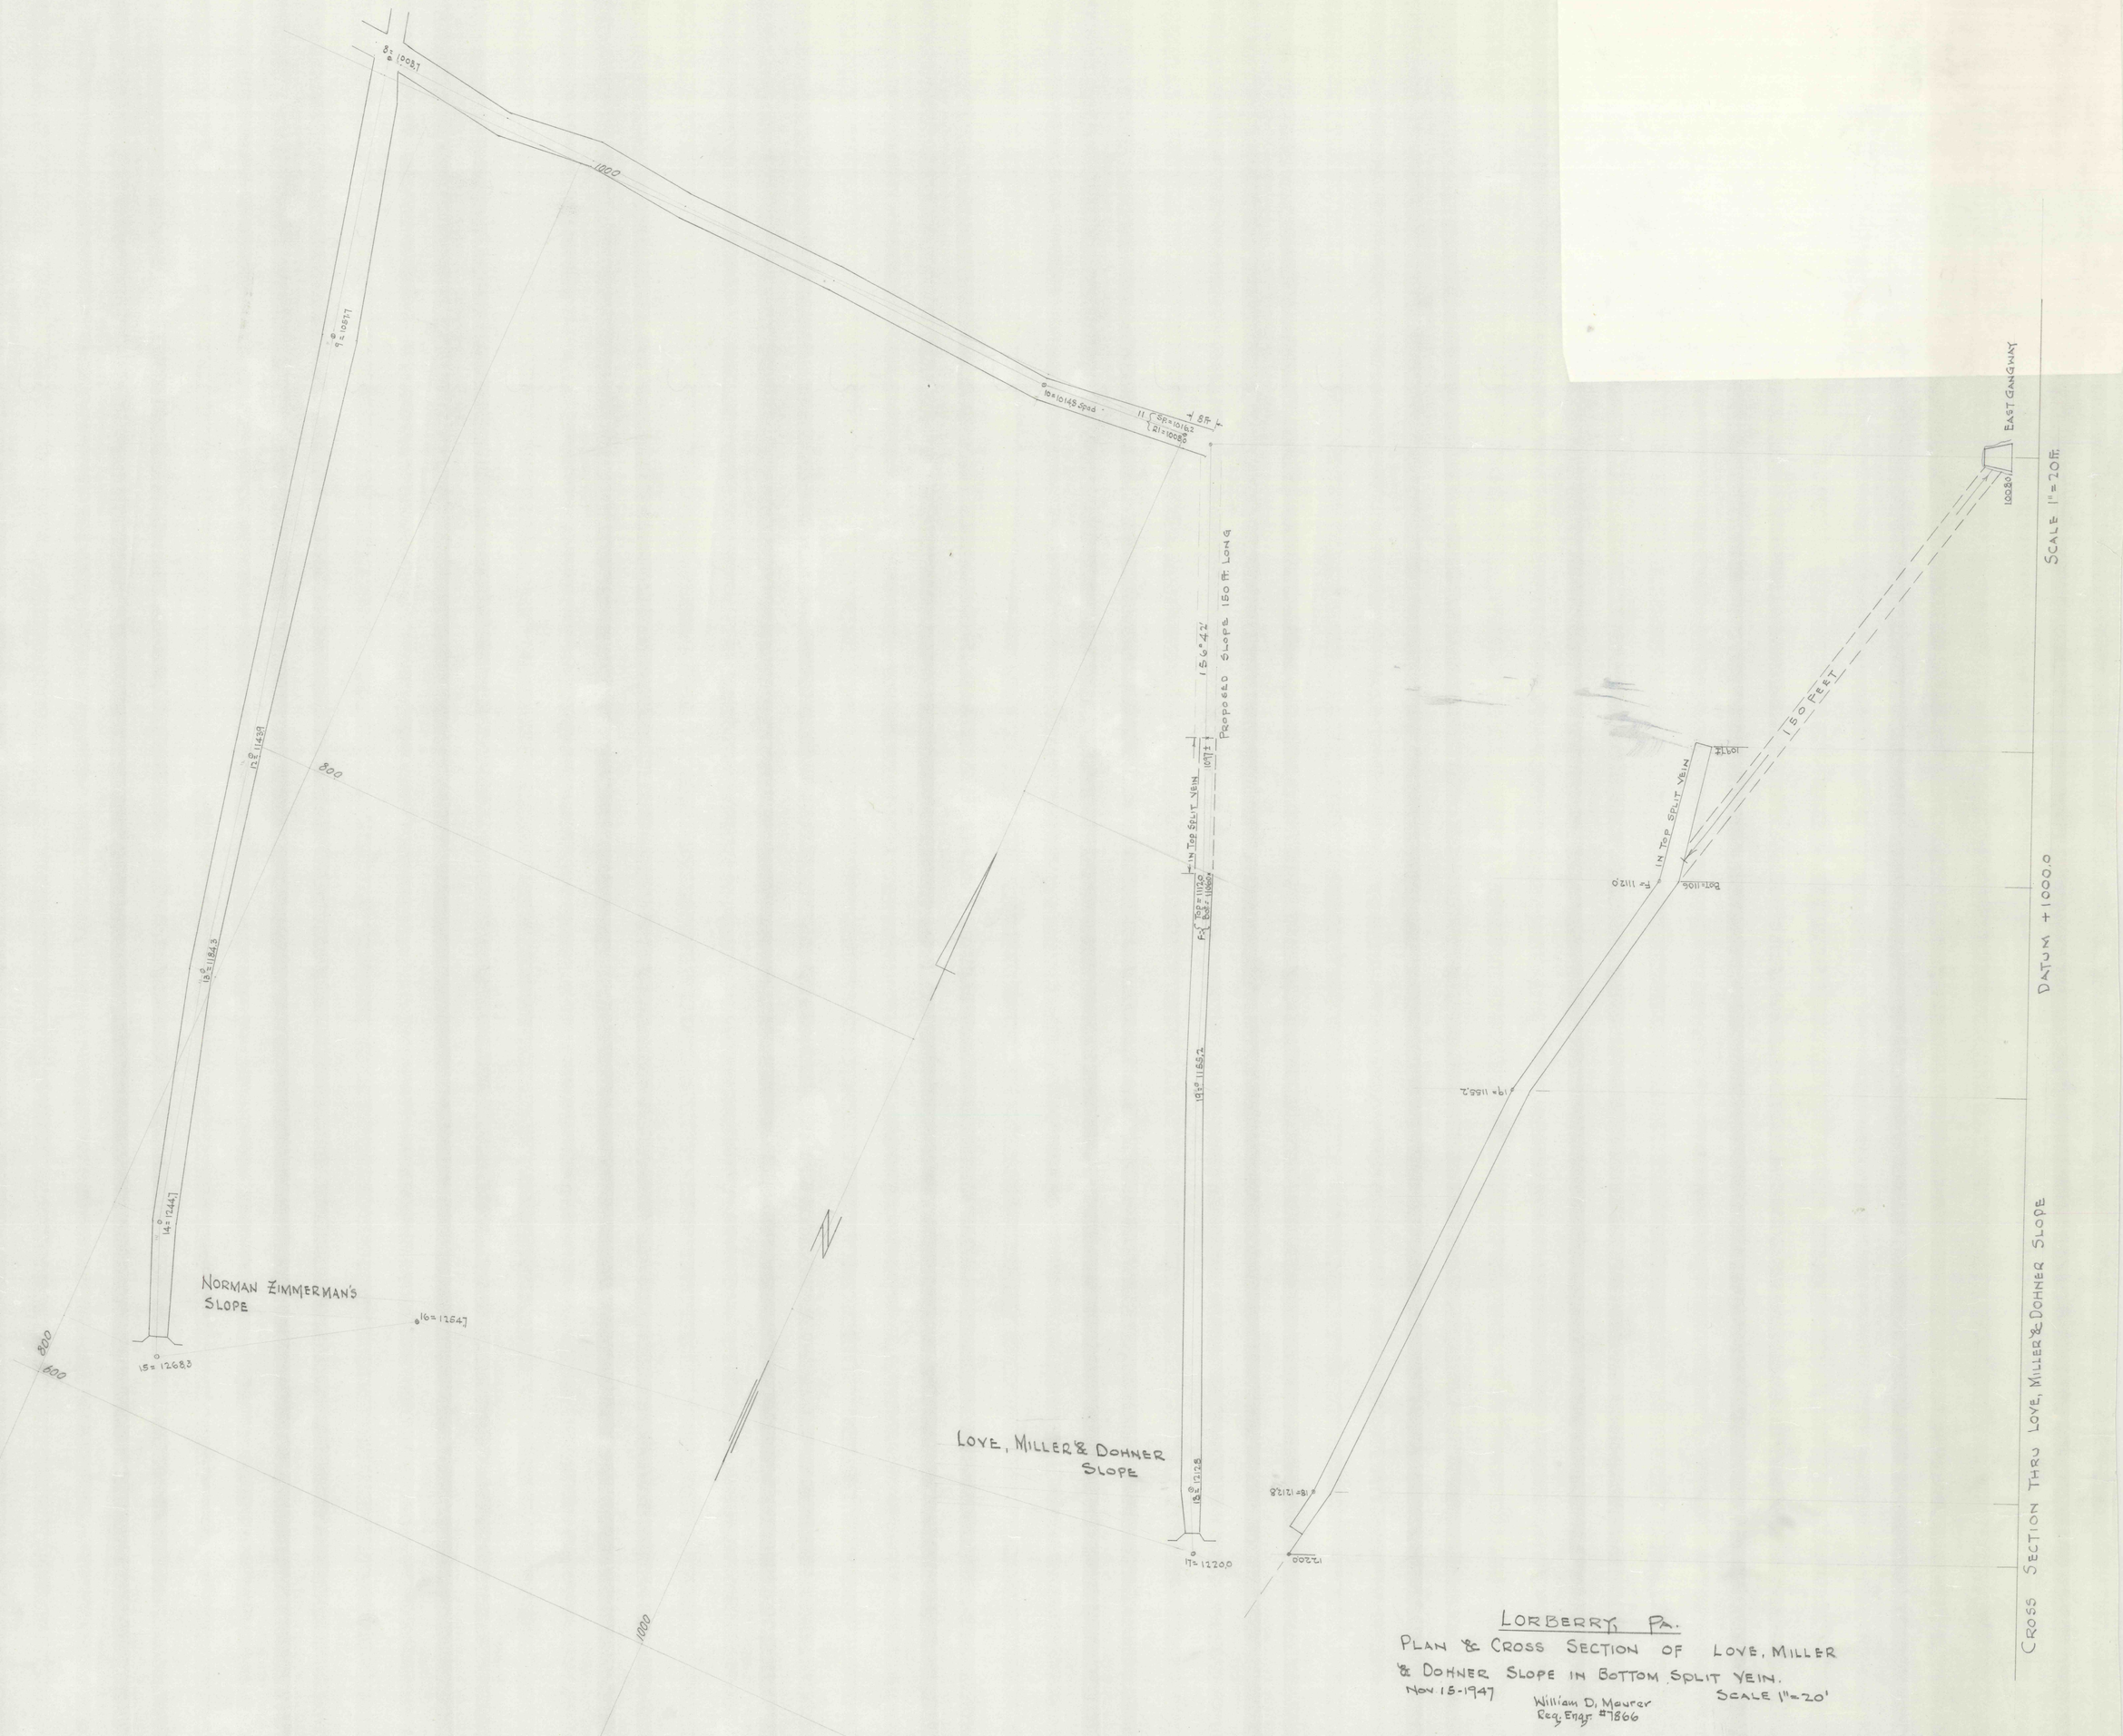

LORBERRY, PA.

PLAN & CROSS SECTION OF LOVE, MILLER & DOHNER SLOPE IN BOTTOM SPLIT VEIN.

NOV. 15-1947

William D. Maurer
Reg. Engr. #7866

SCALE 1" = 20'