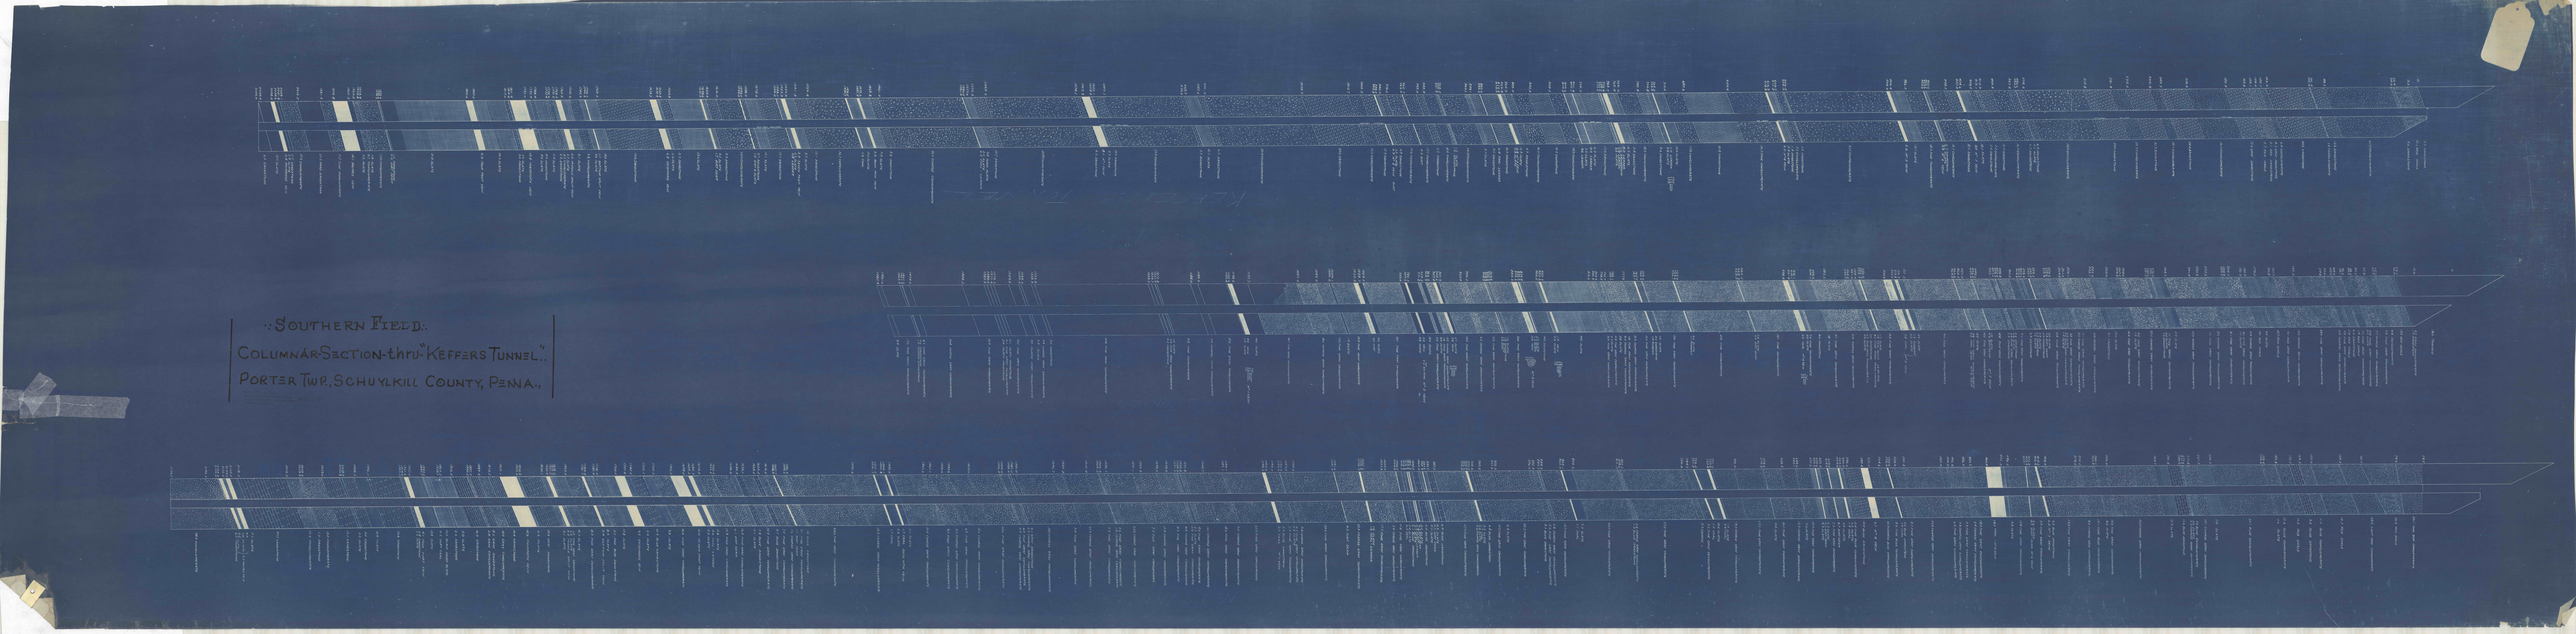

Southern Field.
Columnar Section thru "Keffers Tunnel".
Porter Twp, Schuylkill County, Pena.,