


Section on Meridian

Scale 1 in. = 100 ft.

COLBERT COLLIERY, SHAMOKIN, PA.
\$13,000 WESTERN MIDDLE FIELD.
COLE RUN FIRE AREA
12100

Approx.
South Limit
Fire Area
July-1960

COLE RUN SLOPE OLD WORKINGS

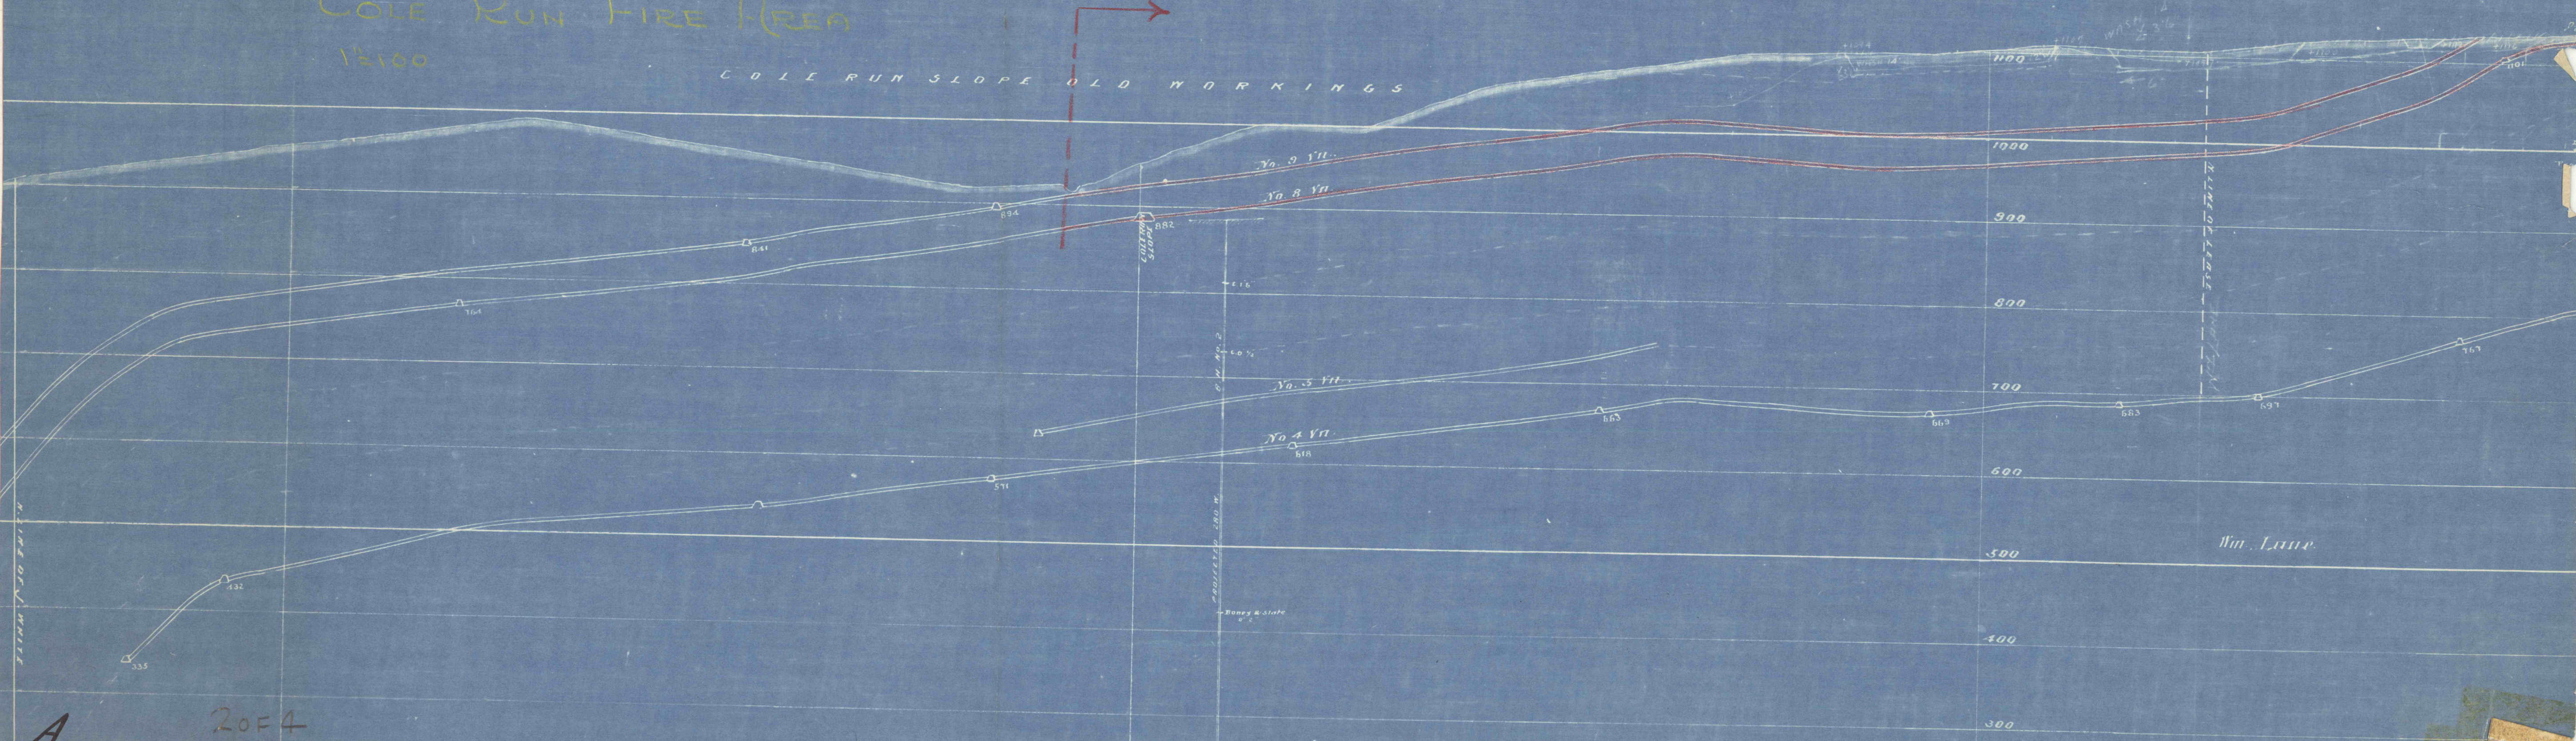

Win. Lane