

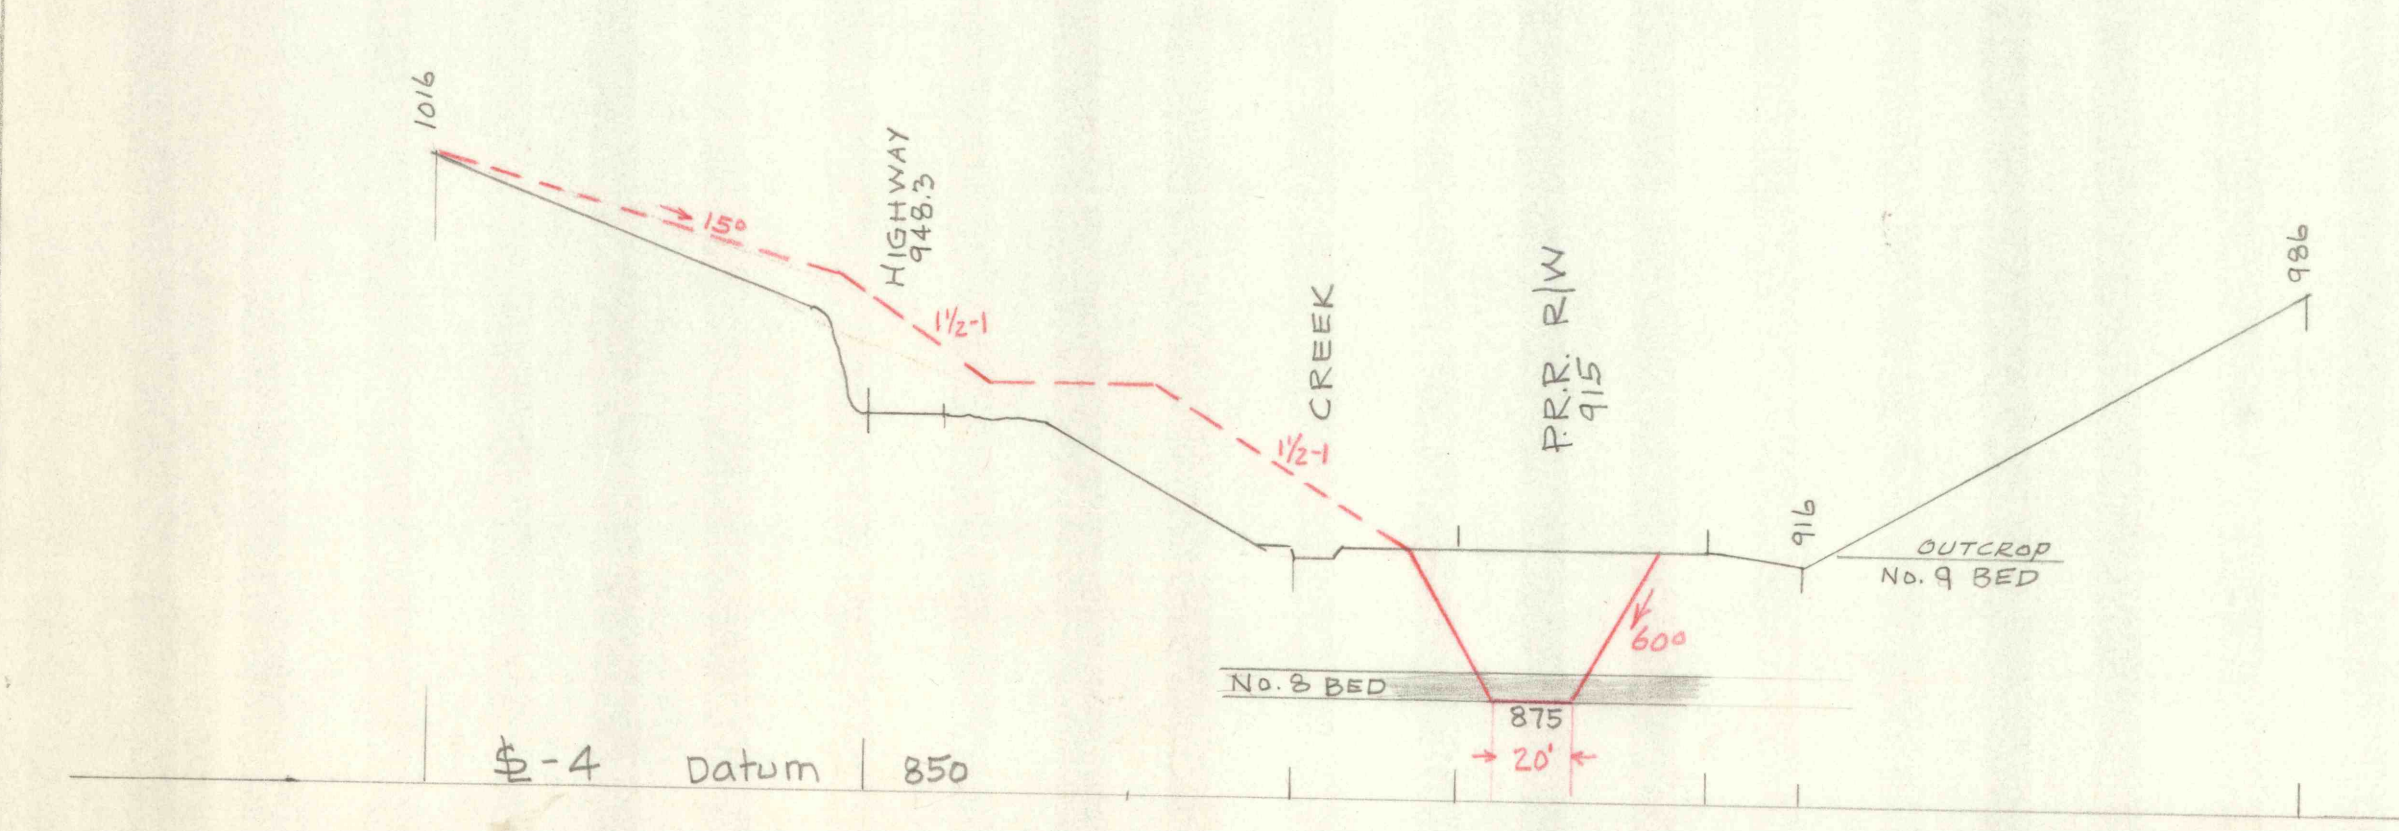
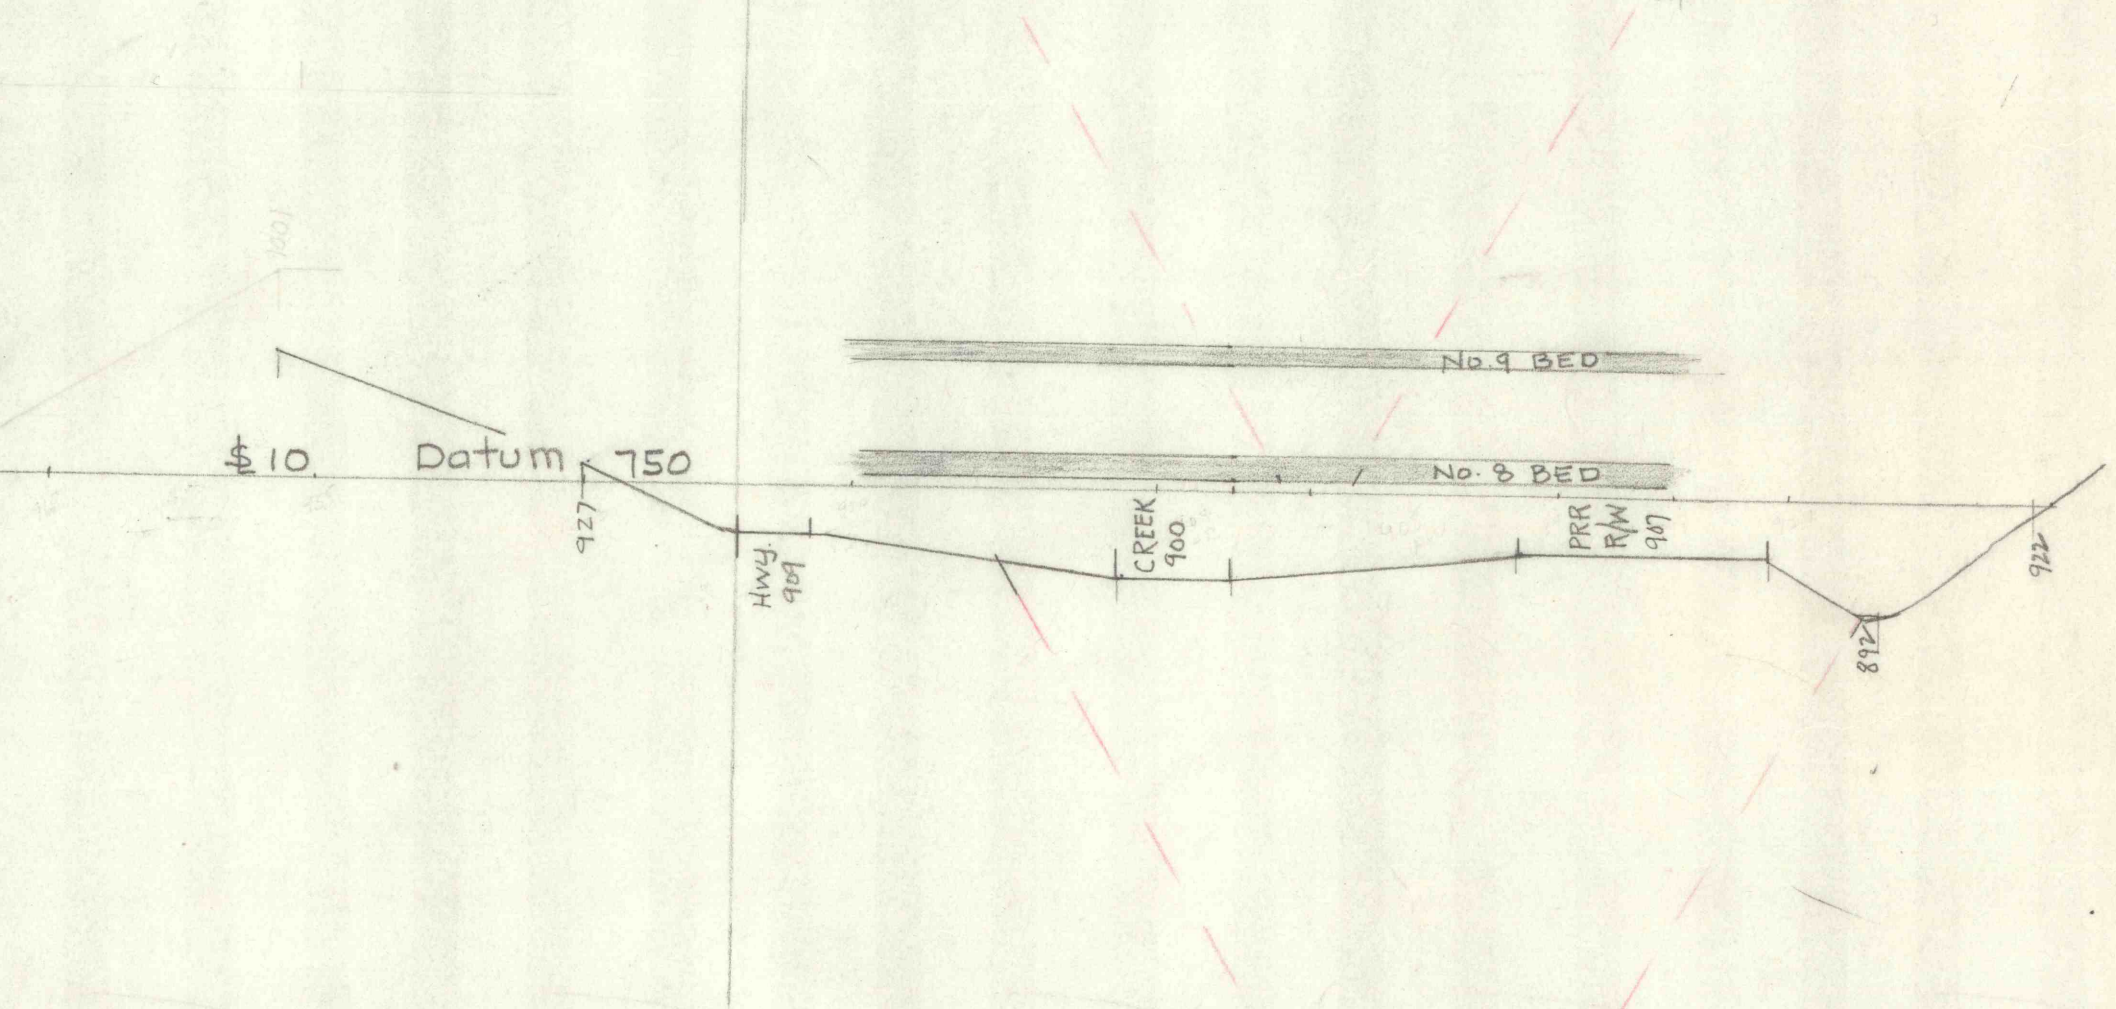
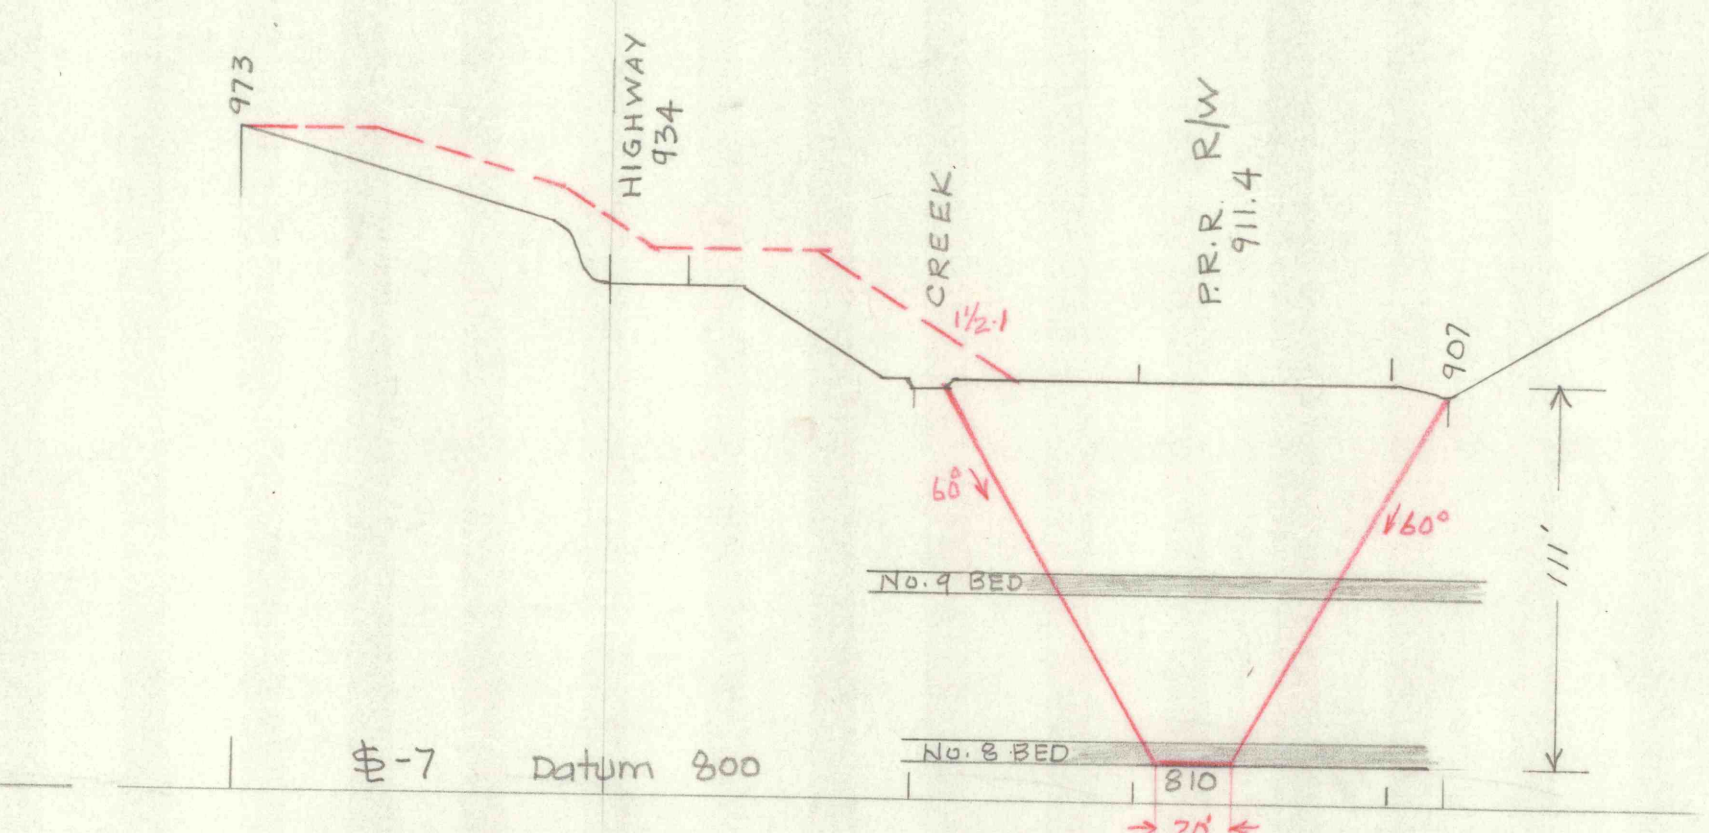
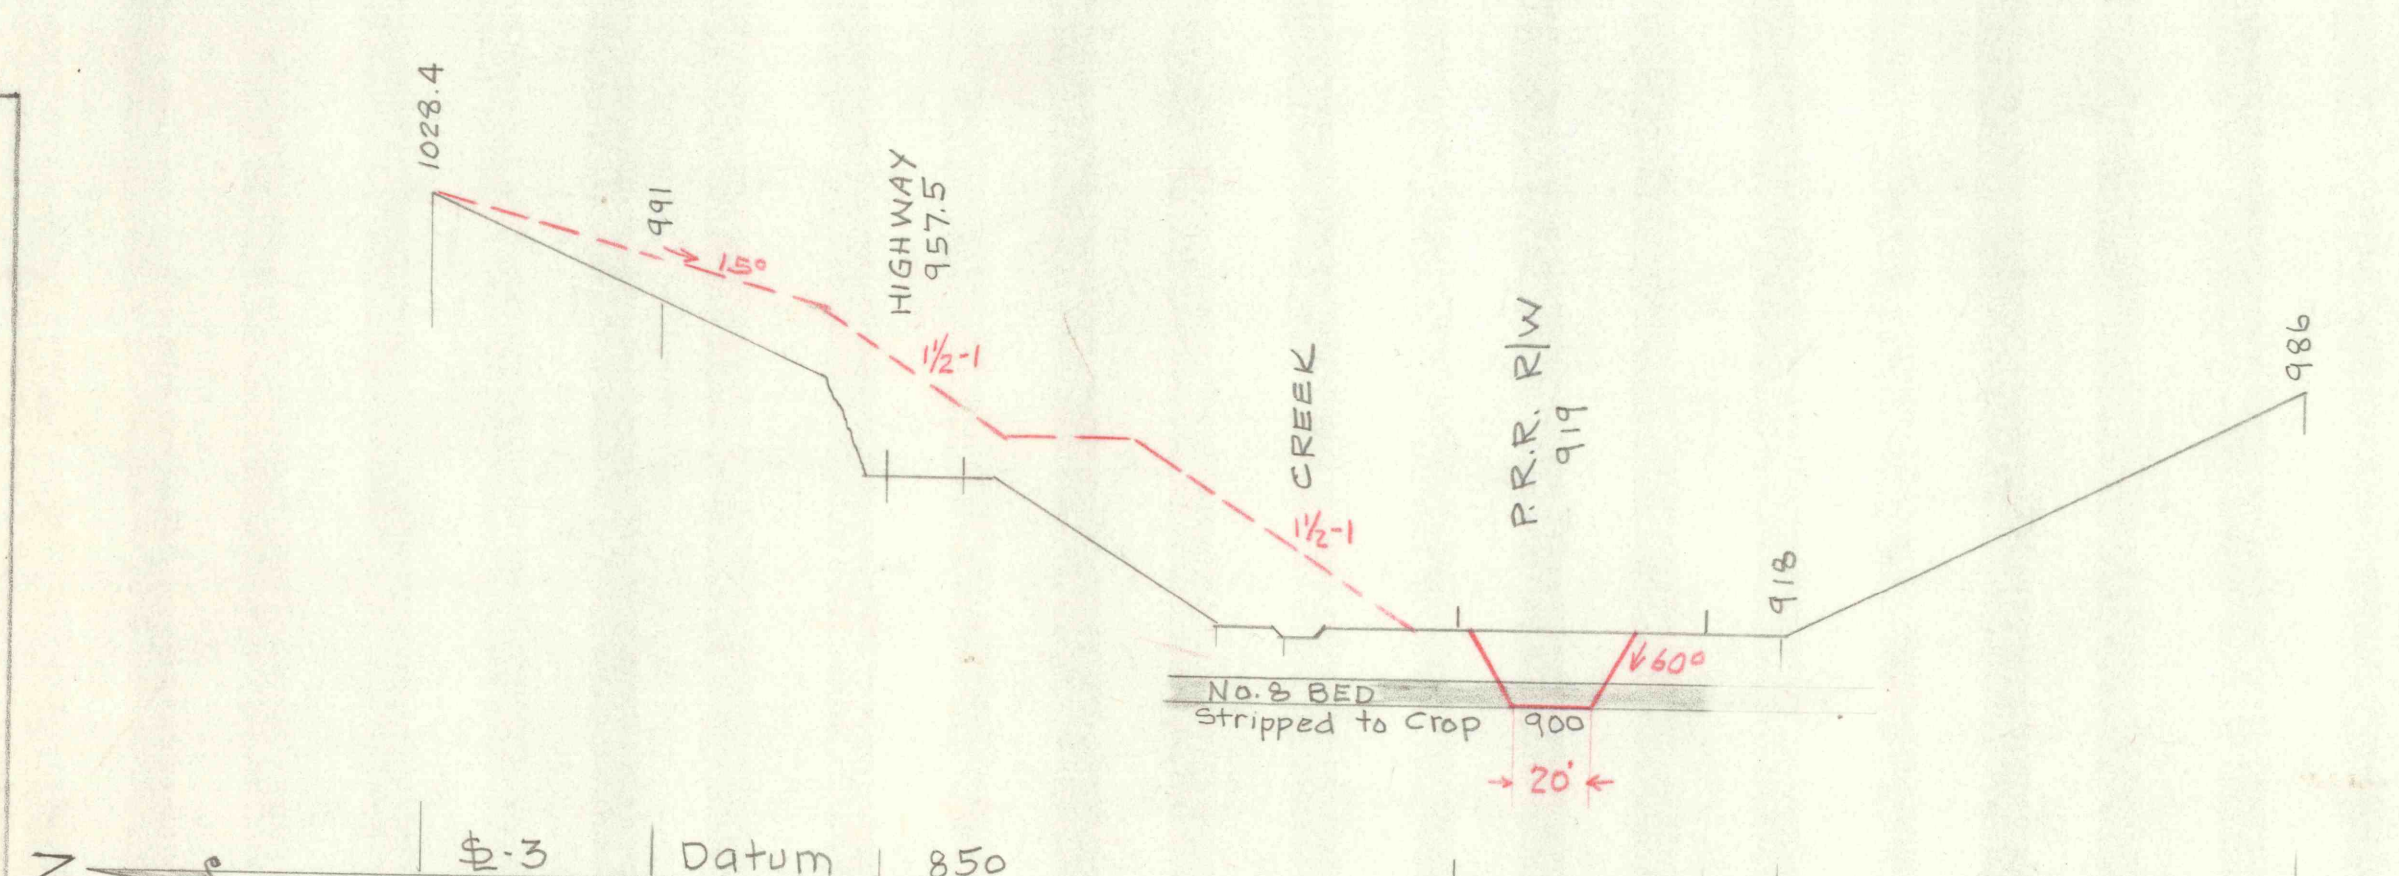
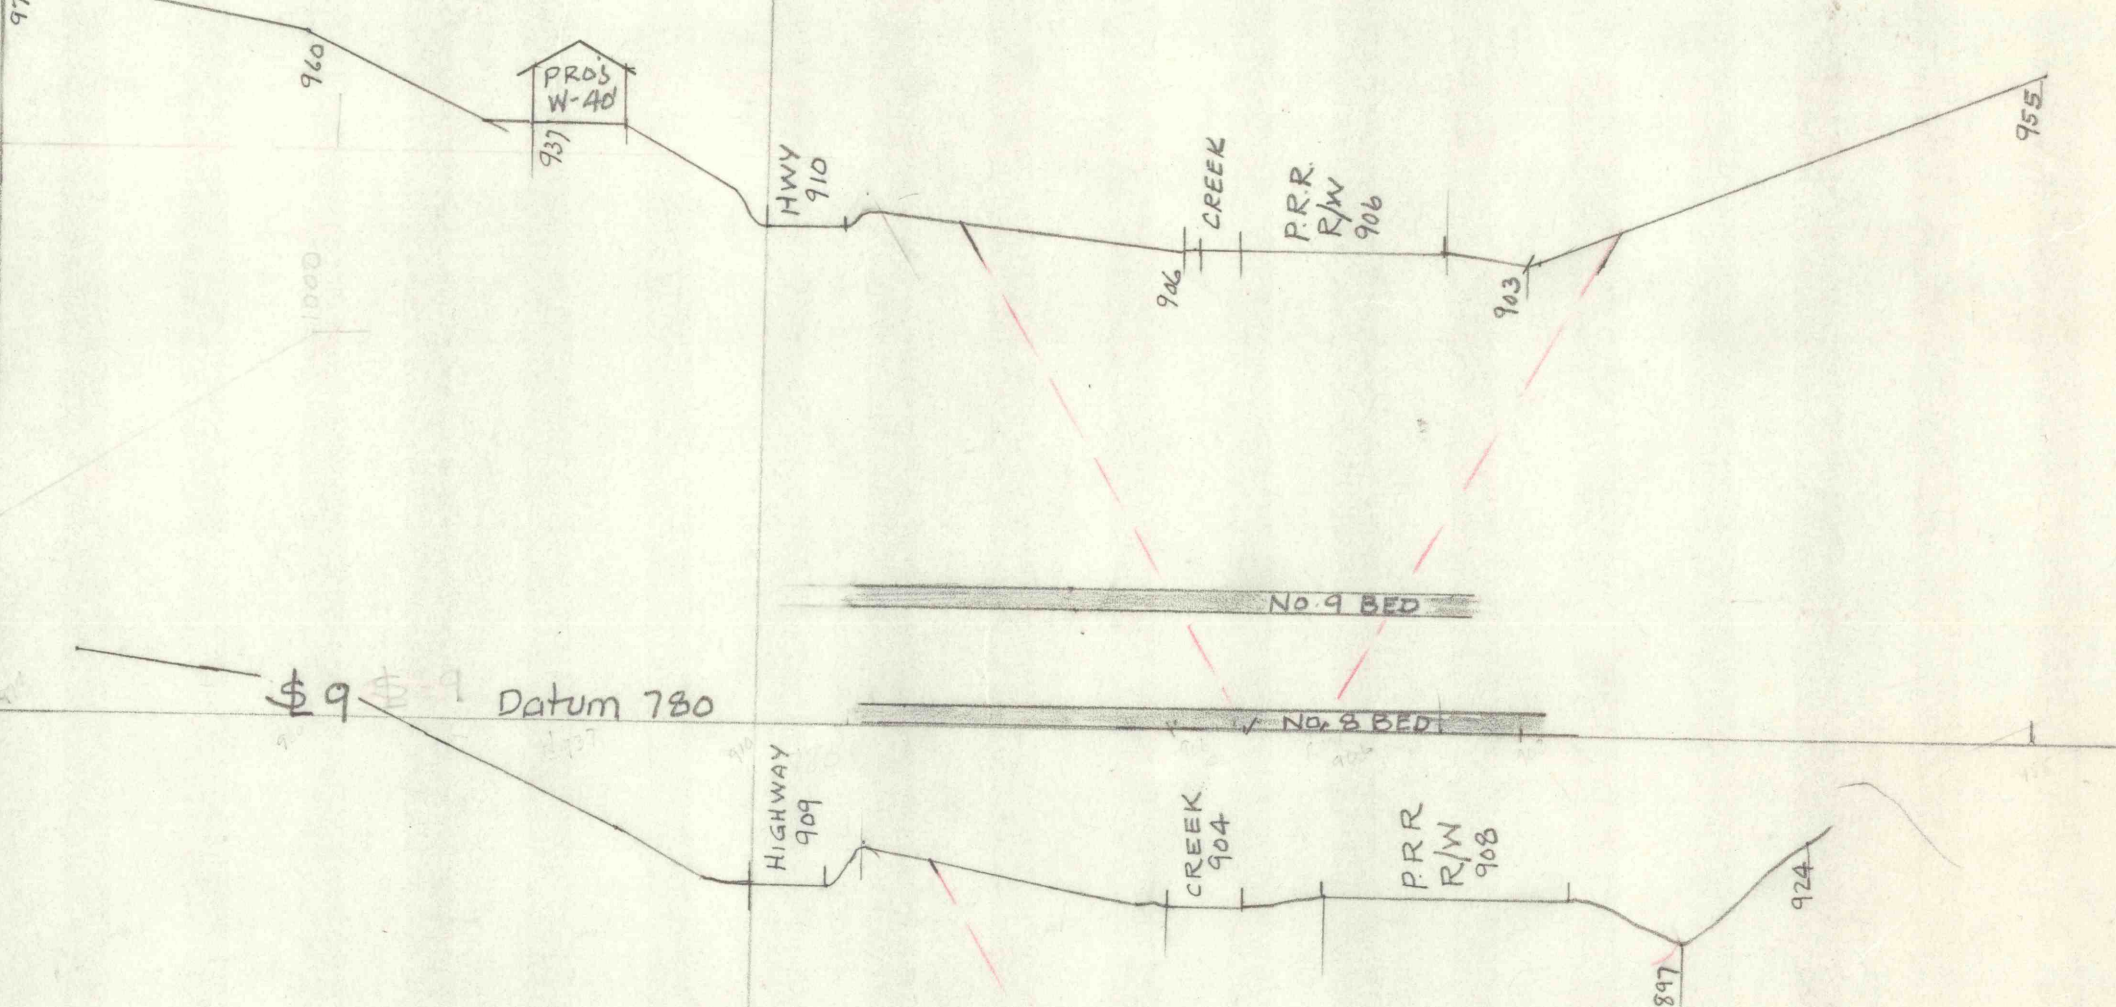
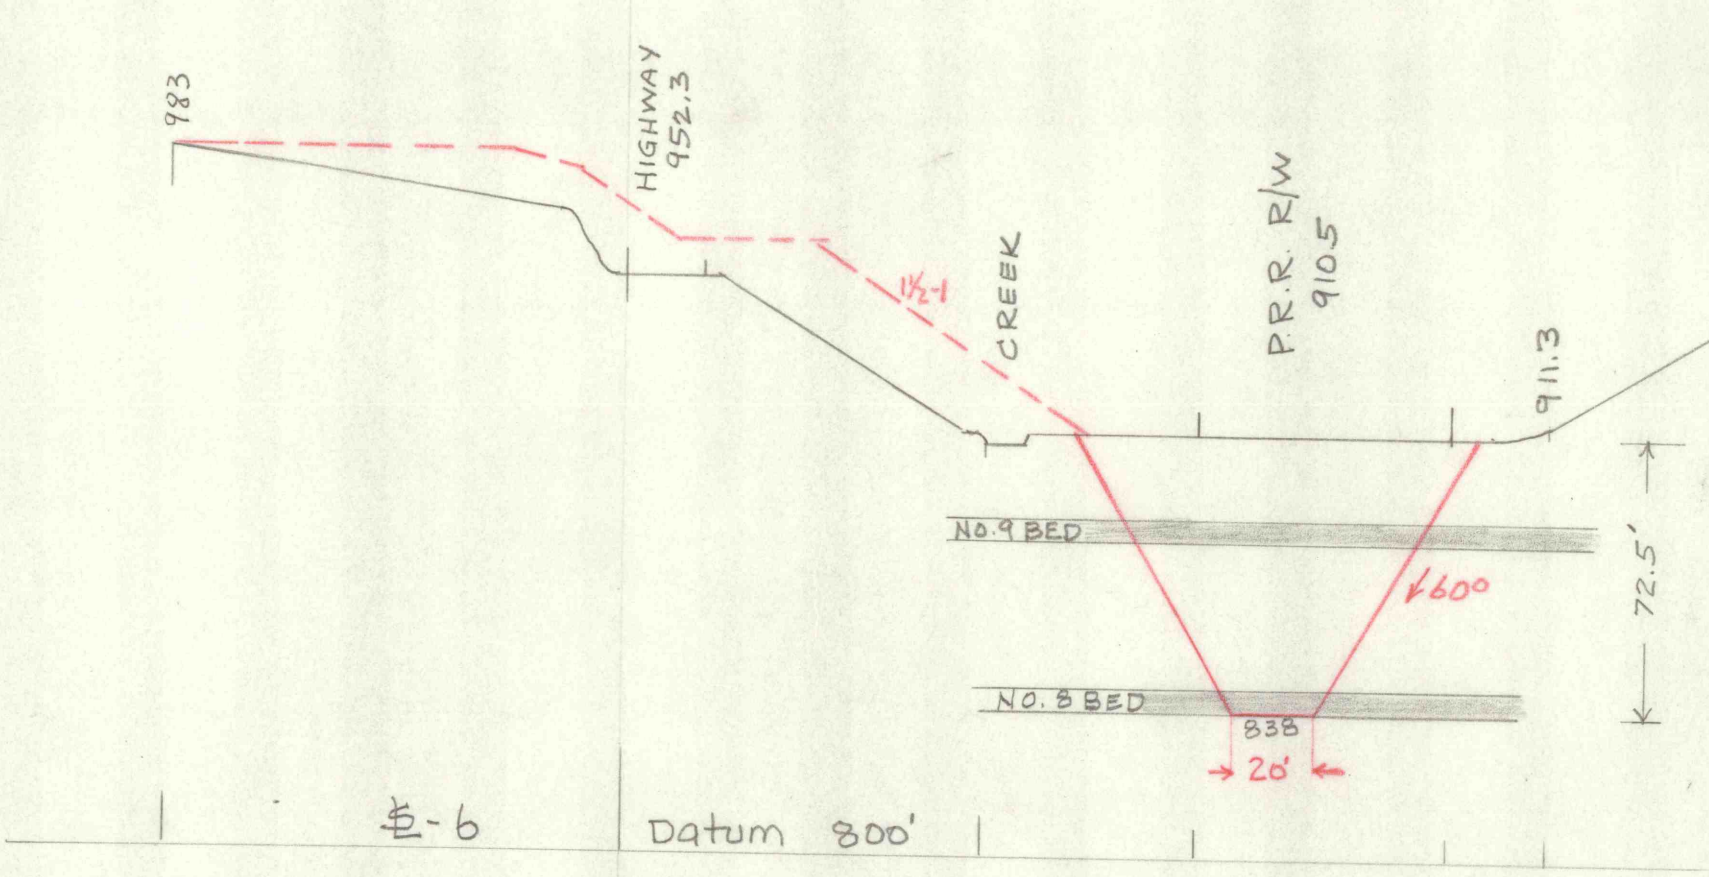
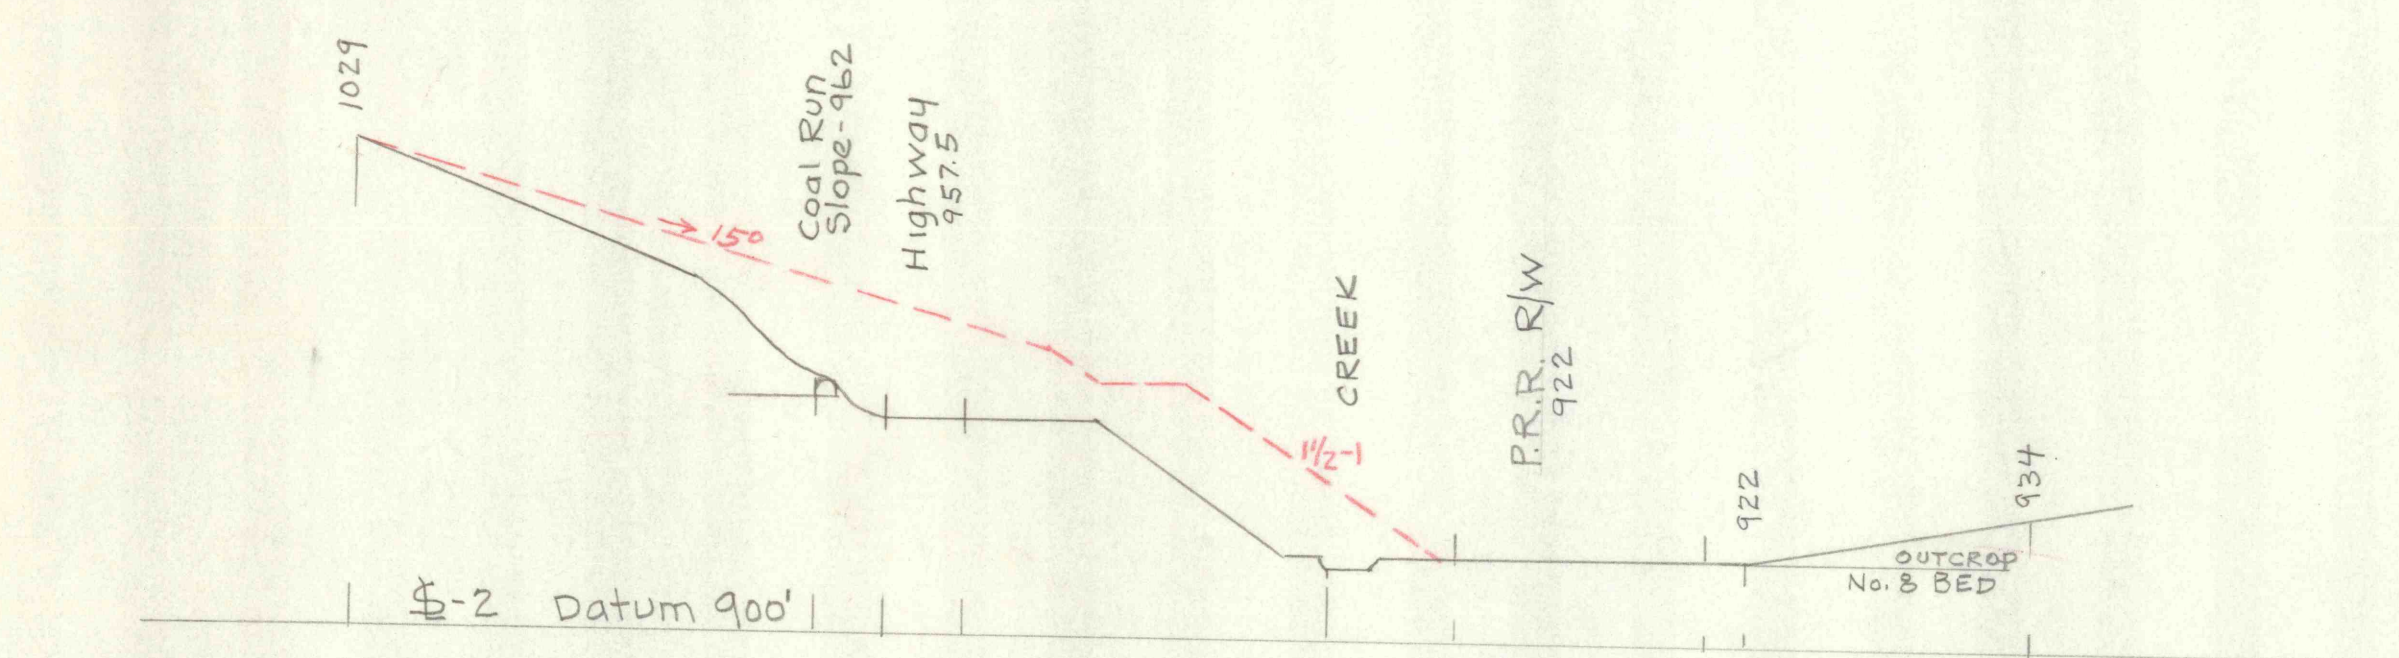
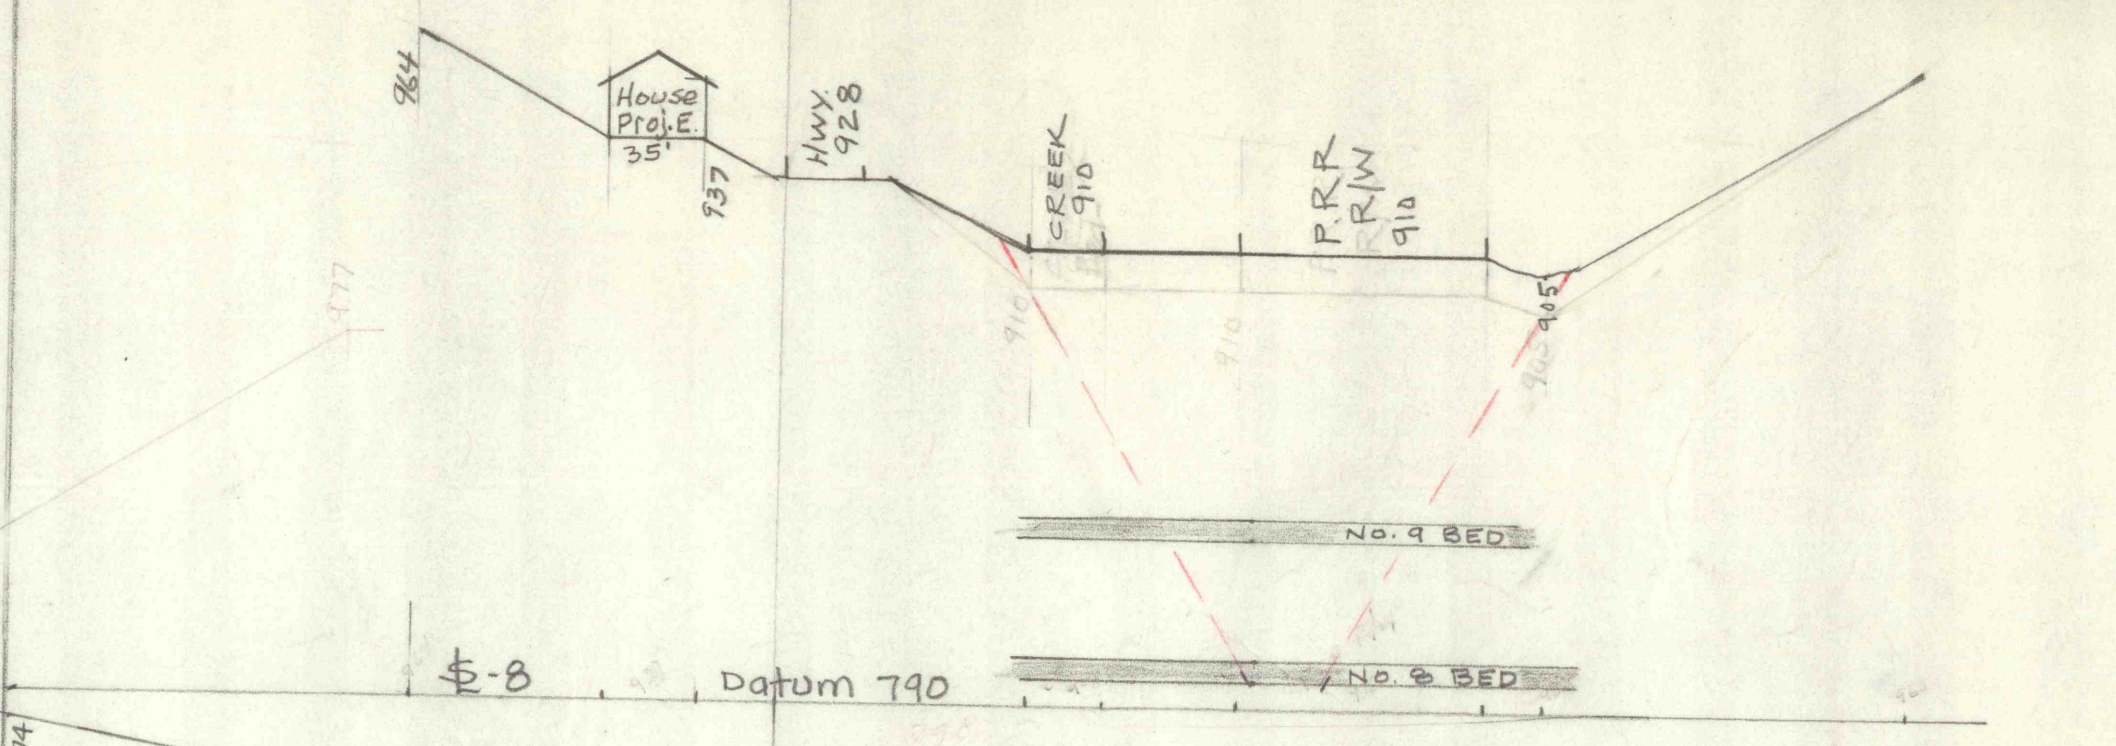
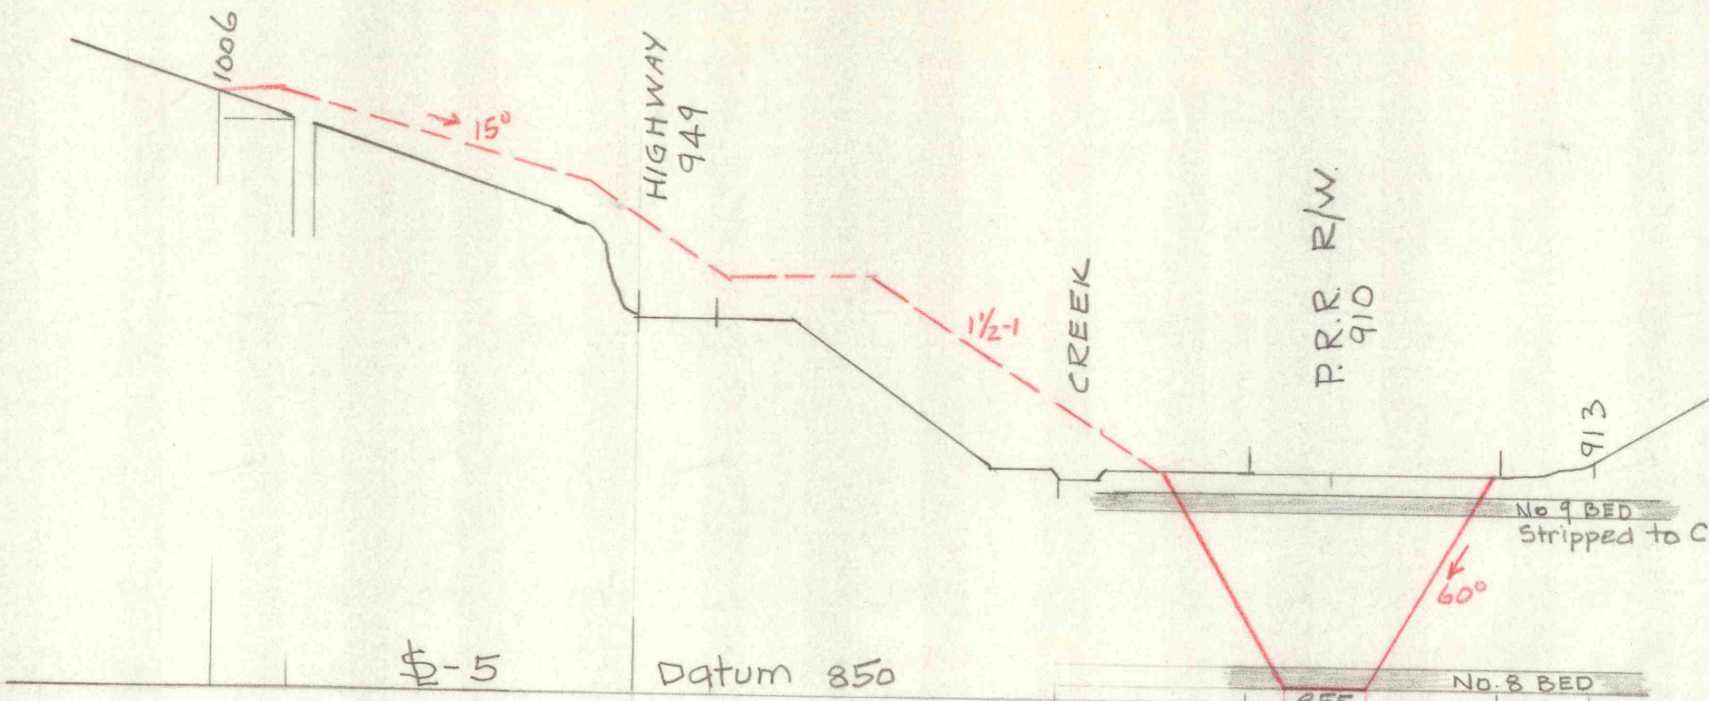


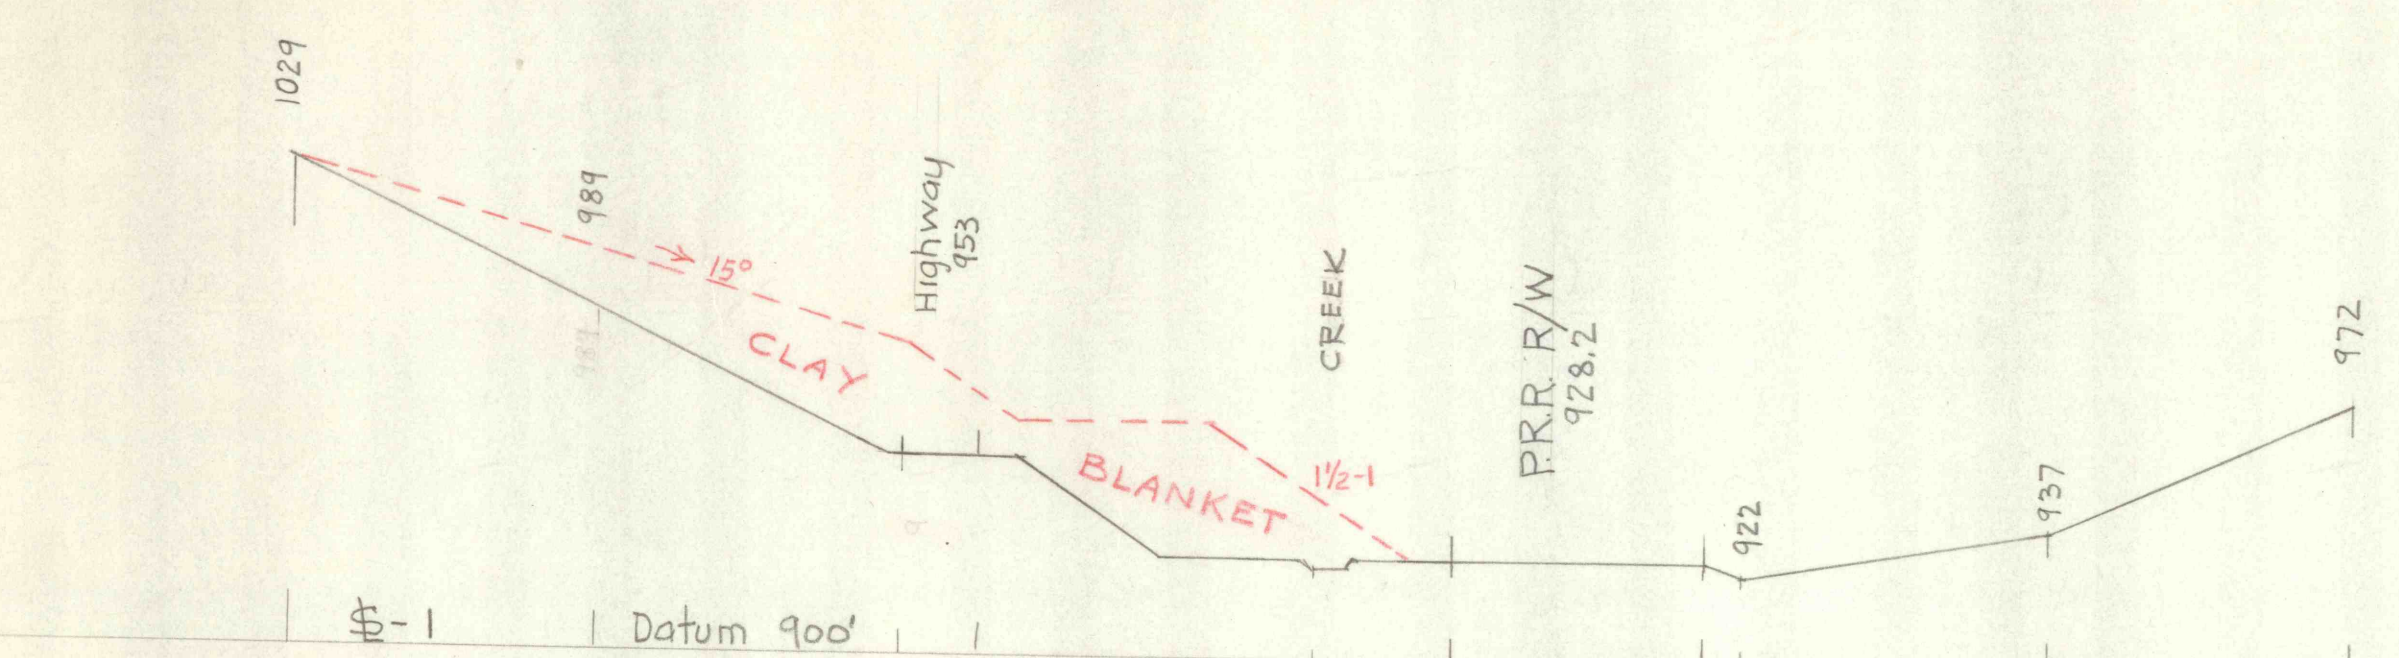

To Elev. Mine Water Pool - 720

TRENCH - Excavation - Cons.	281,000 Cu.Yds.
Backfill - Uncons.	70,300
BLANKET - Backfill - Clay	89,000

CROSS-SECTIONS - Portion COAL RUN FIRE AREA - East of Village, under L.R. 49085.
Looking East Scale 1"=50'
Pottsville, Pa. October 19, 1961.
Revised October 10, 1962
PENNSYLVANIA DEPARTMENT - MINES & MINERAL INDUSTRIES

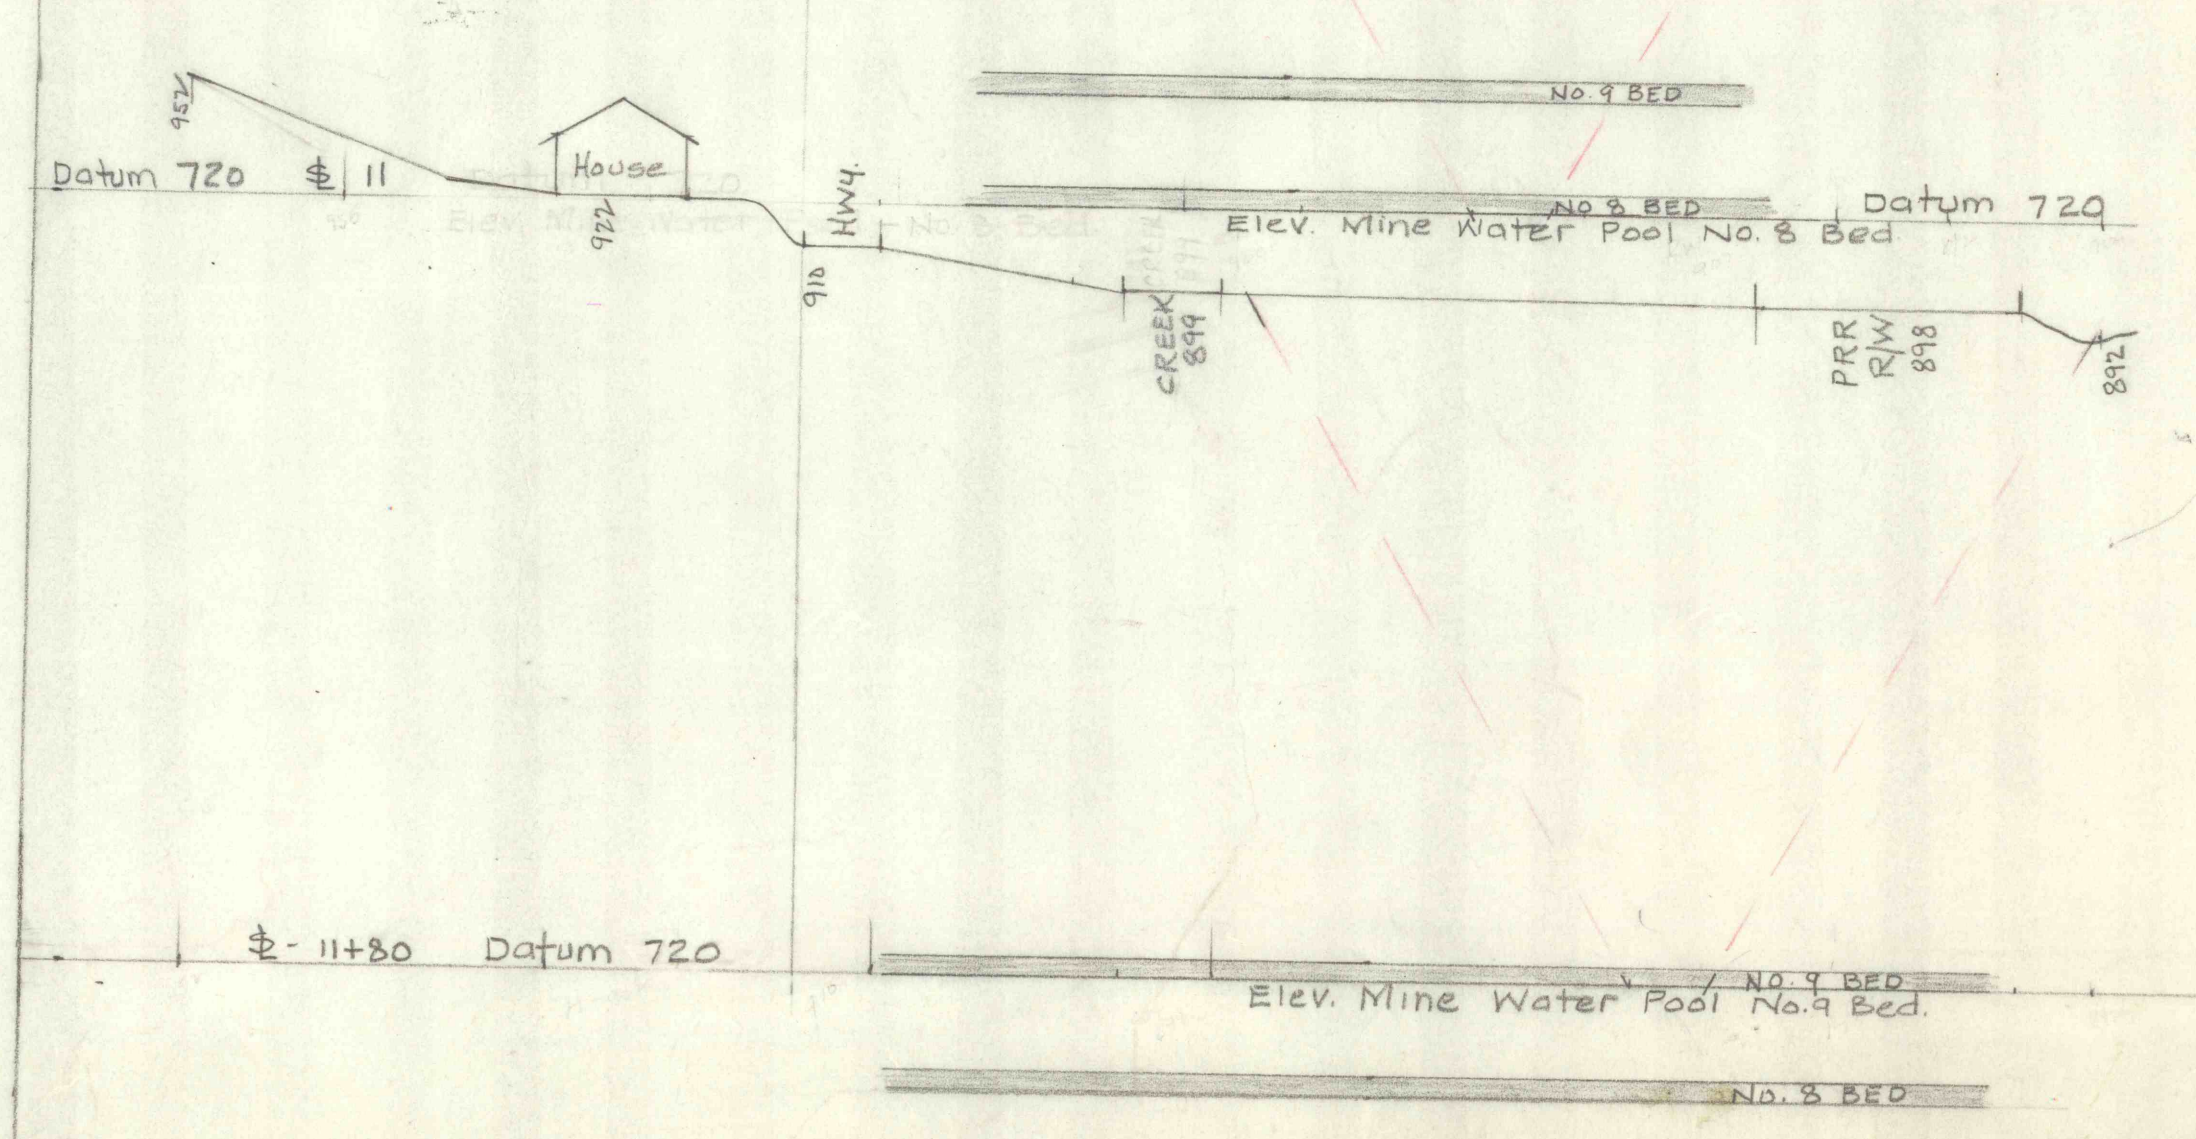

COAL RUN