


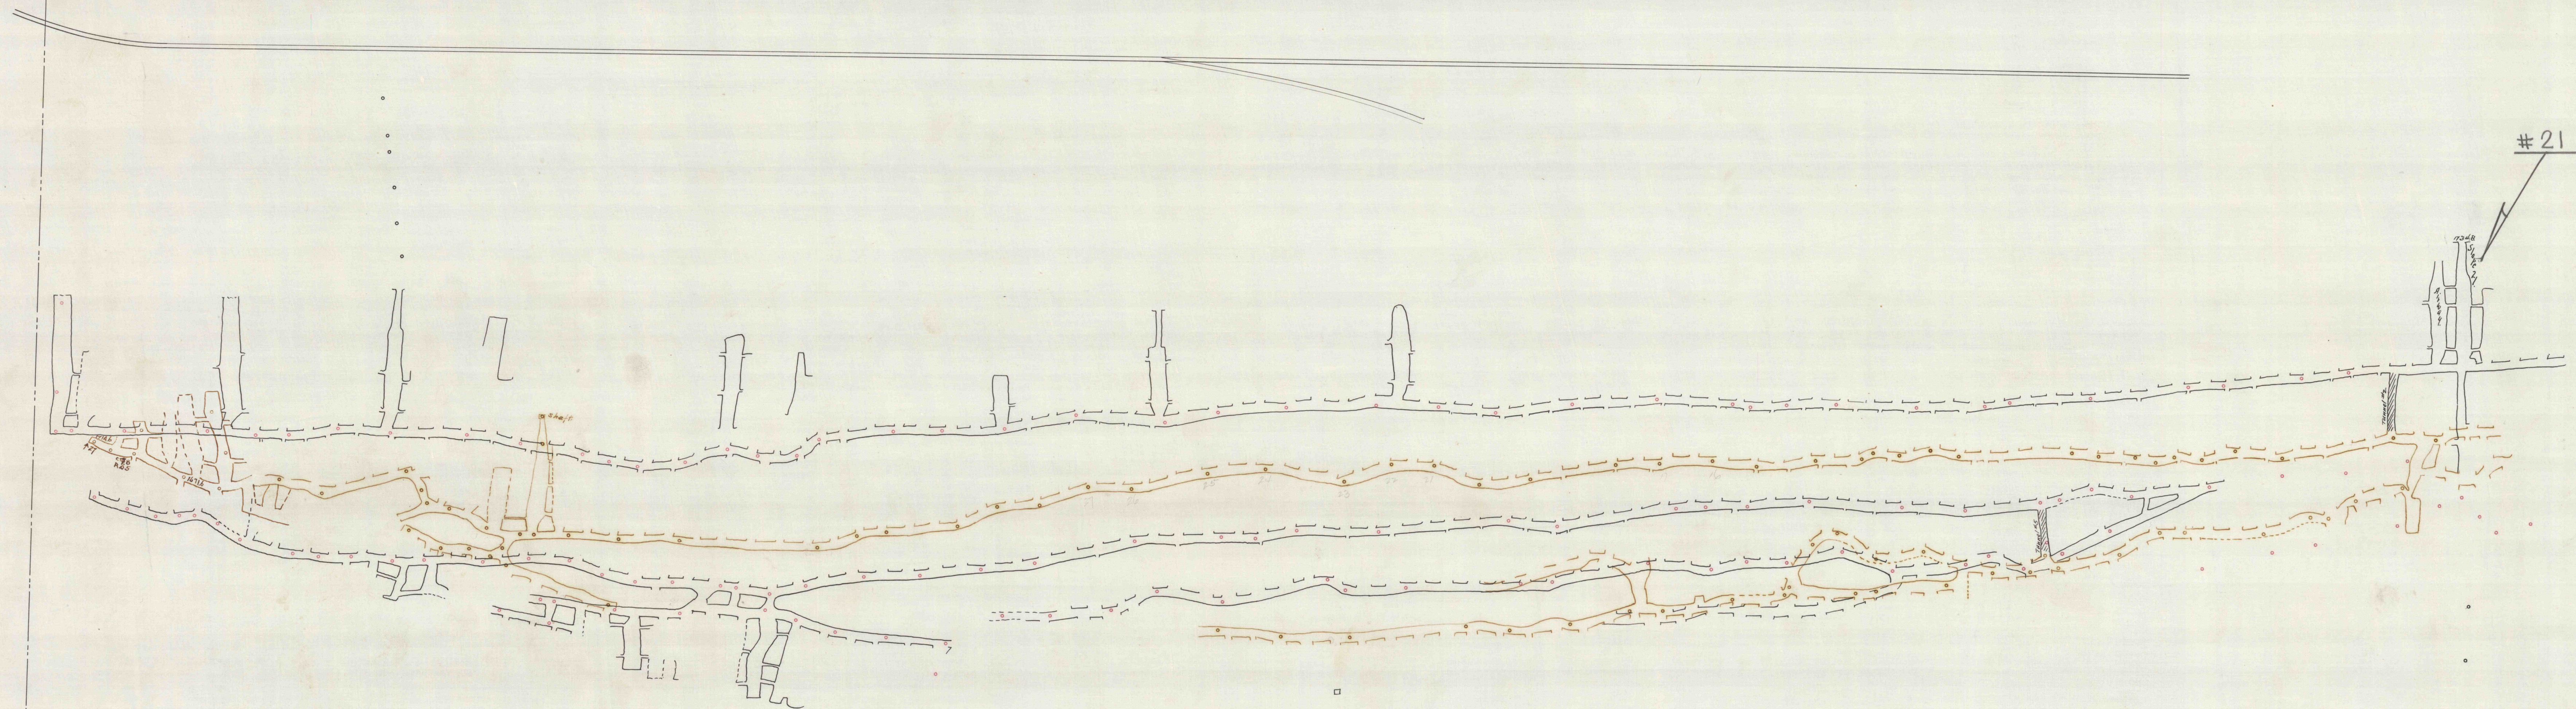

..EASTERN MIDDLE FIELD..

HARWOOD COLLIERY.: SLOPE no: 21.. Buck Mtn.; Gamma Veins,

HAZLE TWP., LUZERNE COUNTY PA., 8-HAZLETON DIST., 1"=100'

MF 10 MARCH 1972. A.D.

MF 2/10/1972