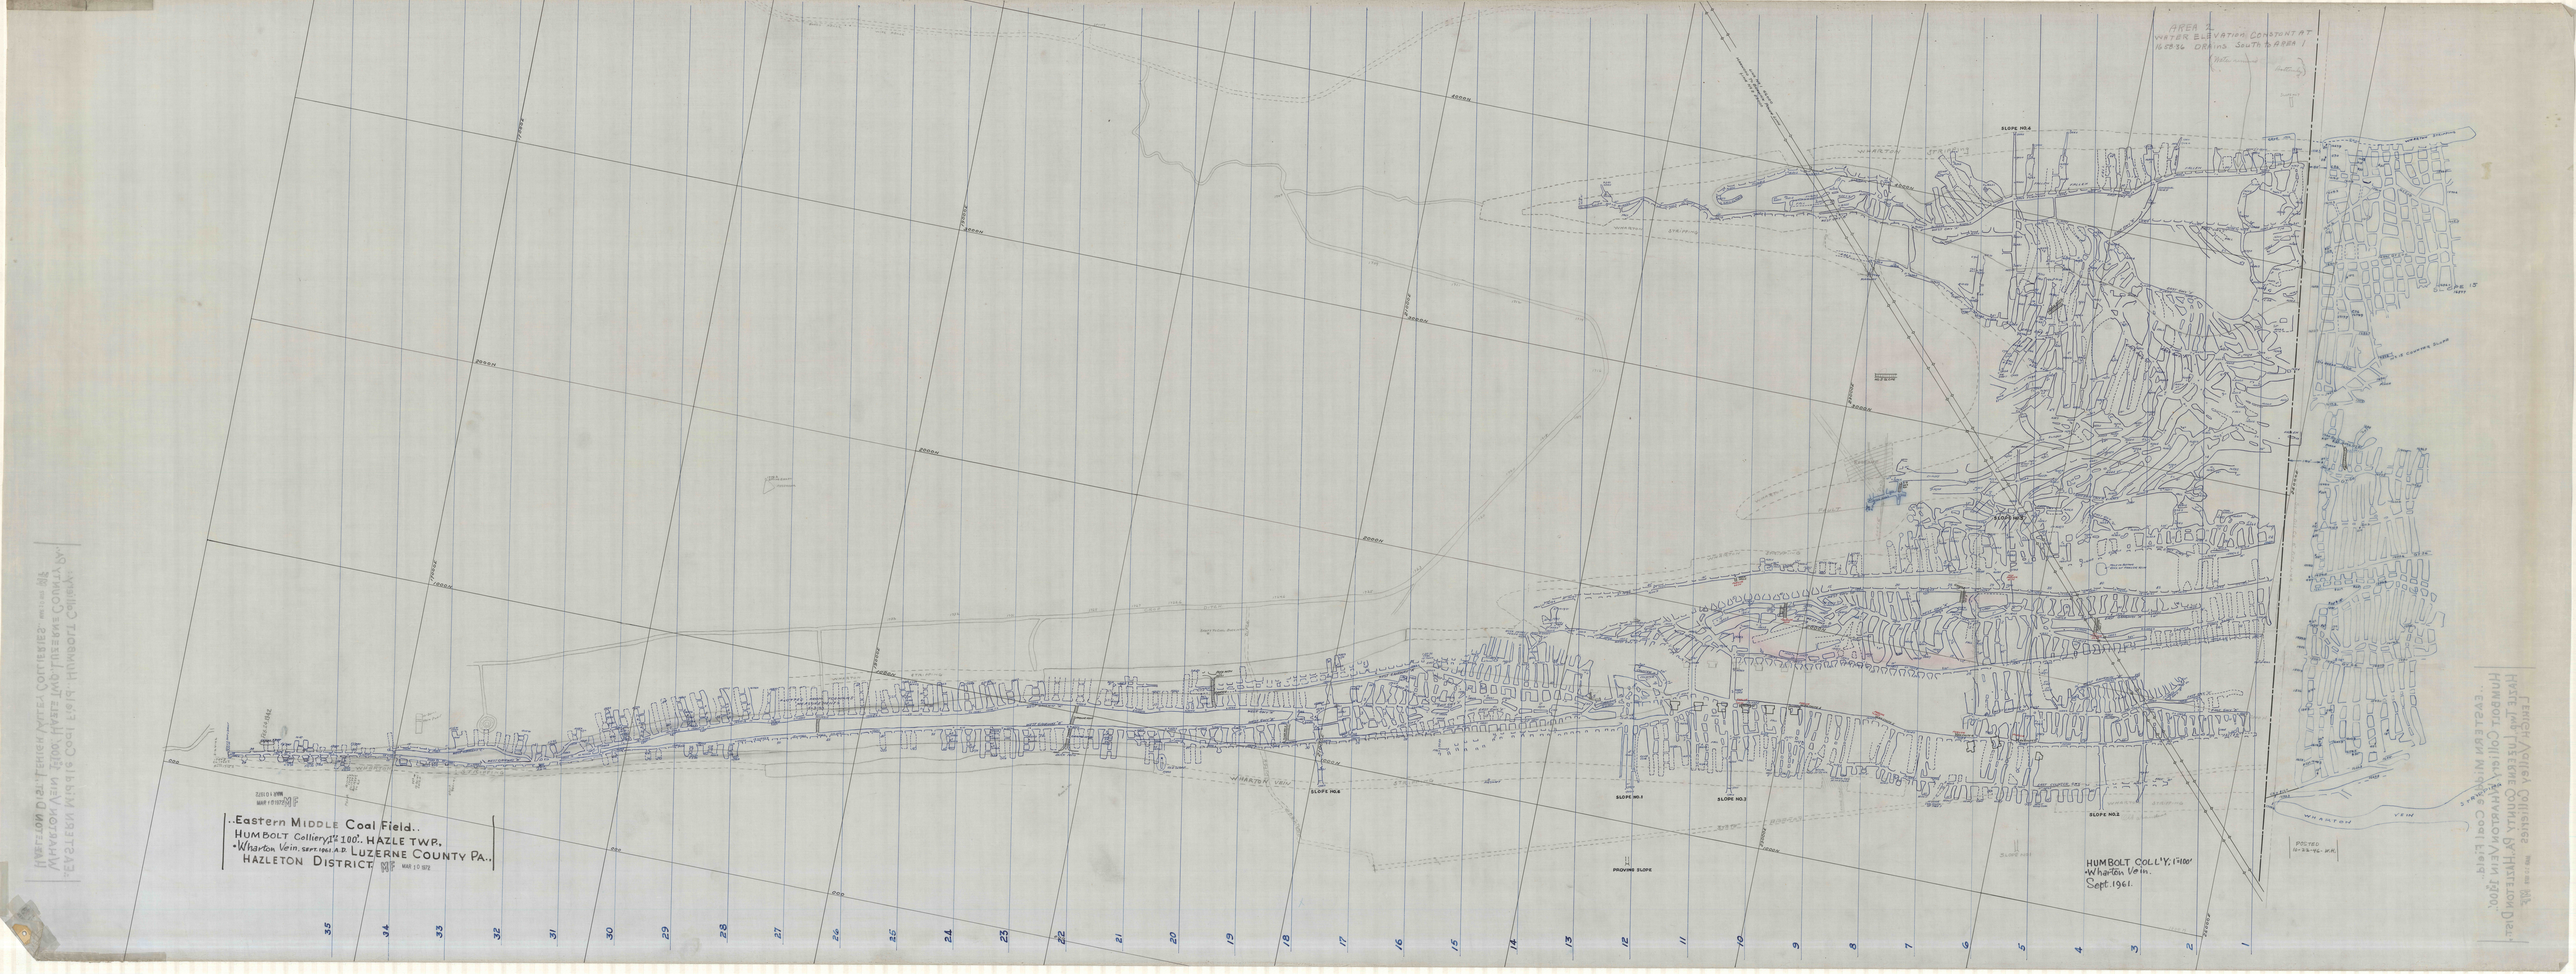
AREA 2
WATER ELEVATION CONSTANT AT 1658.36 DRAINS SOUTH to AREA 1
..Eastern Middle Coal Field..
Humbolt Colliery 1" = 100'. Hazle twp.
-Wharton Vein. Sept. 1961 A.D. Luzerne County Pa..
Hazleton District
HUMBOLT COLL'Y. 1"=100'
-Wharton Vein.
Sept. 1961.
SLOPE NO.4
SLOPE NO.3
SLOPE NO.2
SLOPE NO.1
SLOPE NO.0
WHARTON VEIN
PROVING SLOPE
WHARTON VEIN - HAZLE TWP. LUZERNE COUNTY PA.
HAZLETON DISTRICT - SEPT. 1961 A.D.
HUMBOLT COLLIERY (WHARTON VEIN)
HAZLE TWP. LUZERNE COUNTY PA. HAZLETON DIST.
EASTERN MIDDLE COAL FIELD