


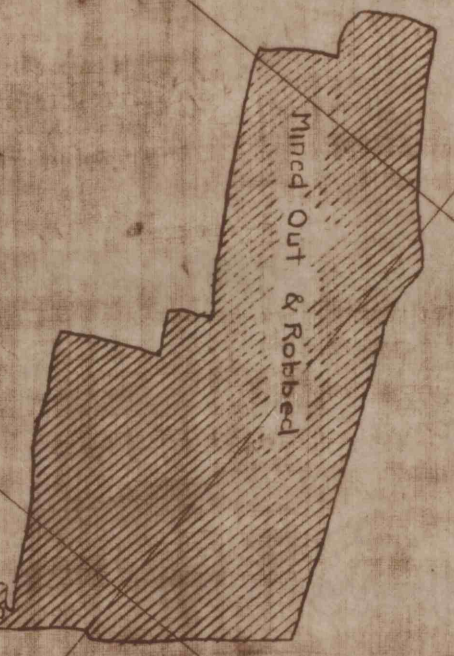

WM MOORE TRACT

PRICE PANCOAST & THROOP TRACT

TRACT




PANCOAST & THROOP

D. L. & W. R. R. CO.

D. & H. R. R. CO.

D. & H. R. R. CO.

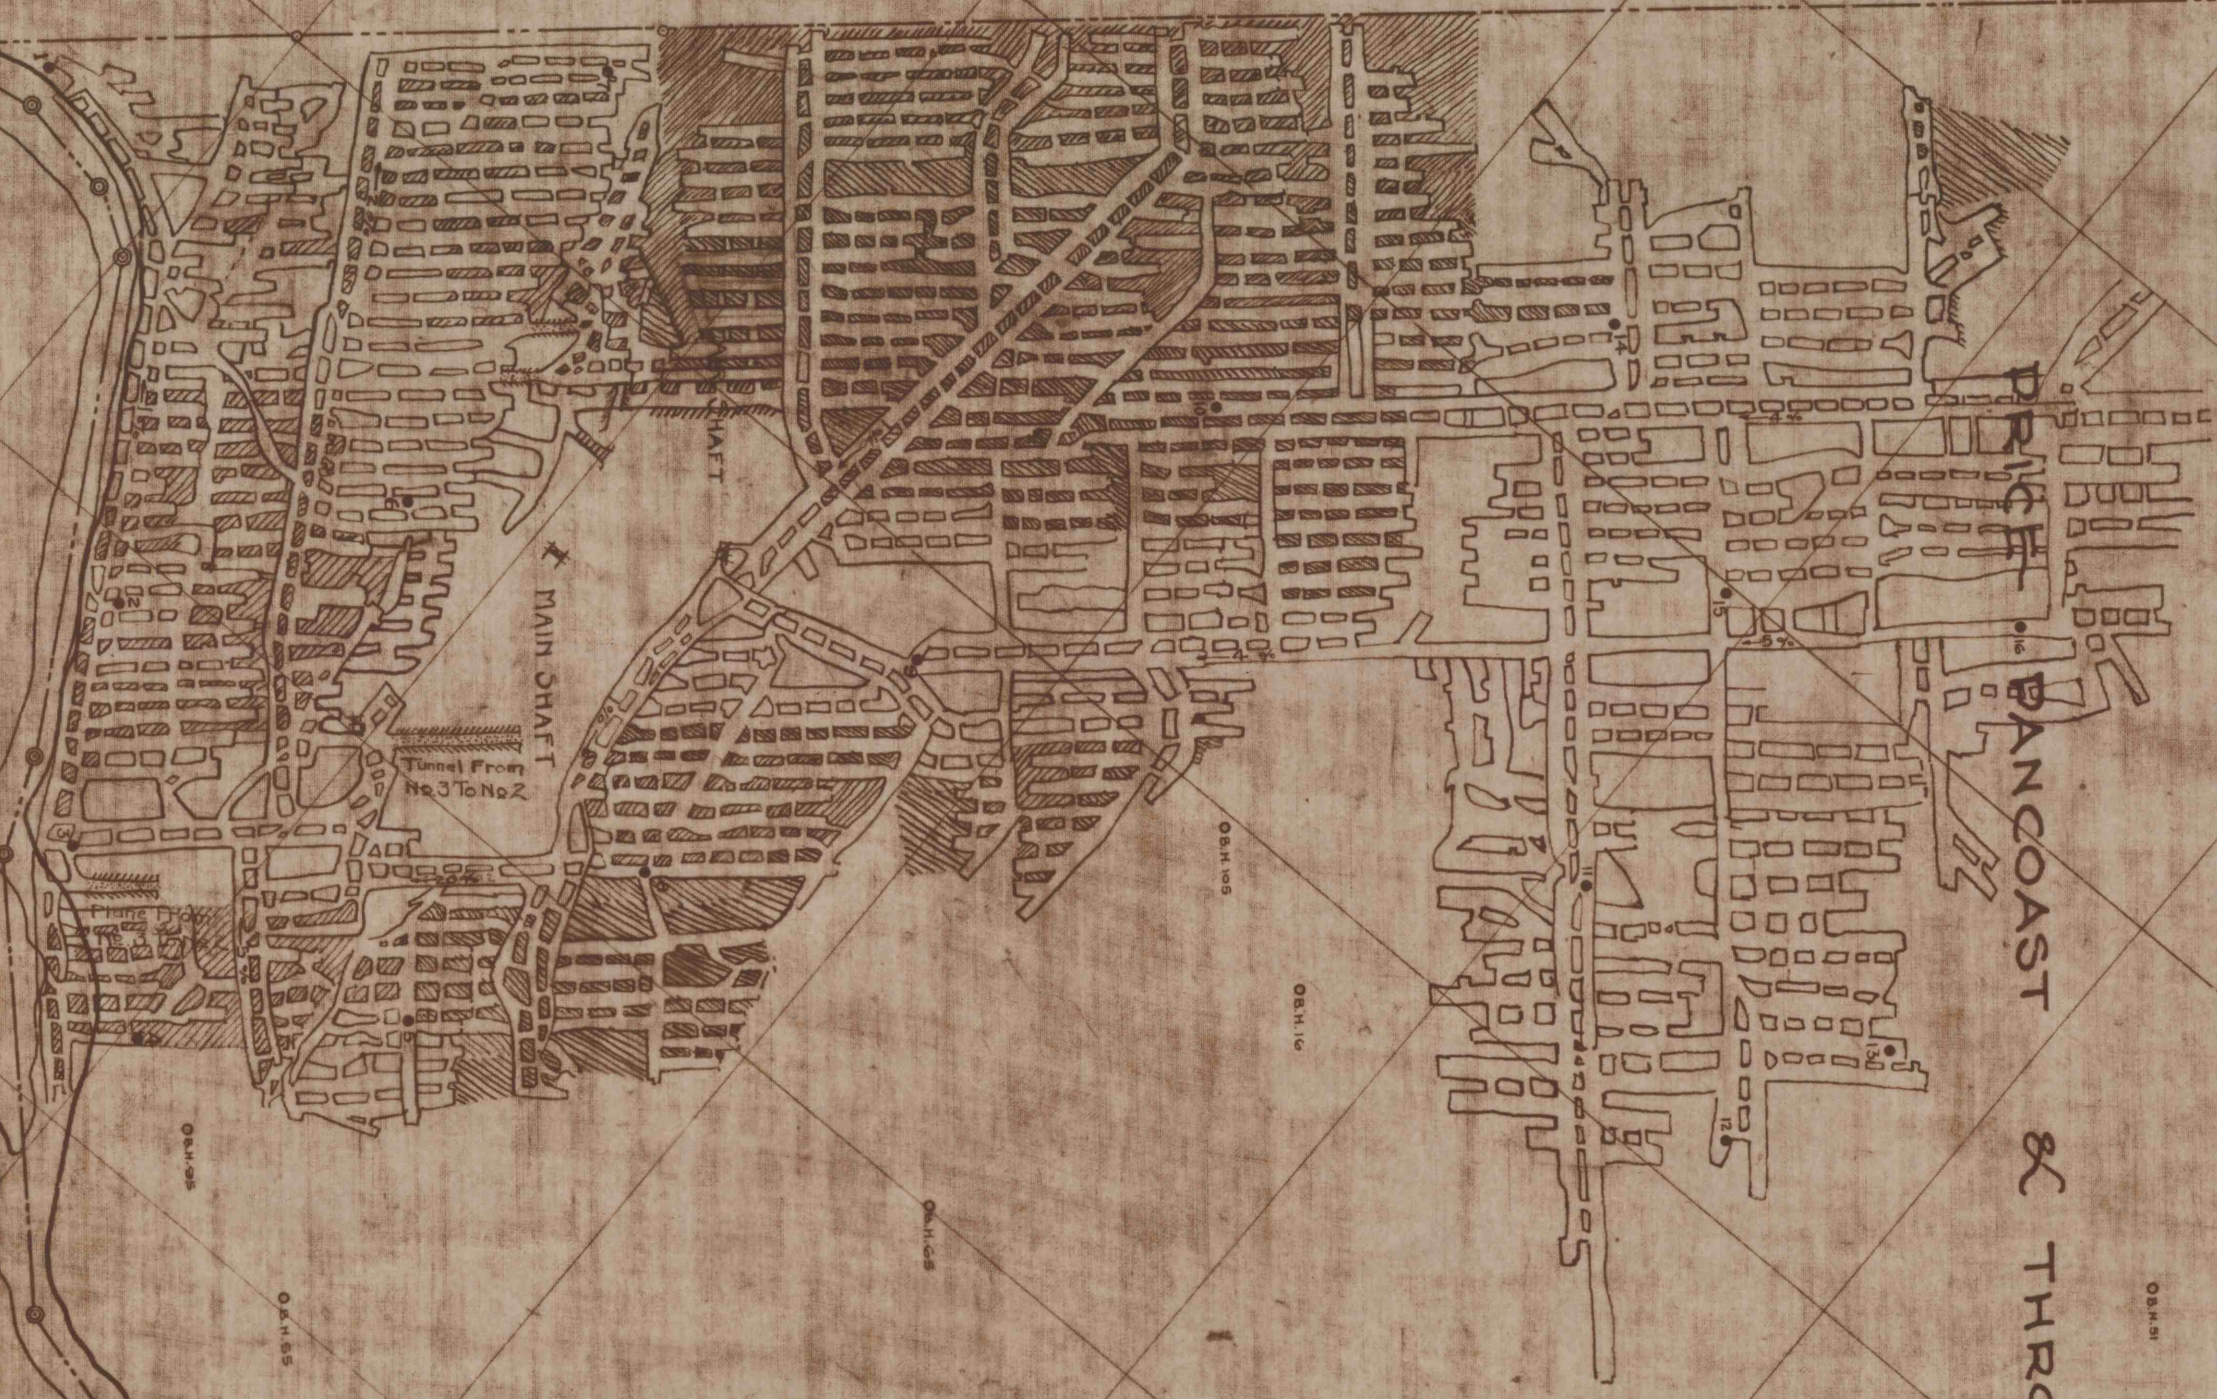

CRIPPEN TRACT

DUNMORE No 2 VEIN
JOHNSON COLLIERY
SCRANTON COAL COMPANY
PRICEBURG, PA. SCALE 400' TO 1"