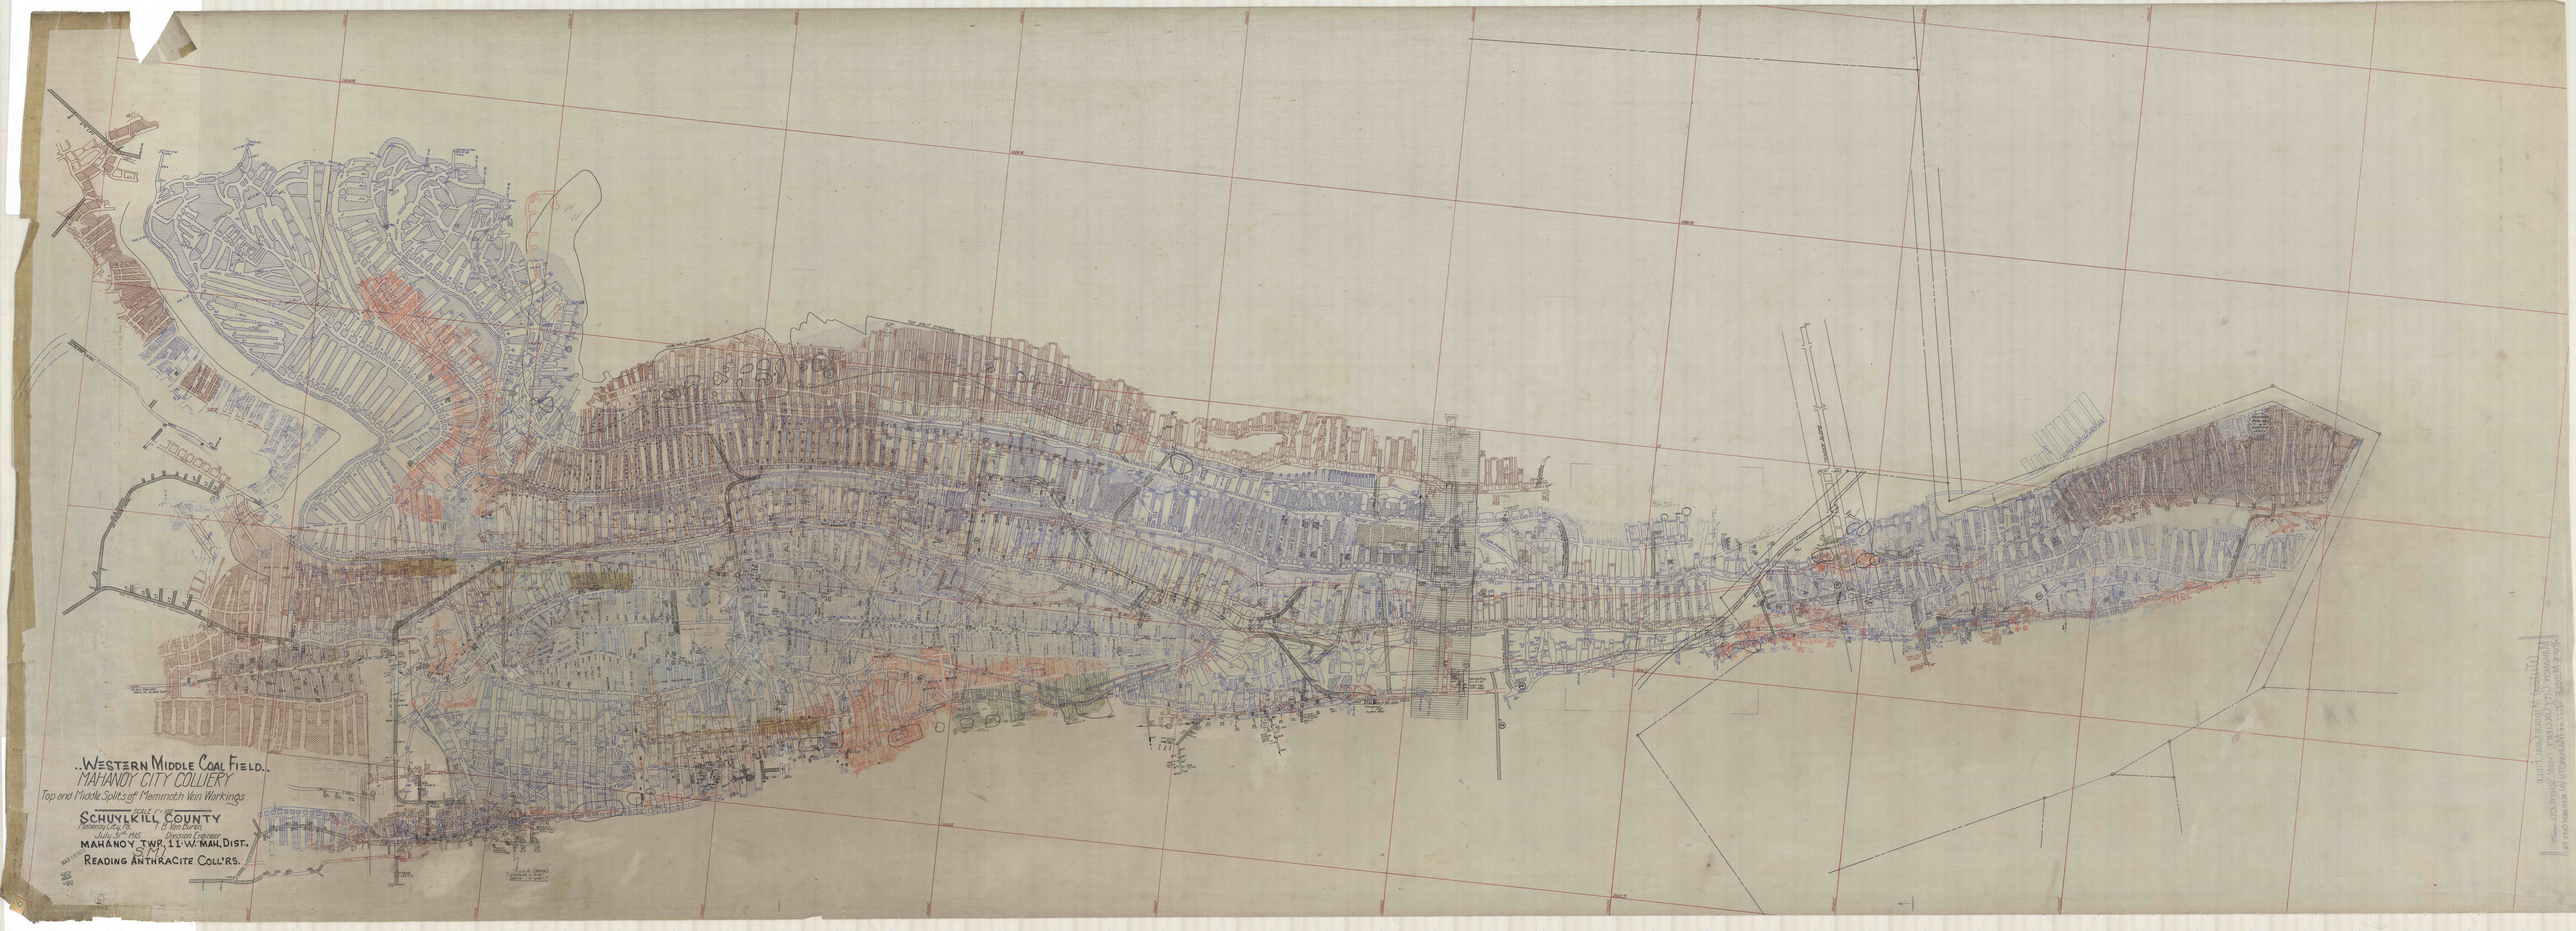

..WESTERN MIDDLE COAL FIELD..
MAHANOY CITY COLLIERY
Top and Middle Splits of Mammoth Vein Workings
SCHUYLKILL COUNTY
MAHANOY TWP. 11 W. MAH. DIST.
