
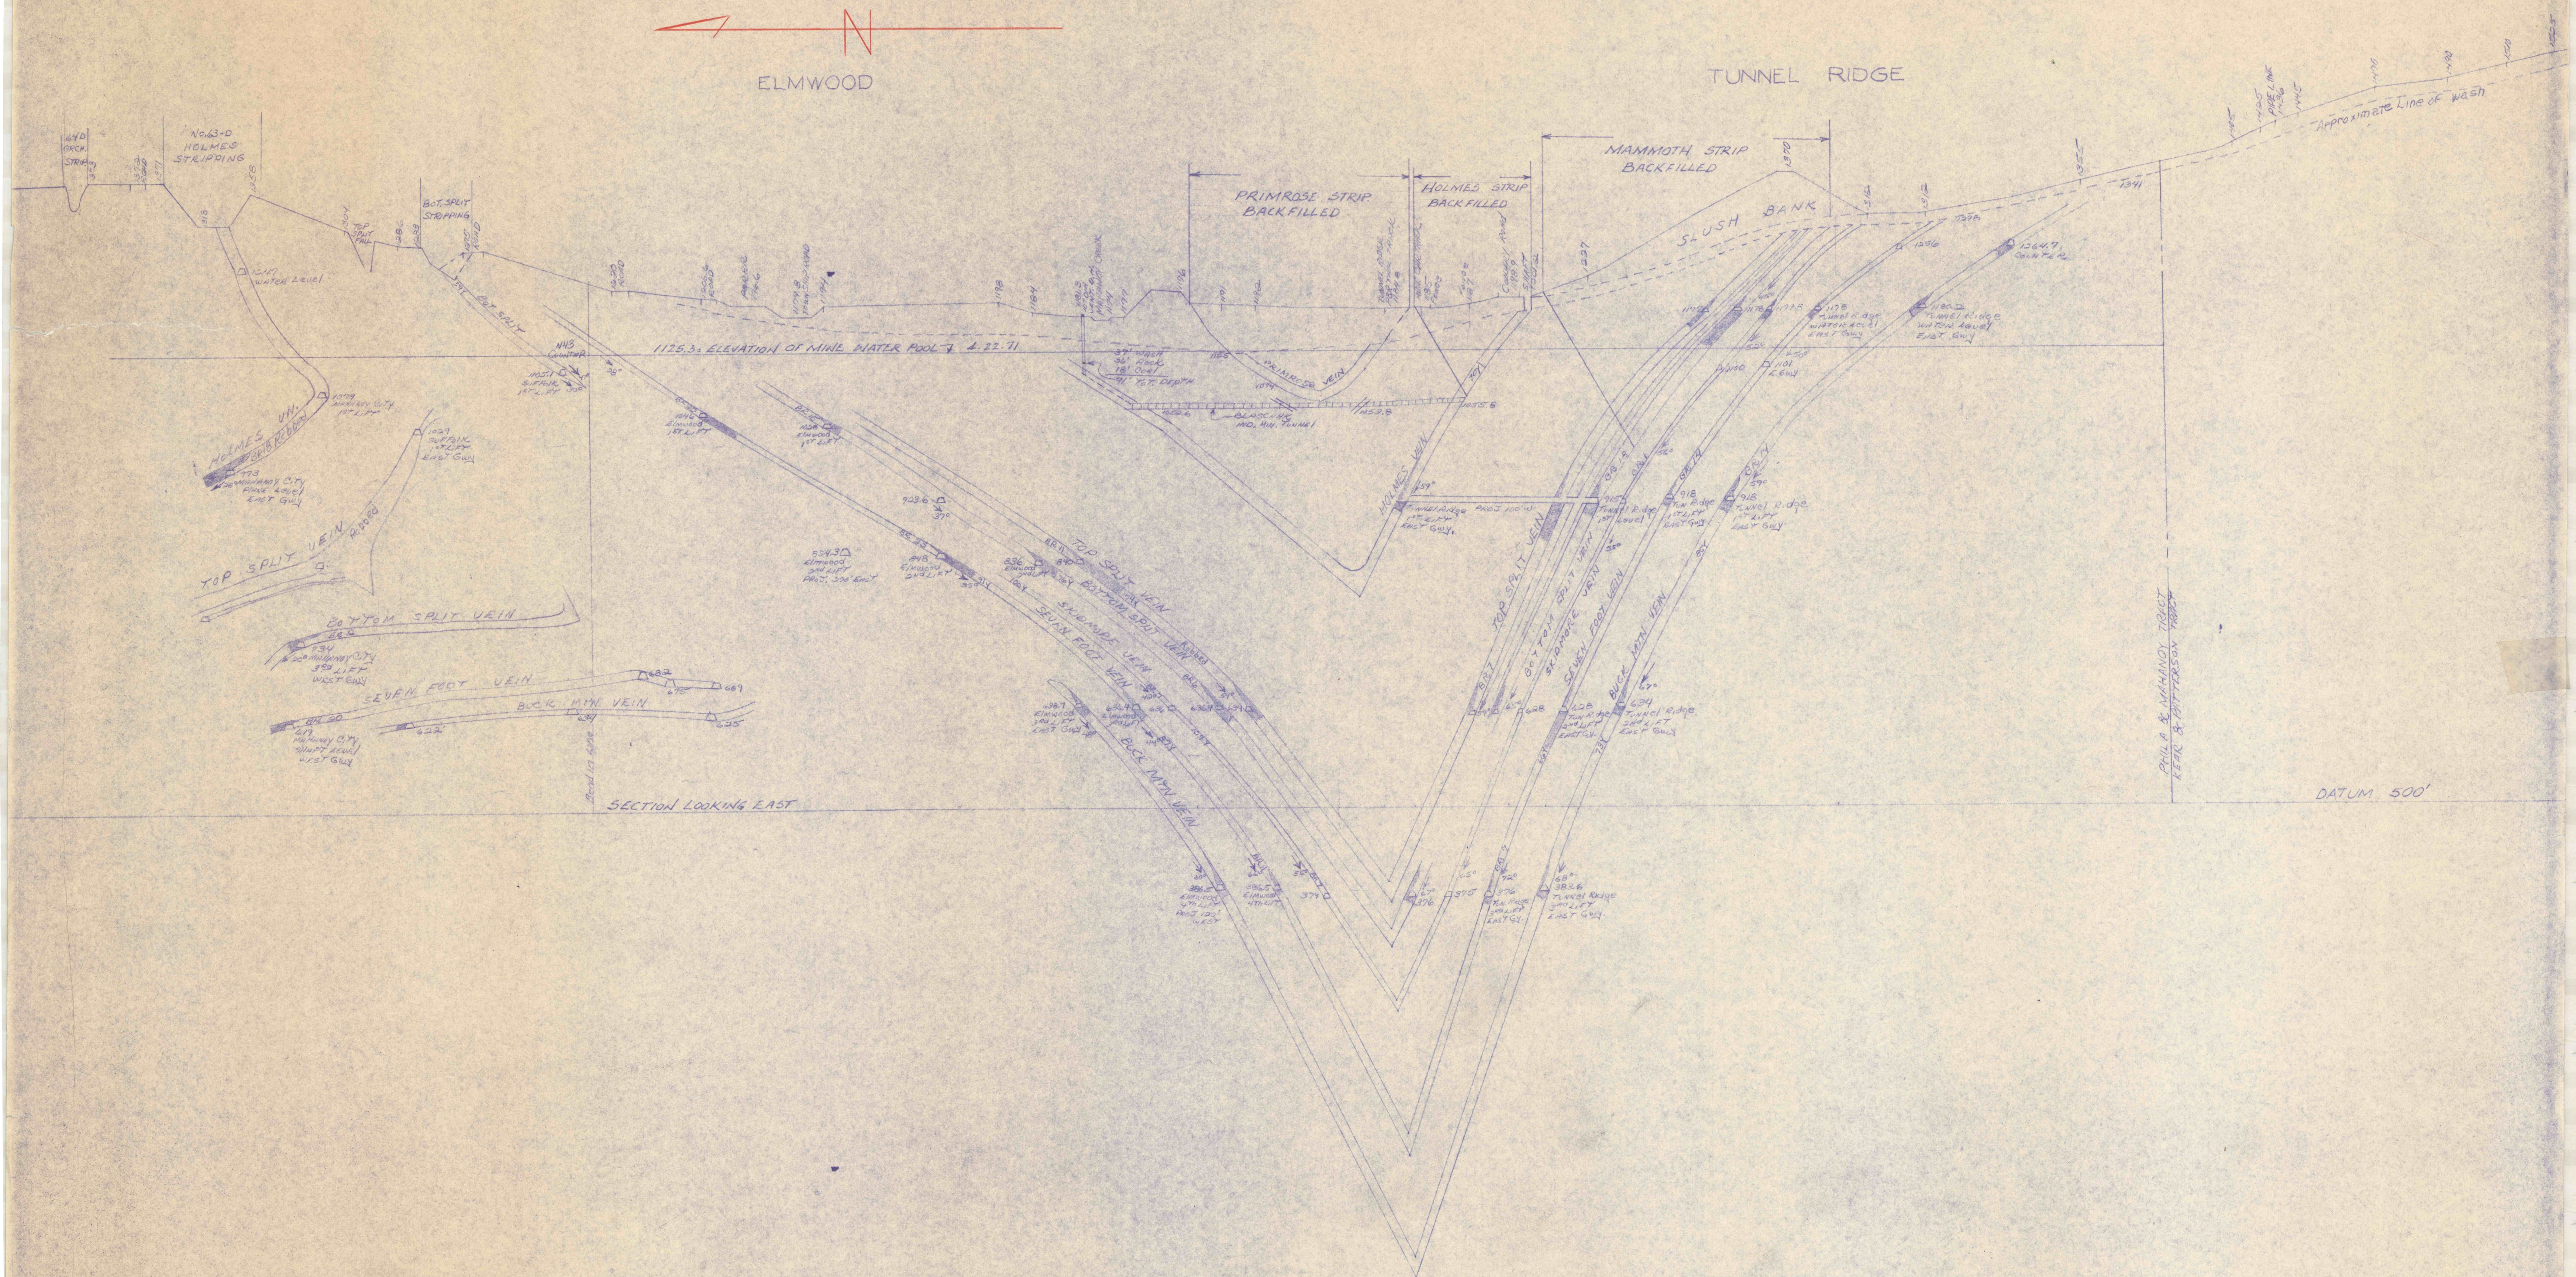


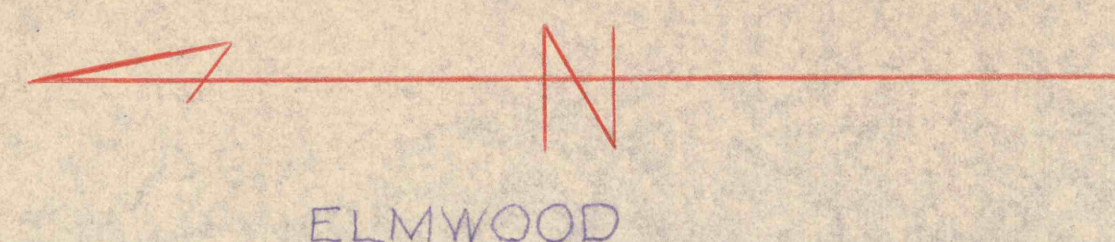

..2-OF-5..

CROSS SECTION — 1124

1850' East of Knickerbocker No. 4 Main Hoisting Slope
690' West of Elmwood Tender Slope

Mahoney City, Pa.
October 1913
Through Schuylkill No. 4 Underground Slope
670' East of Tunnel Ridge Lykens Valley Tunnel

Scale 1"=100'

20 1/100/11
2011