


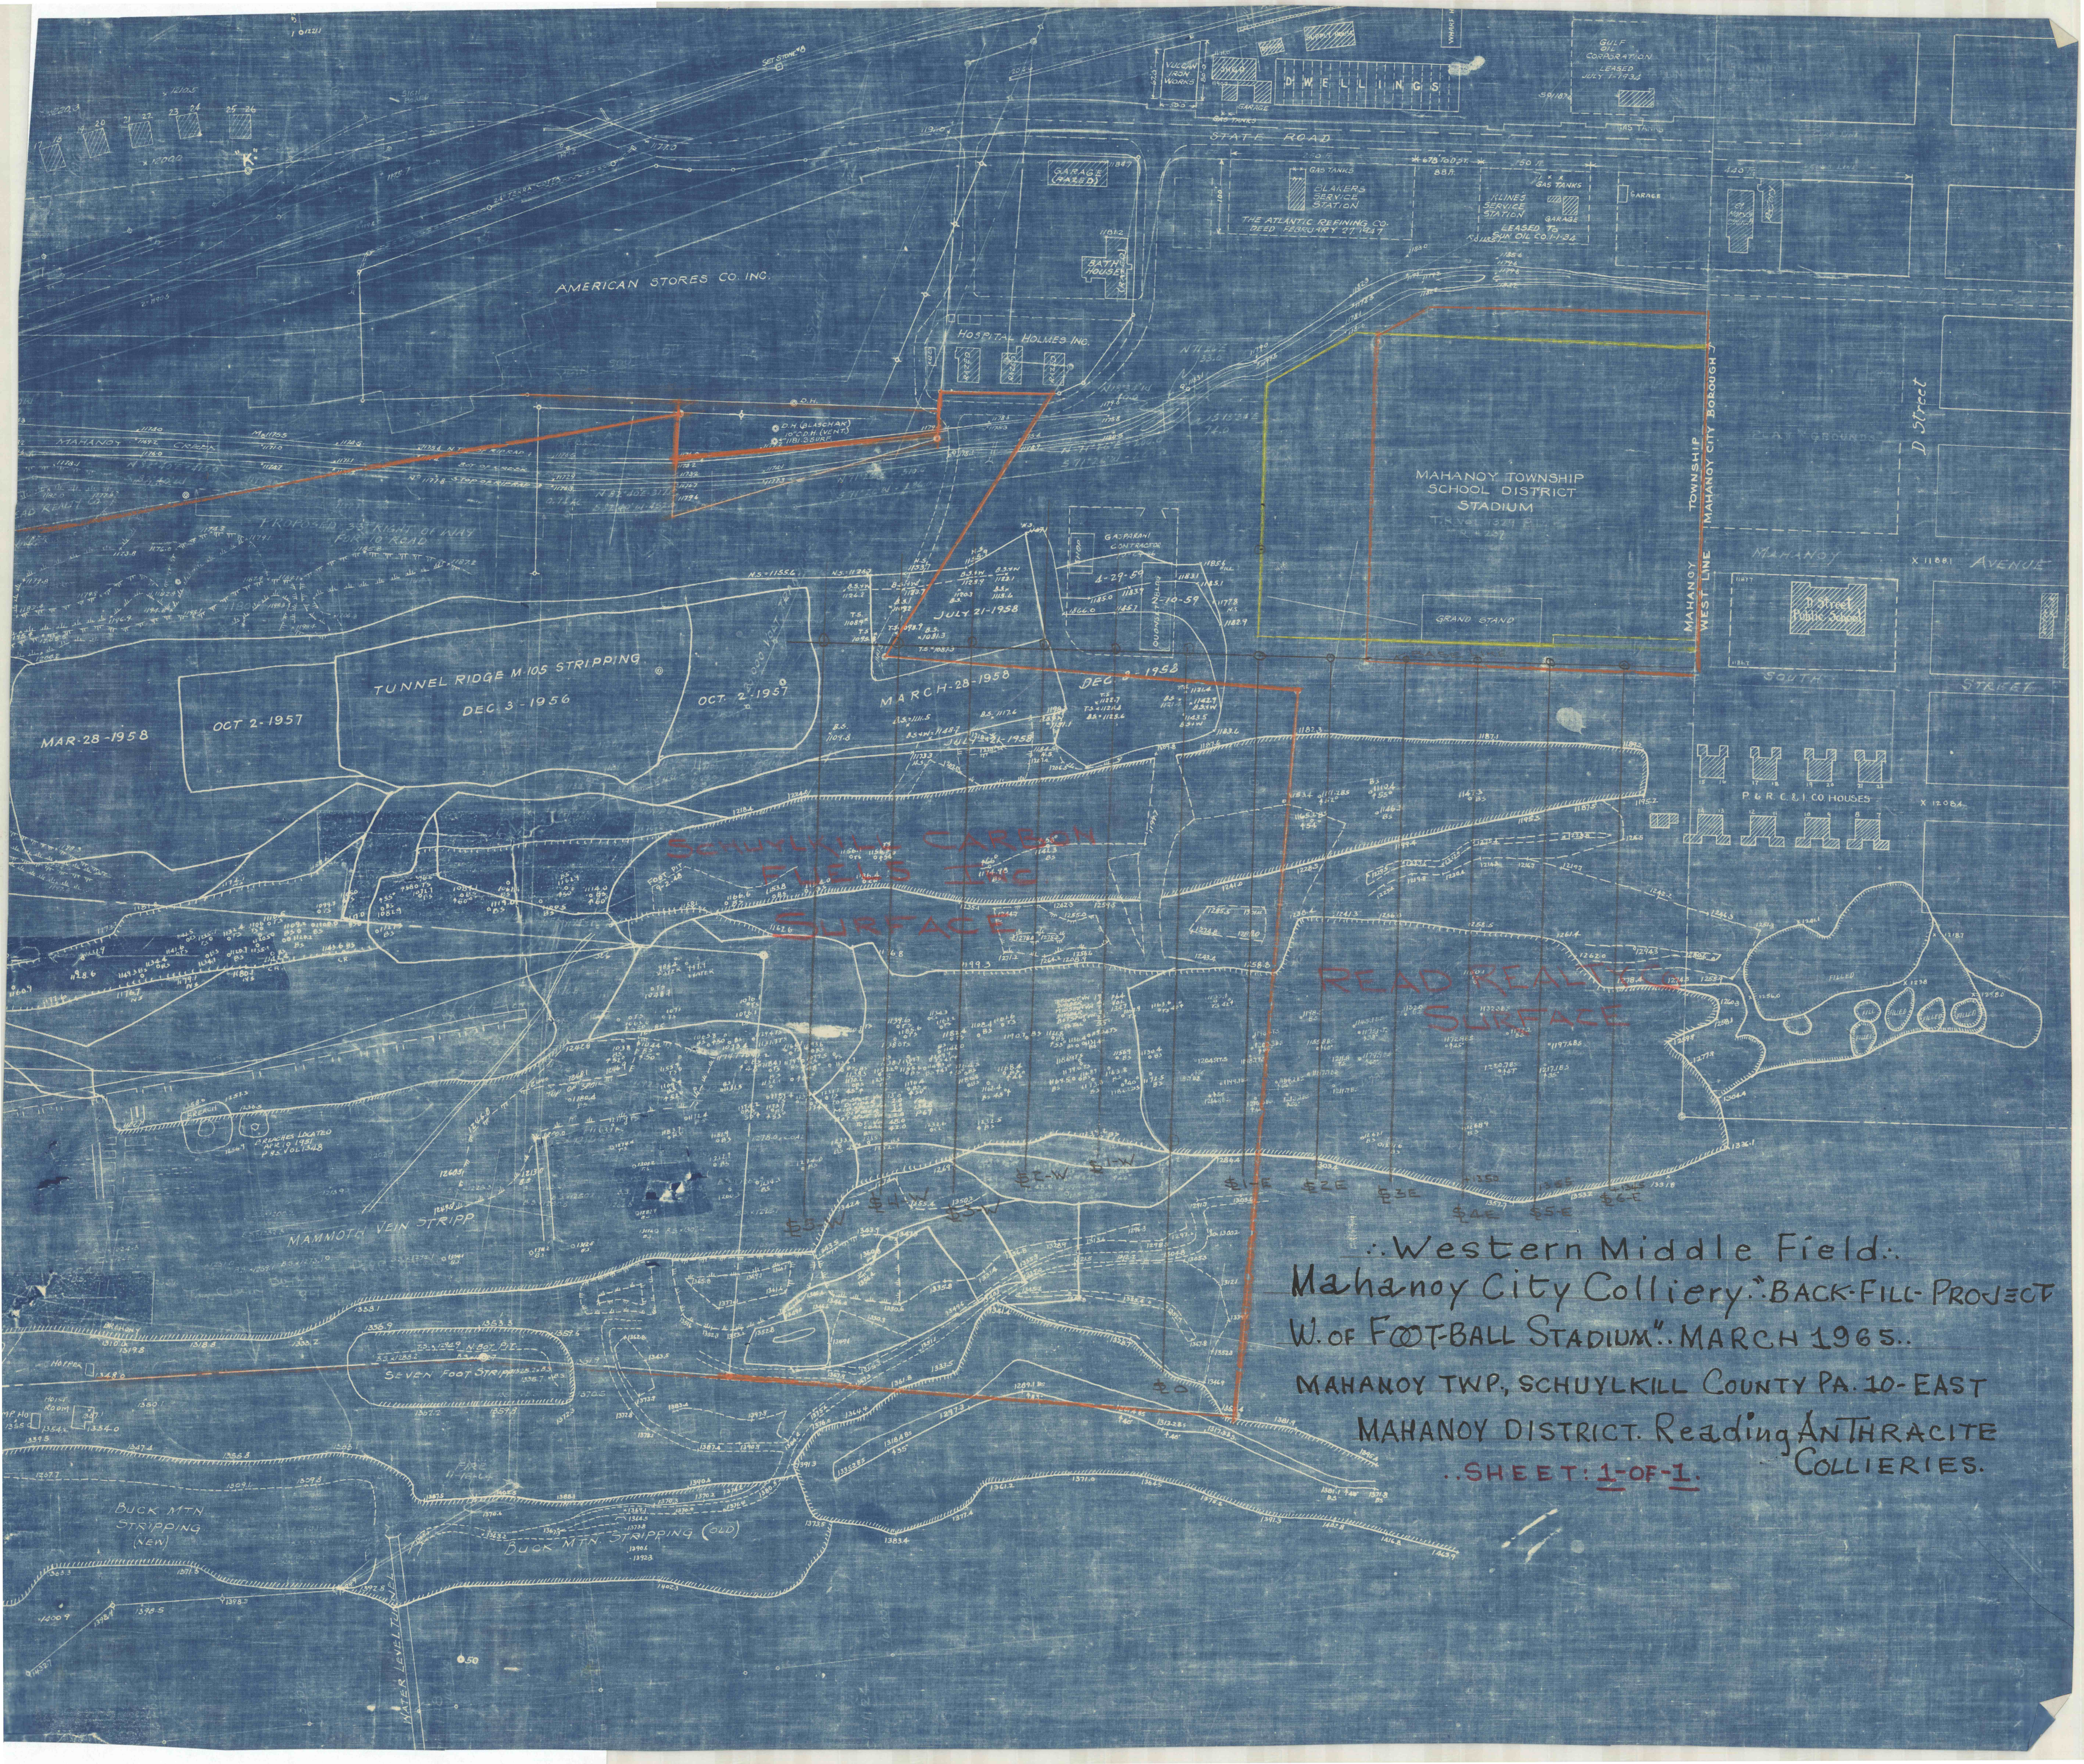

Western Middle Field:
Mahanoy City Colliery. BACK-FILL-PROJECT
W. OF FOOT-BALL STADIUM. MARCH 1965..
MAHANOW TWP, SCHUYLKILL COUNTY PA. 10- EAST
MAHANOW DISTRICT. Reading ANTHRACITE
COLLIERIES.
..SHEET: 1-OF-1.