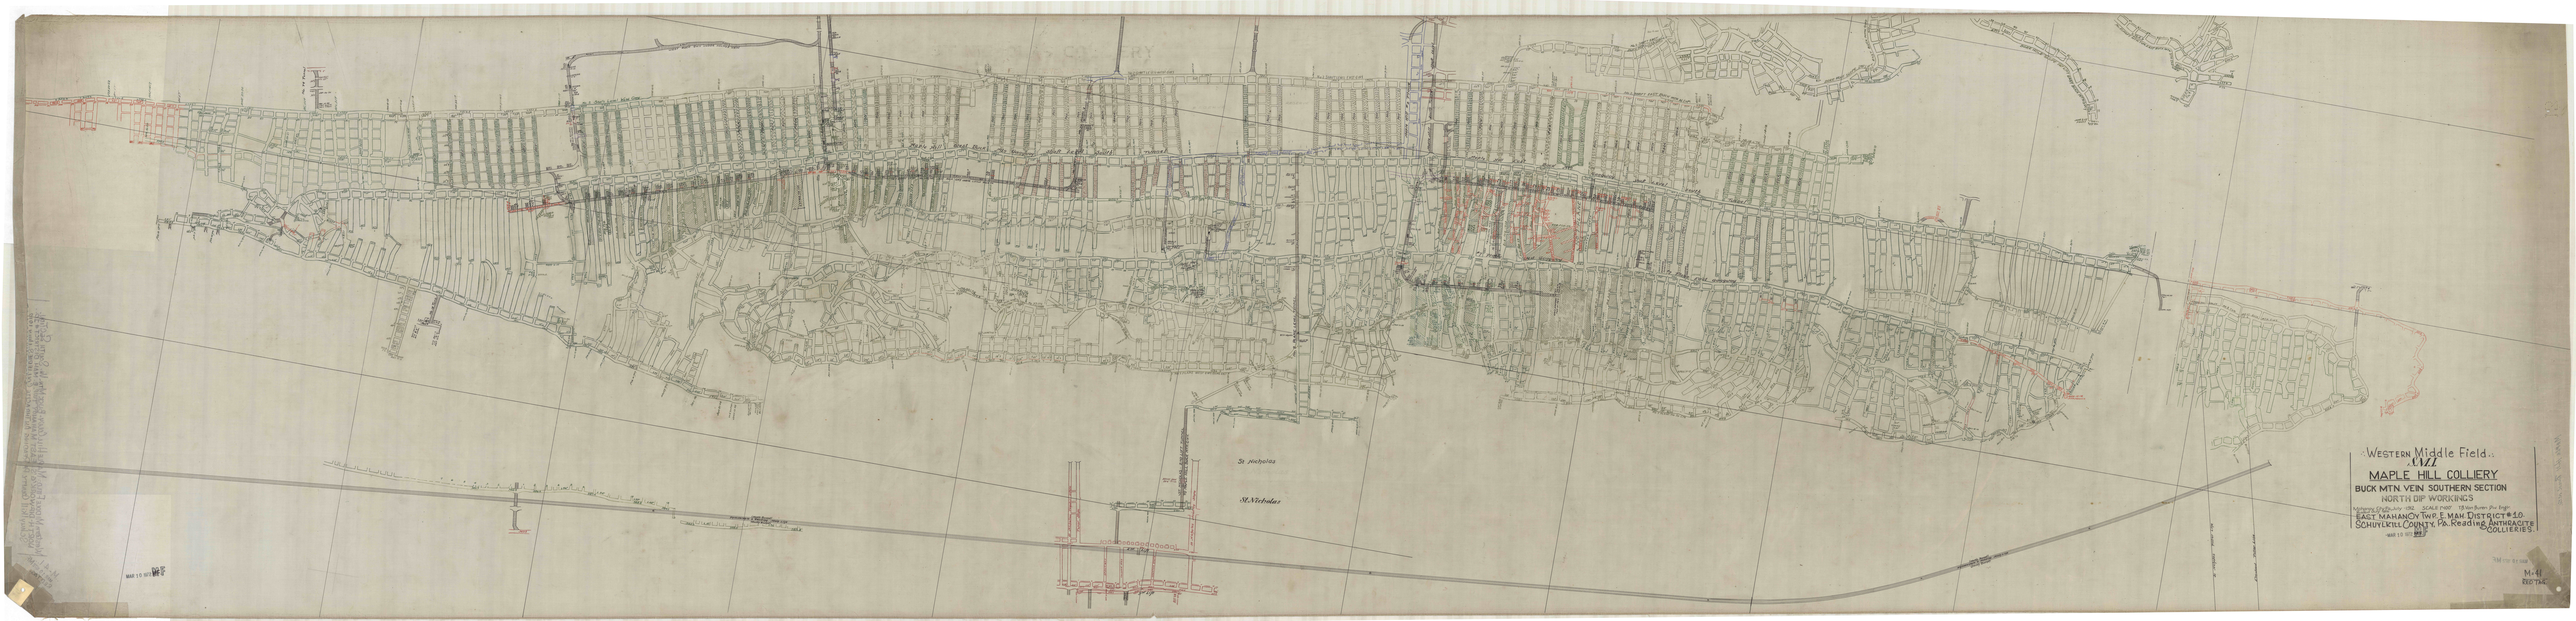
Western Middle Field.
MAPLE HILL COLLIERY
BUCK MTN. VEIN SOUTHERN SECTION
NORTH DIP WORKINGS
EAST MAHANOY TWP. E. MAH. DISTRICT # 10.
SCHUYLKILL COUNTY, PA. Reading ANTHRACITE COLLIERIES
St. Nicholas
St. Nicholas