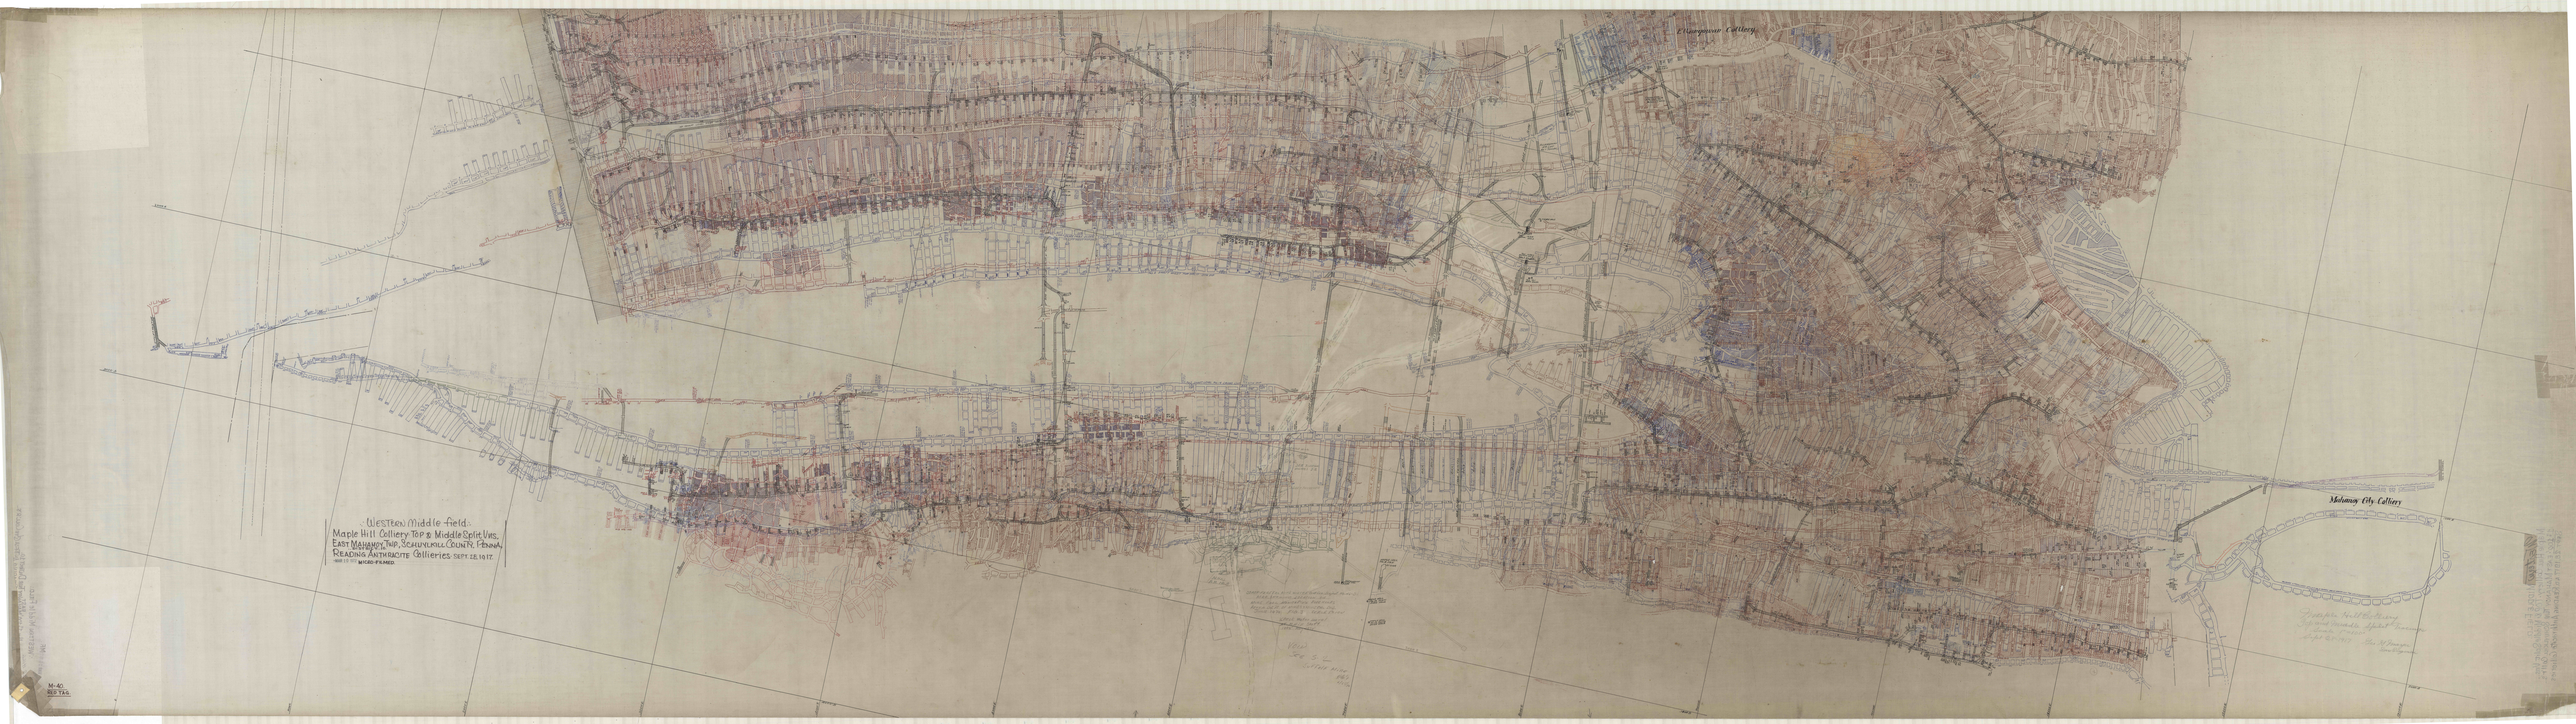

Western Middle field.
Maple Hill Colliery Top & Middle Split Vns.
East Mahanoy Twp. Schuylkill County, Penna.
Reading Anthracite Collieries. Sept 22. 1917.
MICRO-FILMED.
Mahanoy City Colliery