


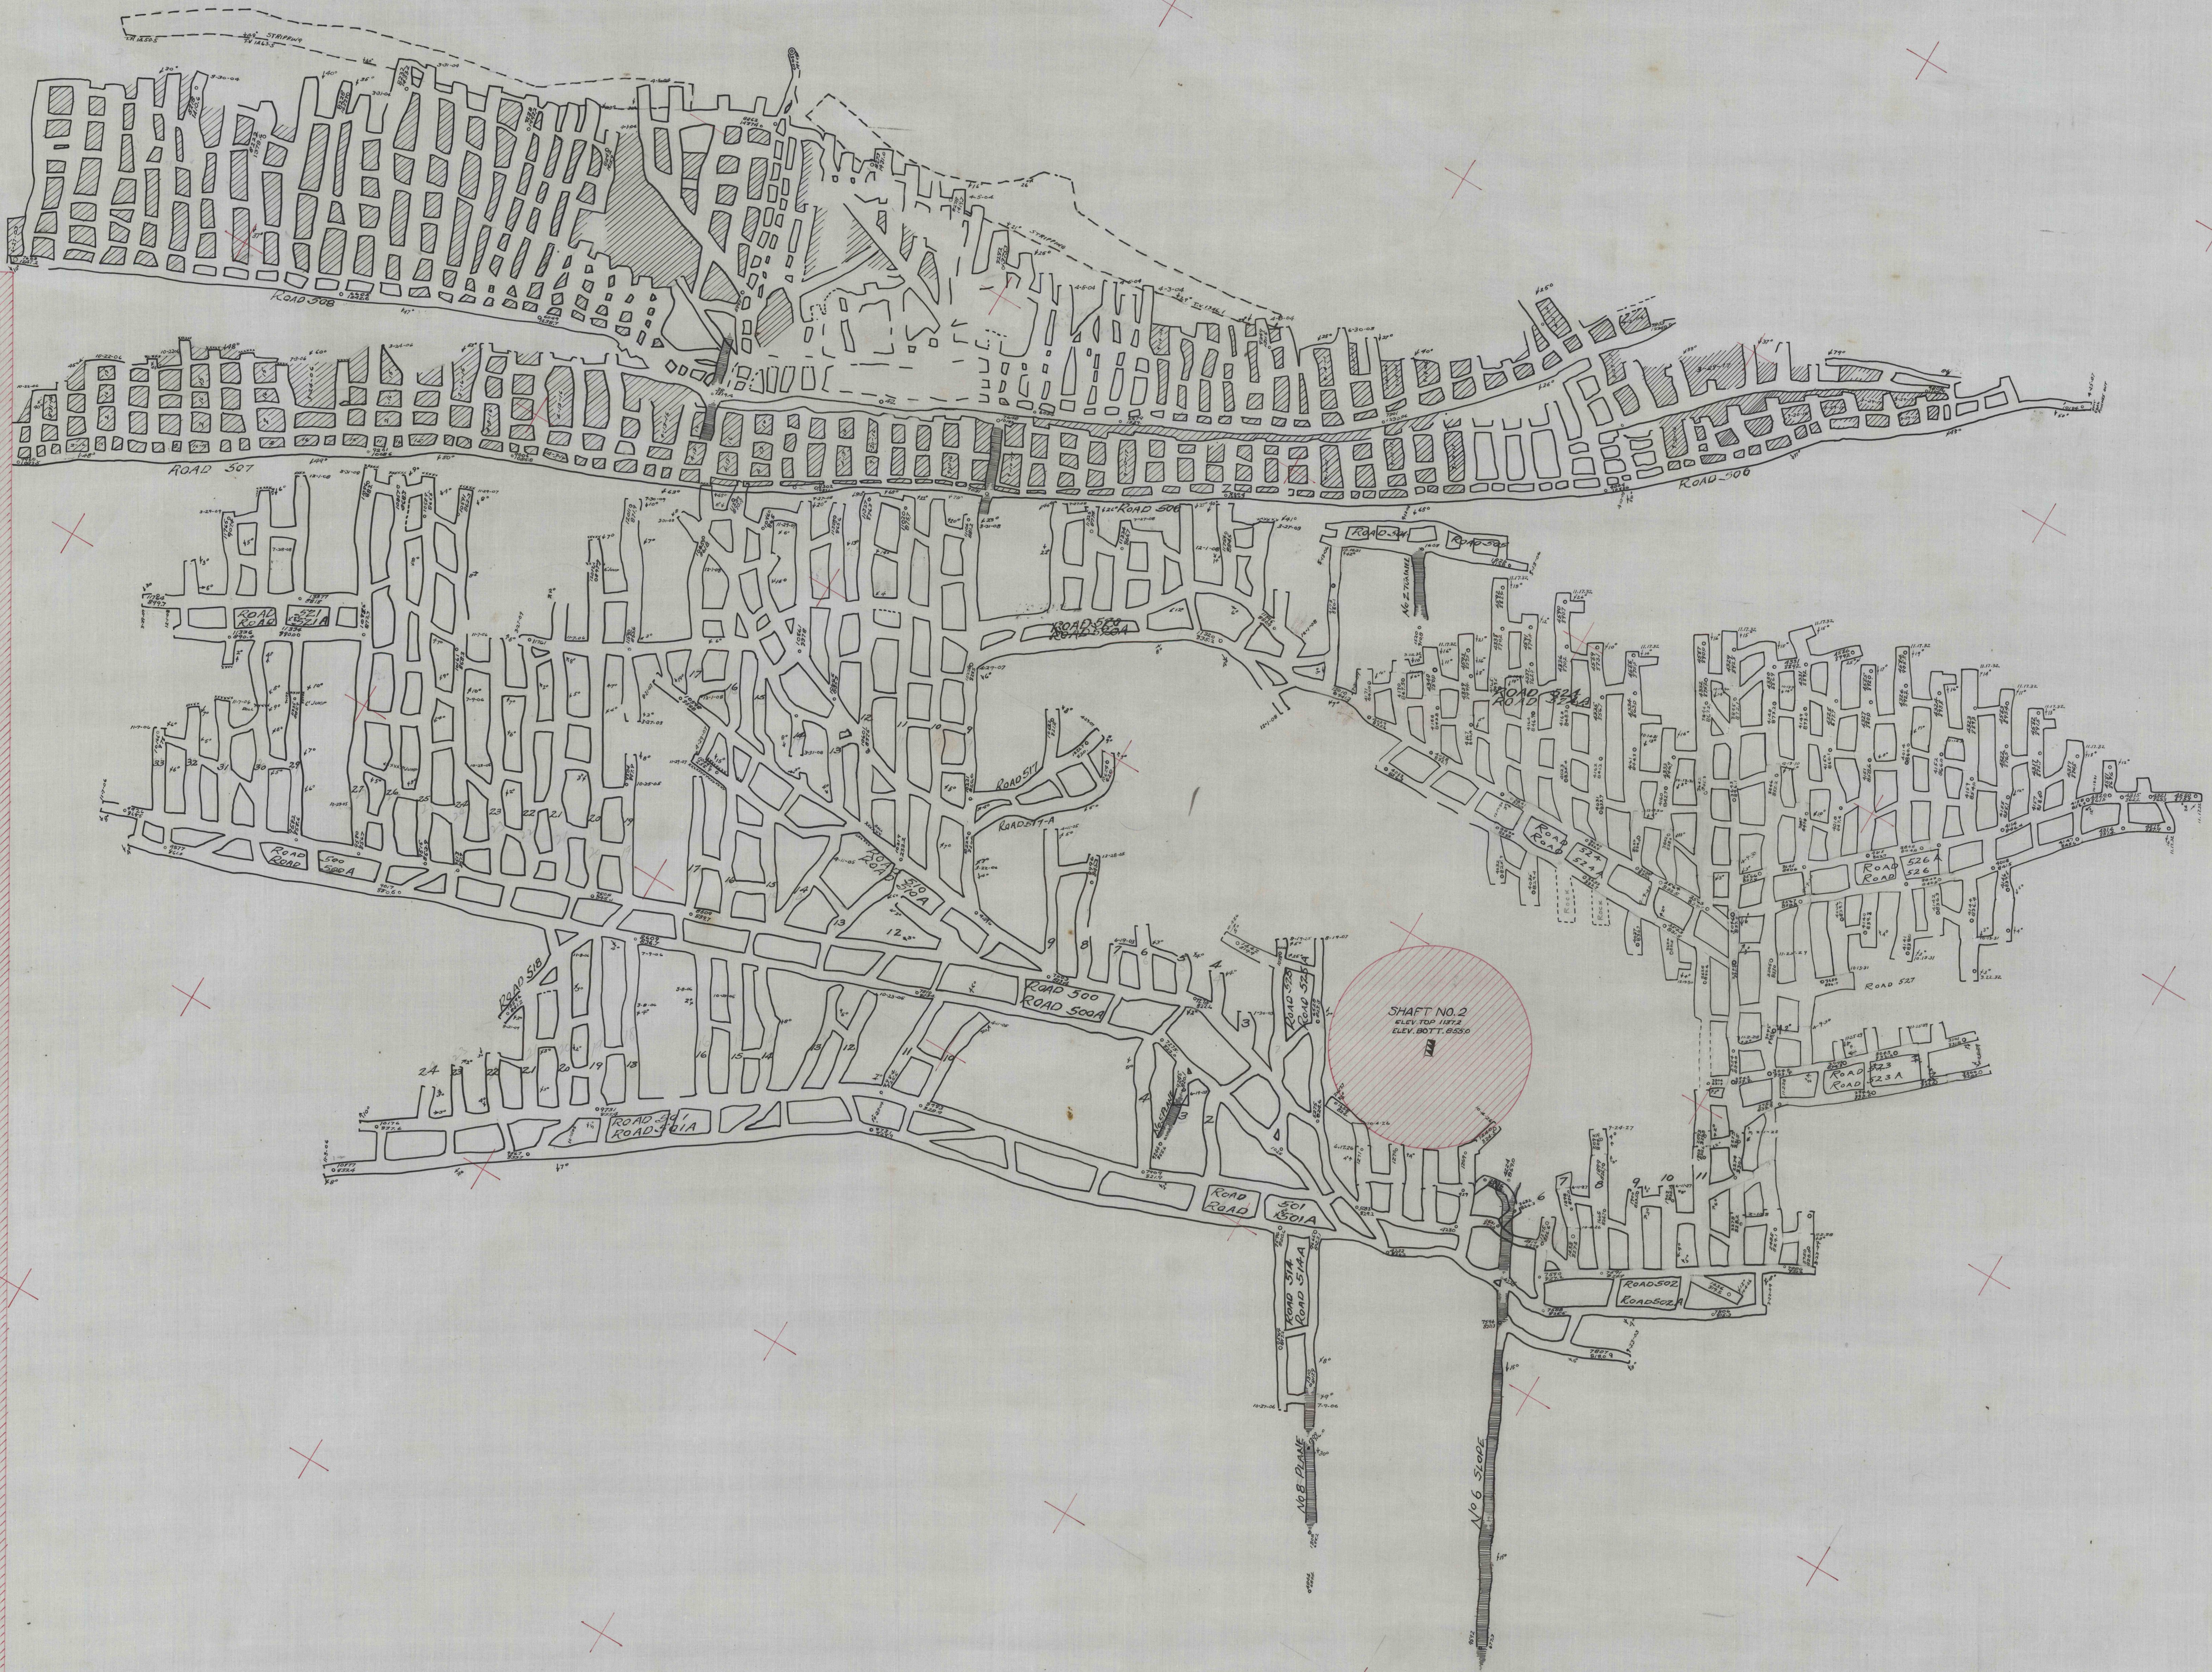

...NORTHERN COAL FIELD...
MALTBY COLLIERY
 5-PLYMOUTH DIST., LEHIGH VALLEY COAL CO.
 • **NINE FOOT VEIN**
 KINGSTON TWP., LUZERNE COUNTY.
 MINE INSPECTOR'S TRACING

DATUM 500' BELOW TIDE
 SCALE 1"=100'

POSTED					
YEAR	MONTH	BY	YEAR	MONTH	BY
1926	JAN.	J.S.O.			
1927	MAY	A.S.O.			
1928	FEB.	N.M.H.			
1928	Dec.	C.R.K.			
1929	Oct.	P.D.R.			
1930	June	C.M.Q.			
1931	March	C.R.L.			
1931	Dec.	C.R.K.			
1932	November	J.A.B.			
1933	May	J.A.B.			
1949	March	J.E.V.			
1951	April	R.H.C.			
1952	May	W.M.G.			