


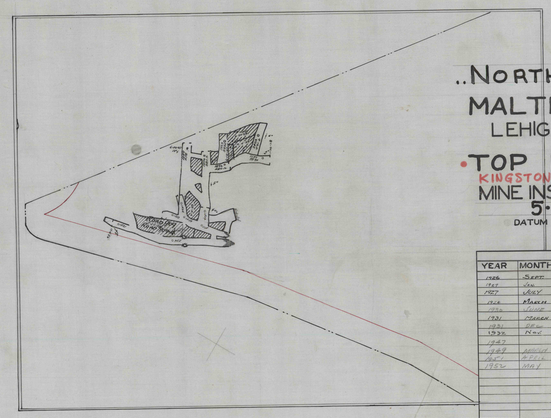

..NORTHERN COAL FIELD..

MALTBY COLLIERY

LEHIGH VALLEY COAL CO.

TOP MARCY VEIN

KINGSTON TWP. LUZERNE COUNTY

MINE INSPECTOR'S TRACING

5th PLYMOUTH DISTRICT.

DATUM 500' BELOW TIDE

SCALE 100'=1"

POSTED					
YEAR	MONTH	BY	YEAR	MONTH	BY
