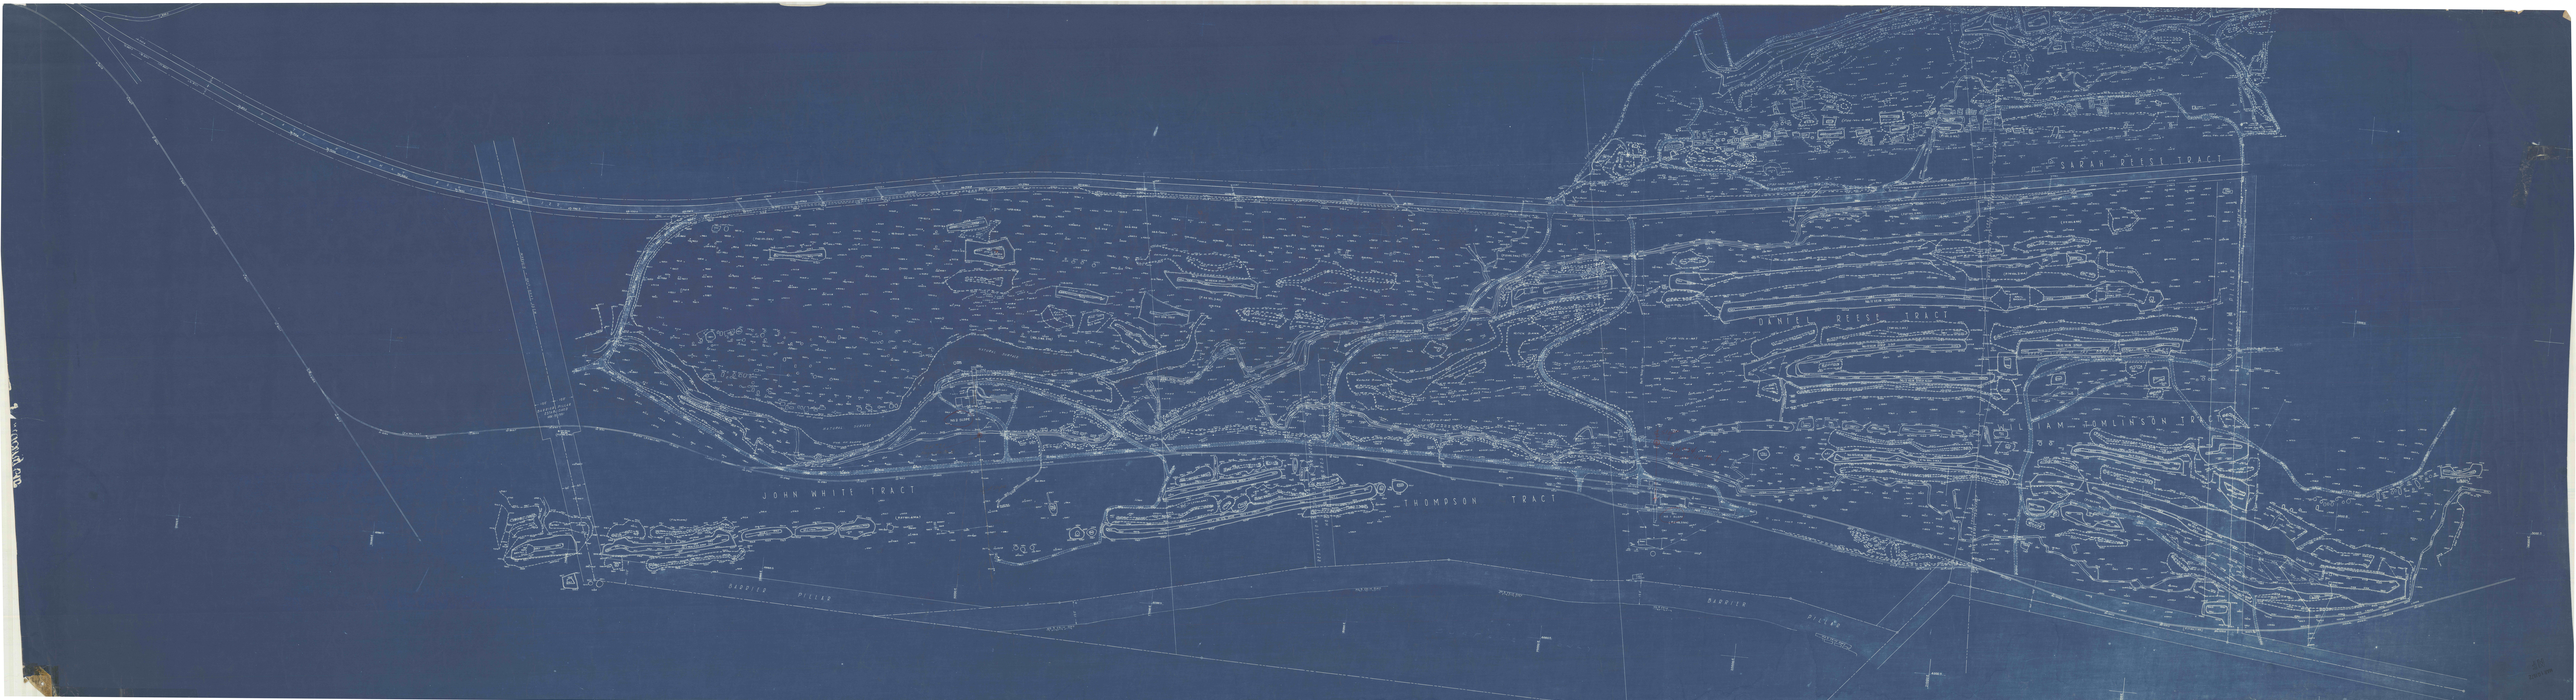

JOHN WHITE TRACT
THOMPSON TRACT
DANIEL REESE TRACT
SARAH REESE TRACT
WILLIAM HAMLINSON TRACT
BARRIER PILLAR
BARRIER PILLAR