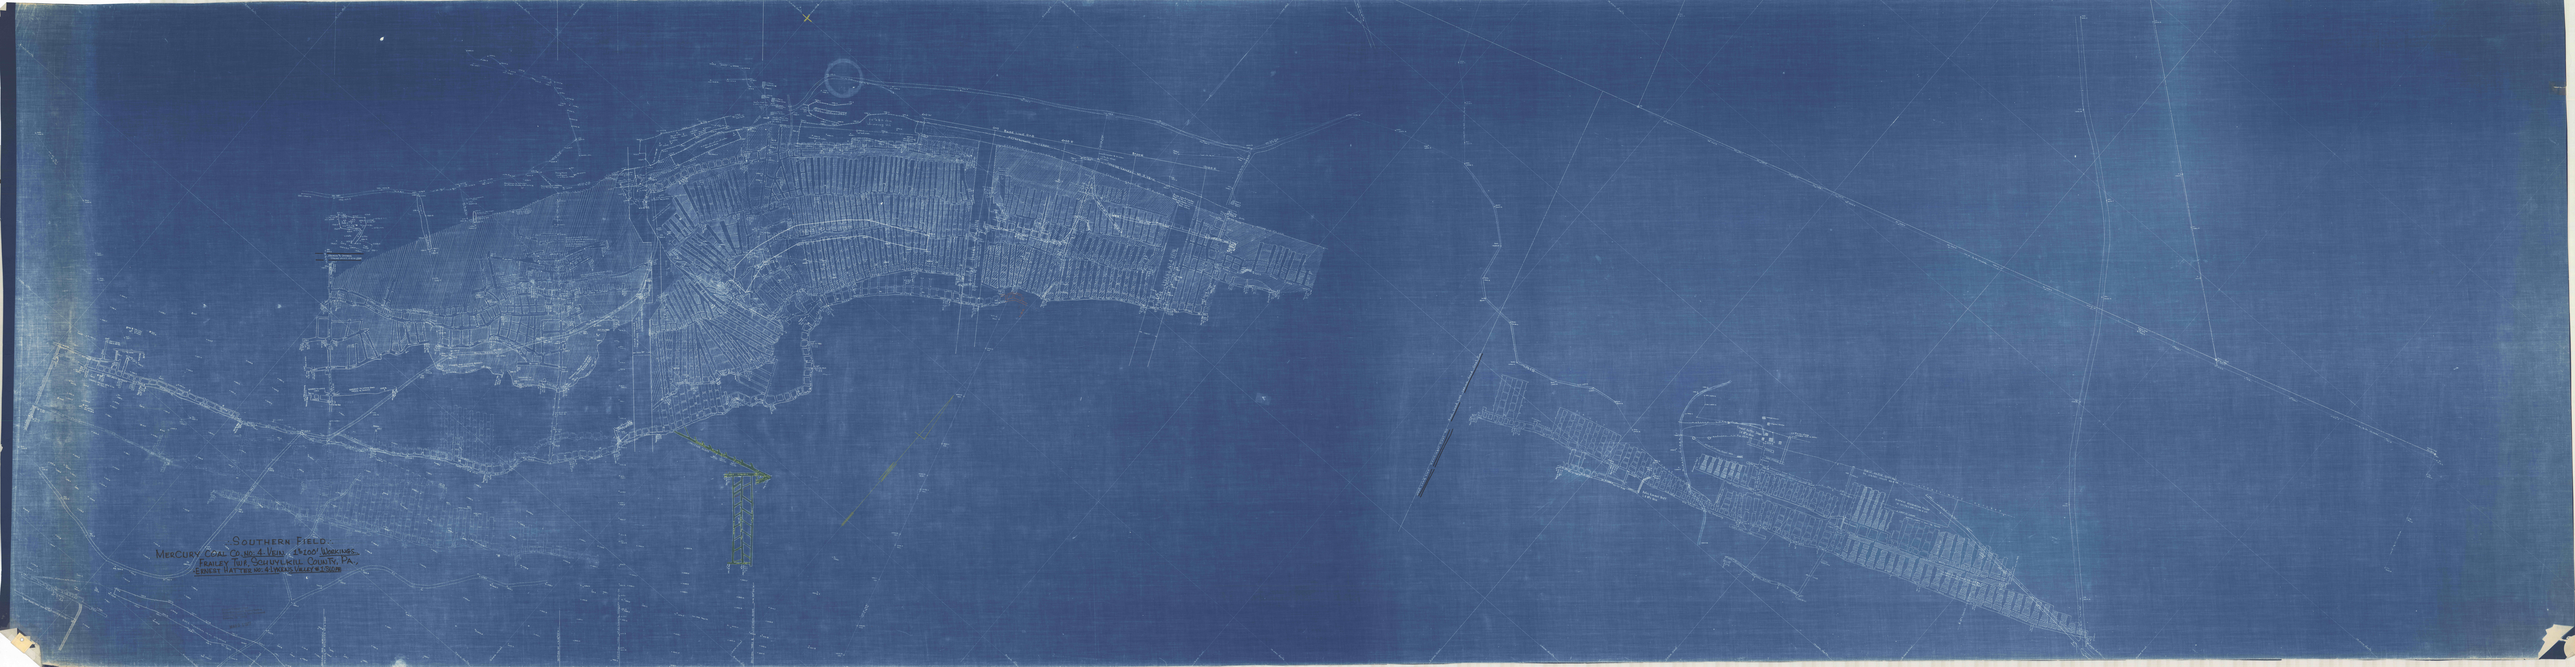
Southern Field.
Mercury Coal Co. no. 4 Vein. 1"=100' Workings.
Frailey Twp. Schuylkill County, Pa.
Ernest Hatter No. 4 Mines Colliery.