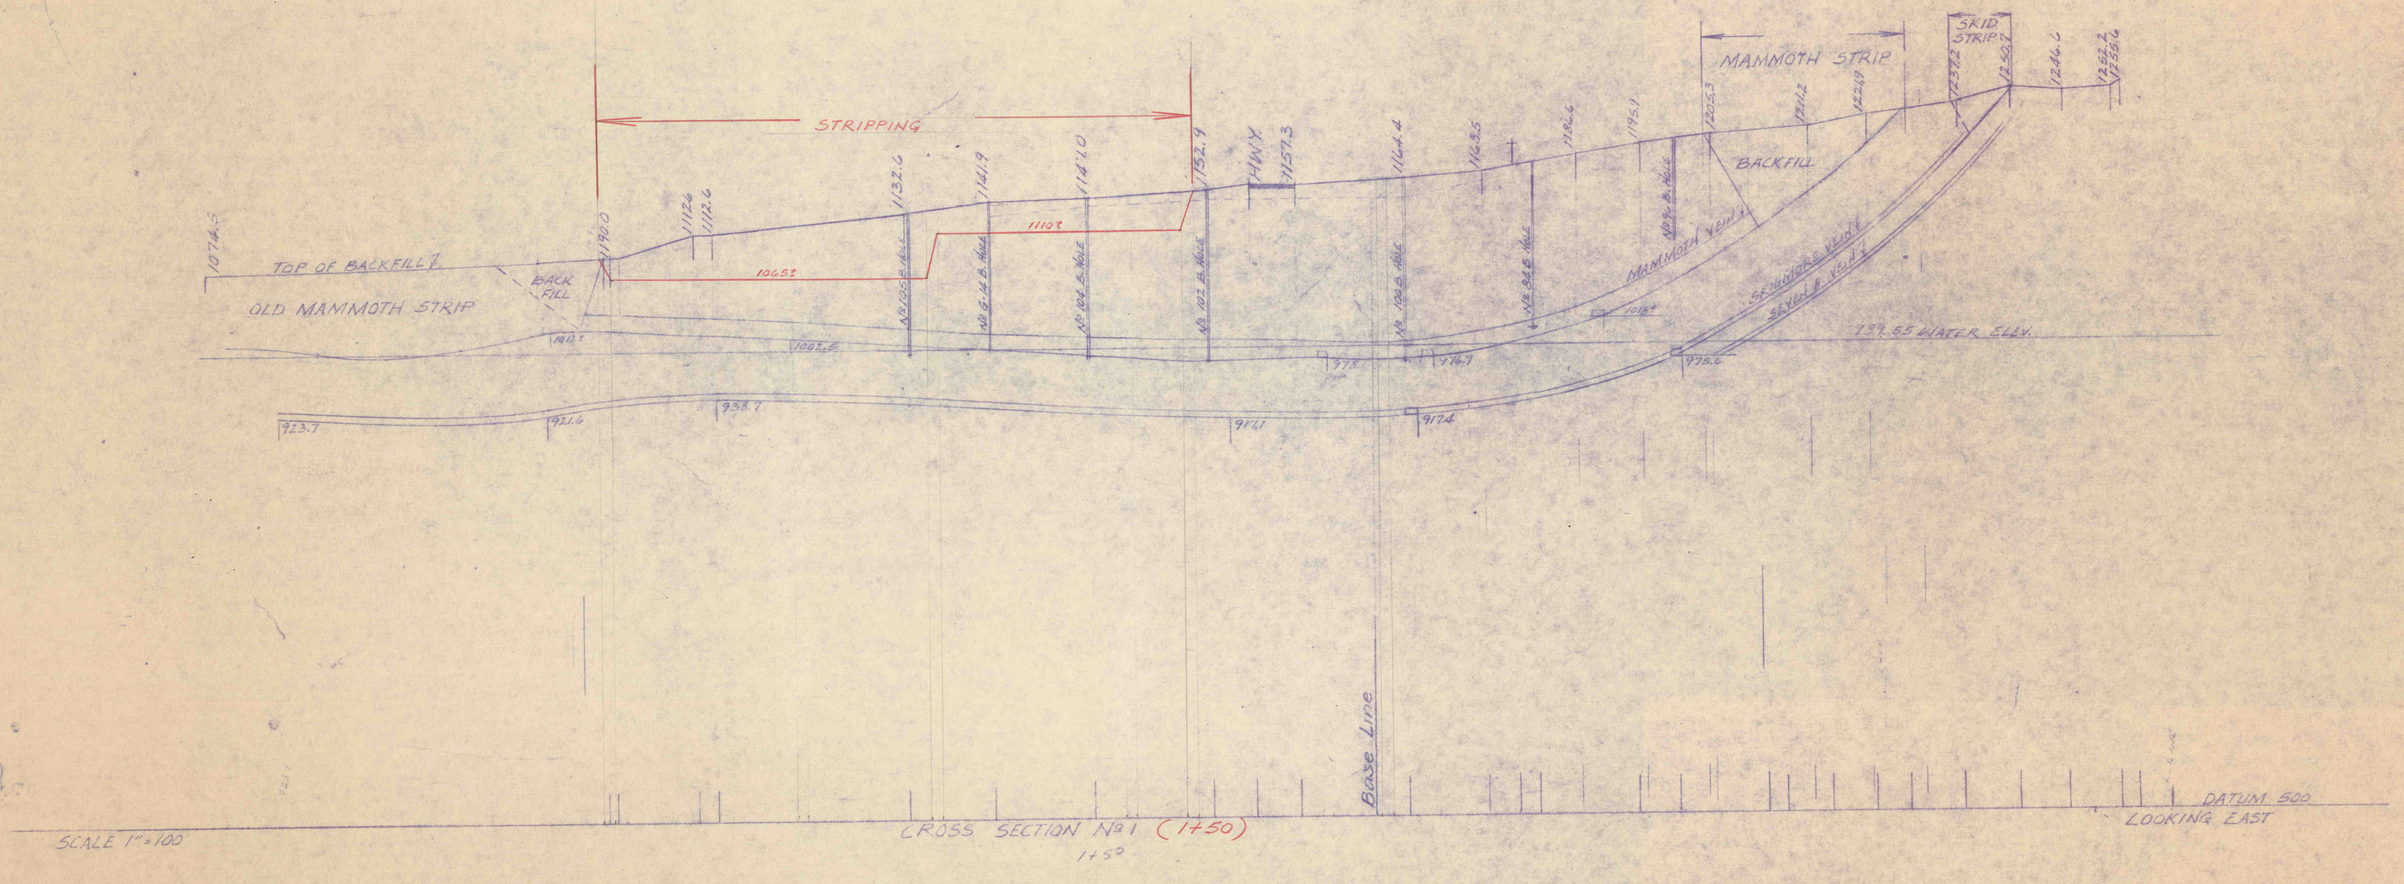
STRIPPING
MAMMOTH STRIP
SKID STRIP
BACKFILL
TOP OF BACKFILL
OLD MAMMOTH STRIP
BACK FILL
HWX
1074.3
1100
1112.6
1112.6
1132.6
1141.9
1141.0
1152.9
1157.3
1164.4
1168.5
1178.4
1195.1
1225.3
1241.2
1221.9
1232.2
1250.7
1246.6
1252.2
1255.6
1065t
1110t
1018t
1007.8
938.7
921.6
923.7
917.1
917.4
917.8
914.7
915.2
739.55 WATER ELEV.
Base Line
SCALE 1"=100
CROSS SECTION No 1 (1+50)
1+50
DATUM 500
LOOKING EAST