


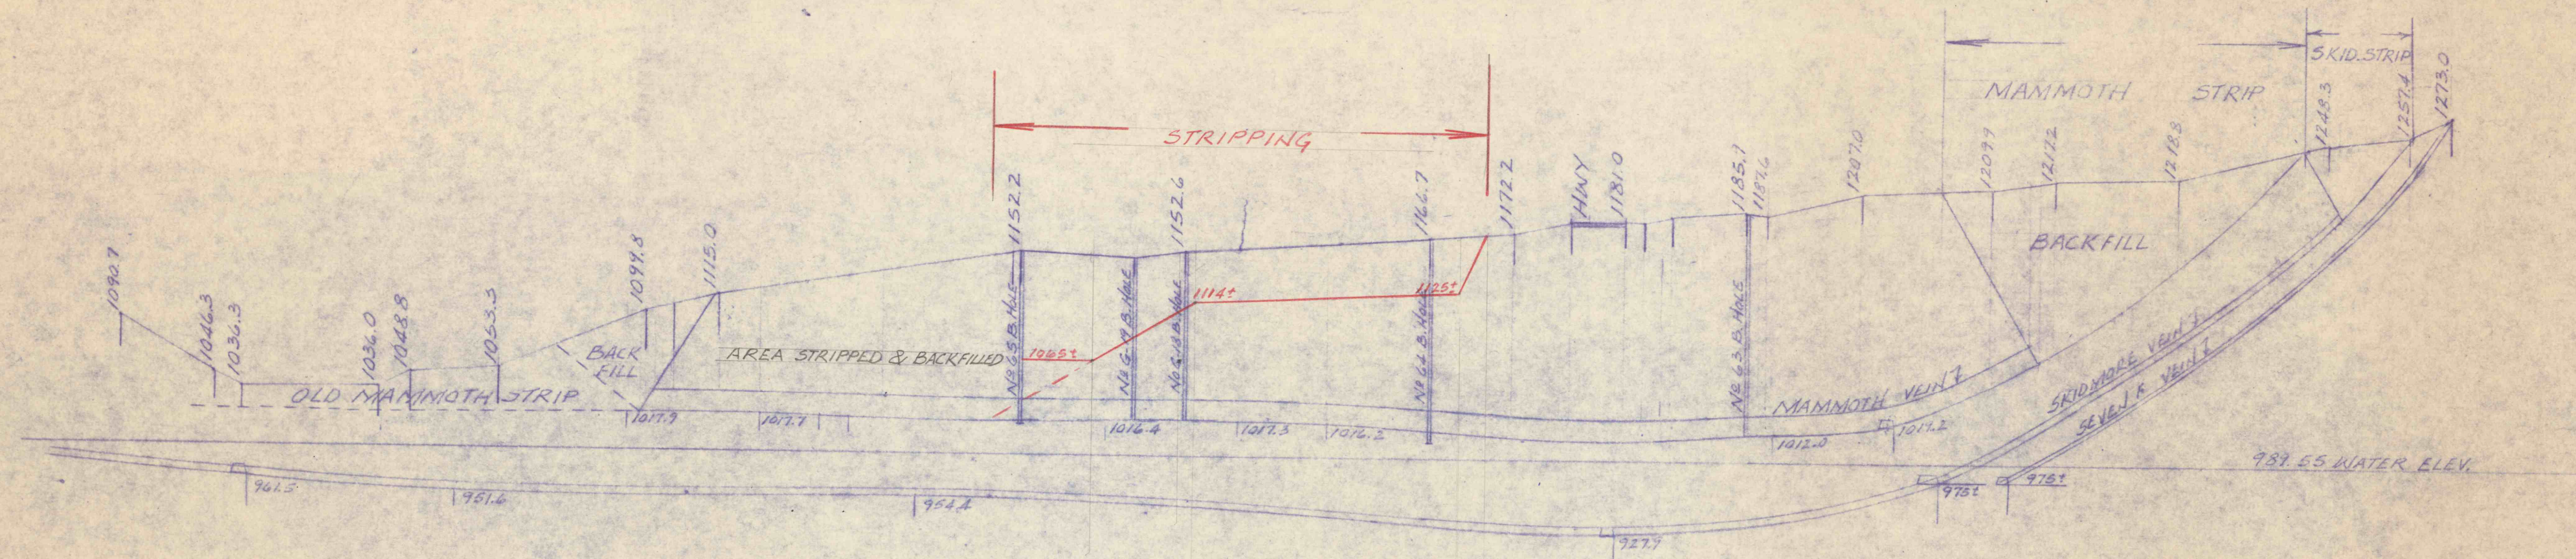

SCALE 1"=100

CROSS SECTION No 4 (SECTION LINE 6+00)

SECTION 6+00

DATUM 500
LOOKING EAST