


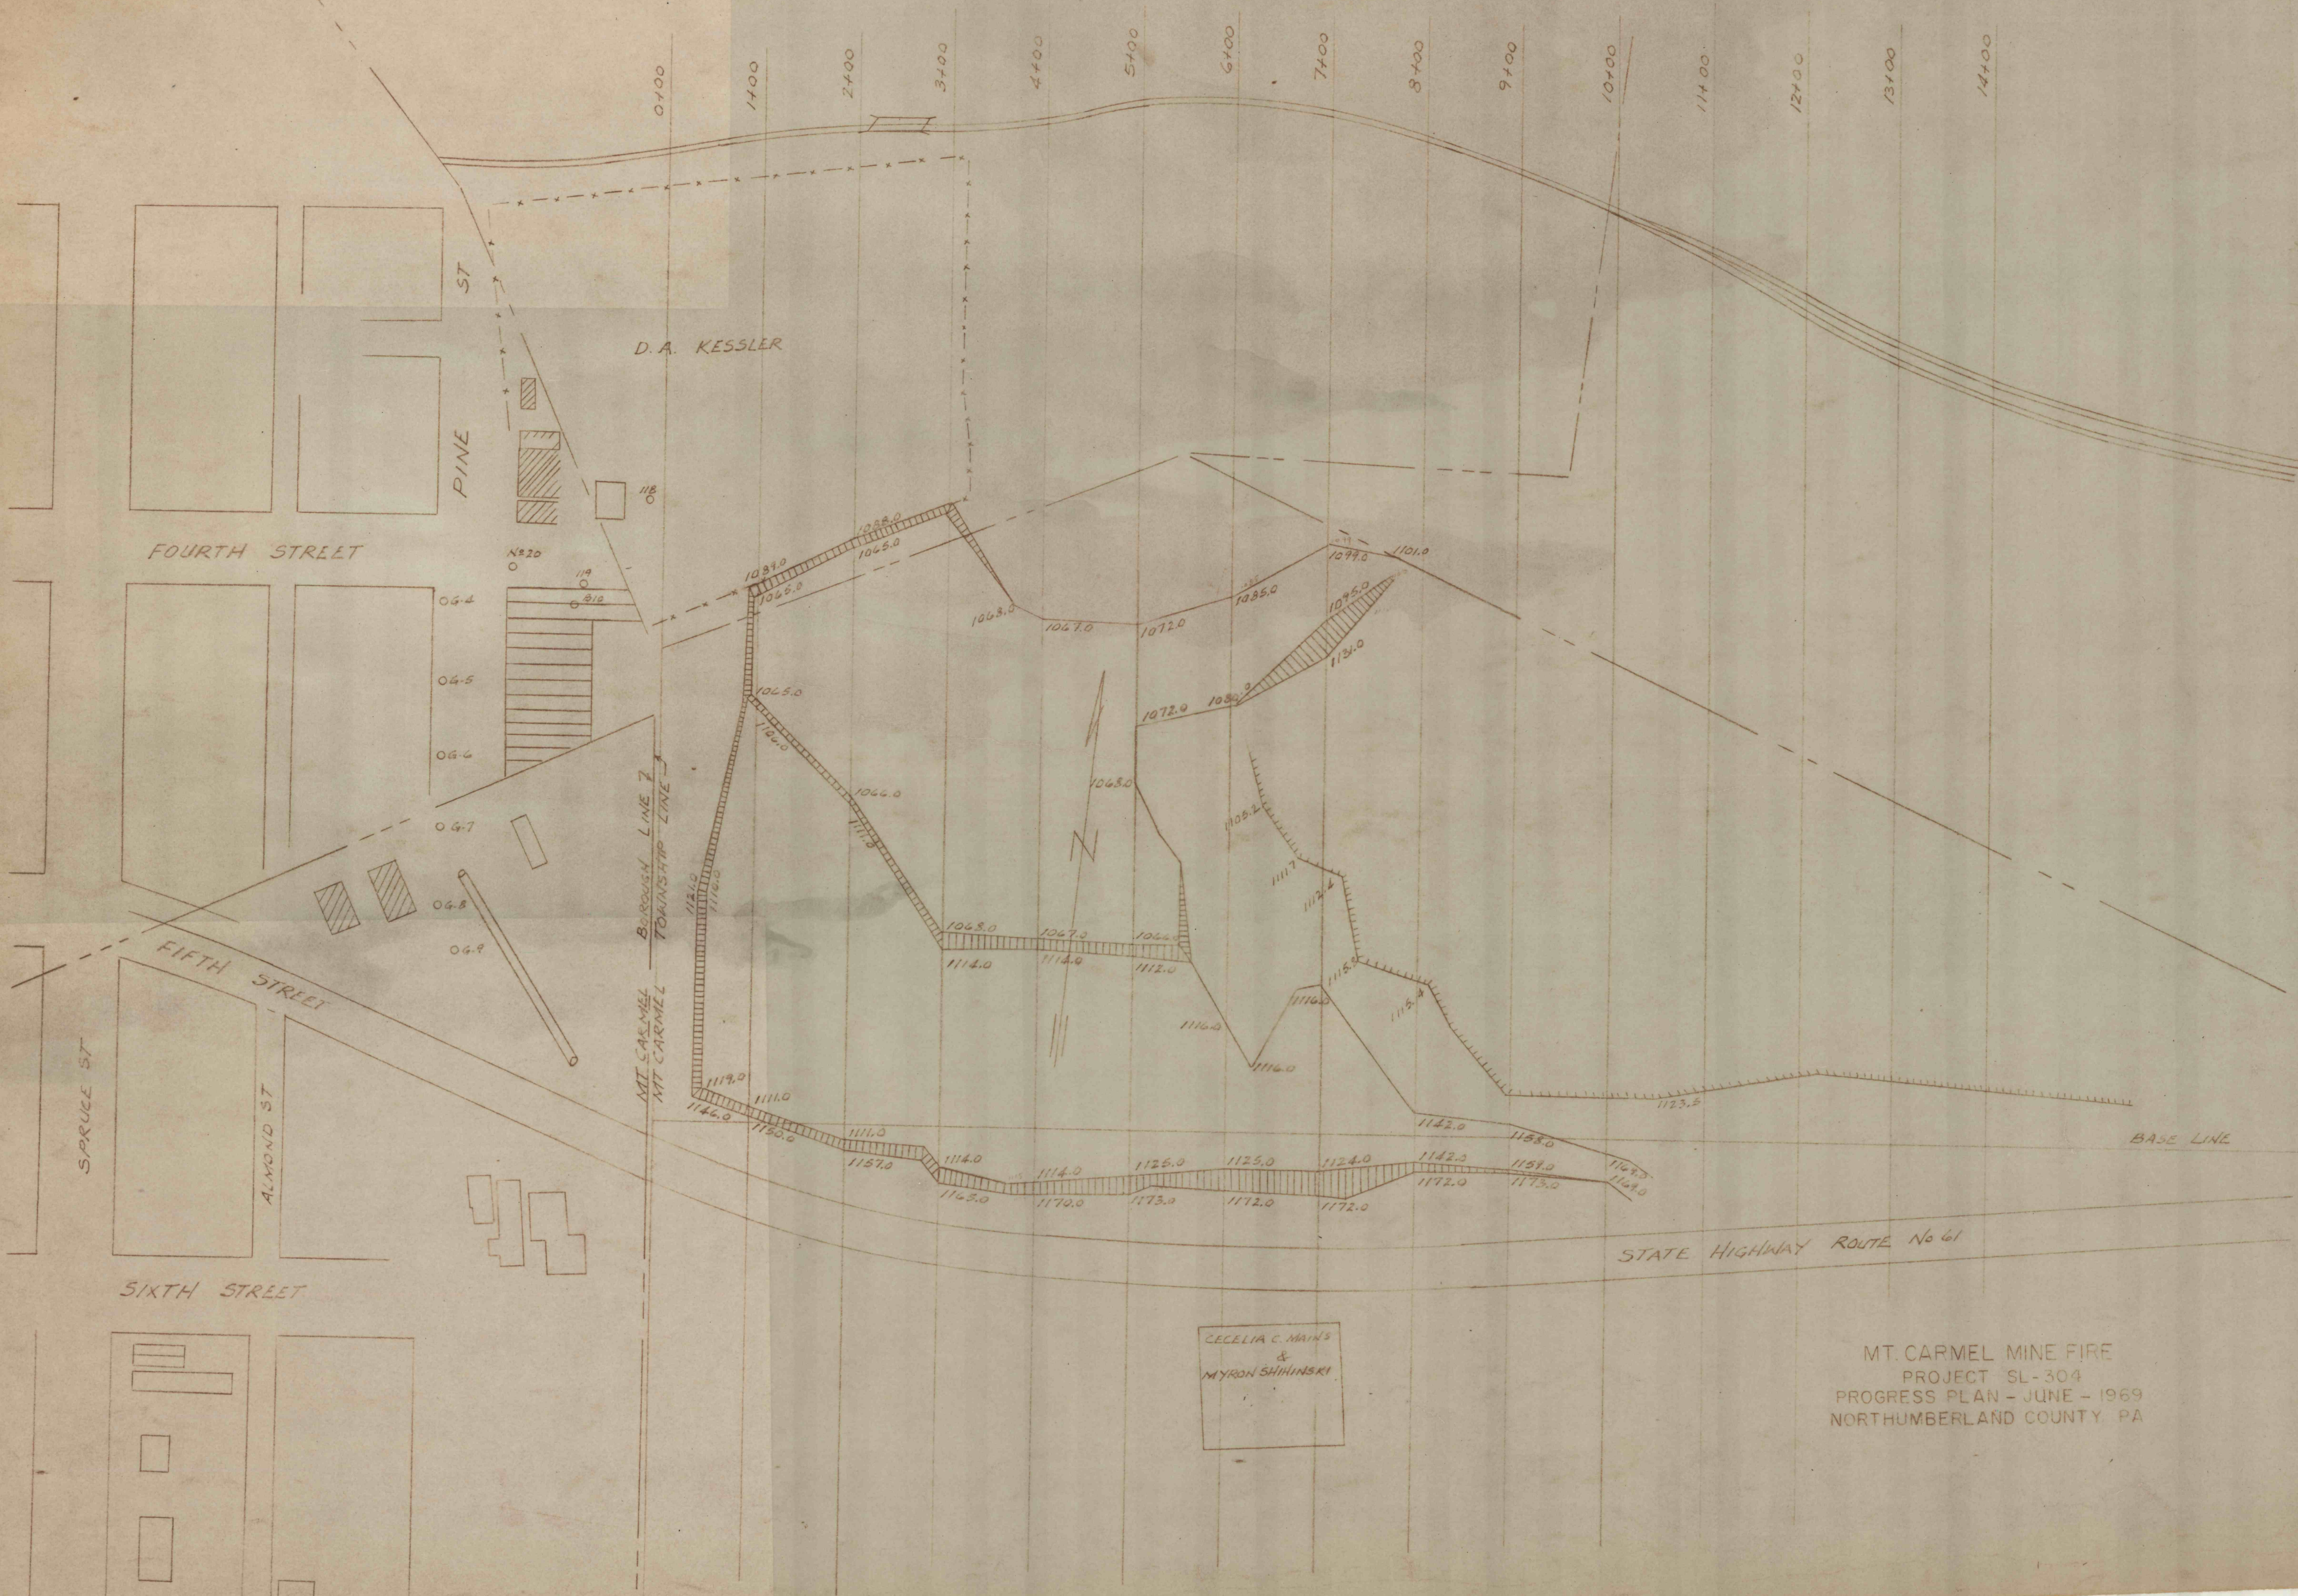

D.A. KESSLER

FOURTH STREET

FIFTH STREET

SIXTH STREET

SPRUCE ST

ALMOND ST

PINE ST

MT. CARMEL BOROUGH LINE
MT. CARMEL TOWNSHIP LINE

CECELIA C. MAINS
&
MYRON SHIHINSKI

MT. CARMEL MINE FIRE
PROJECT SL-304
PROGRESS PLAN - JUNE - 1969
NORTHUMBERLAND COUNTY PA

STATE HIGHWAY ROUTE No 61

BASE LINE