



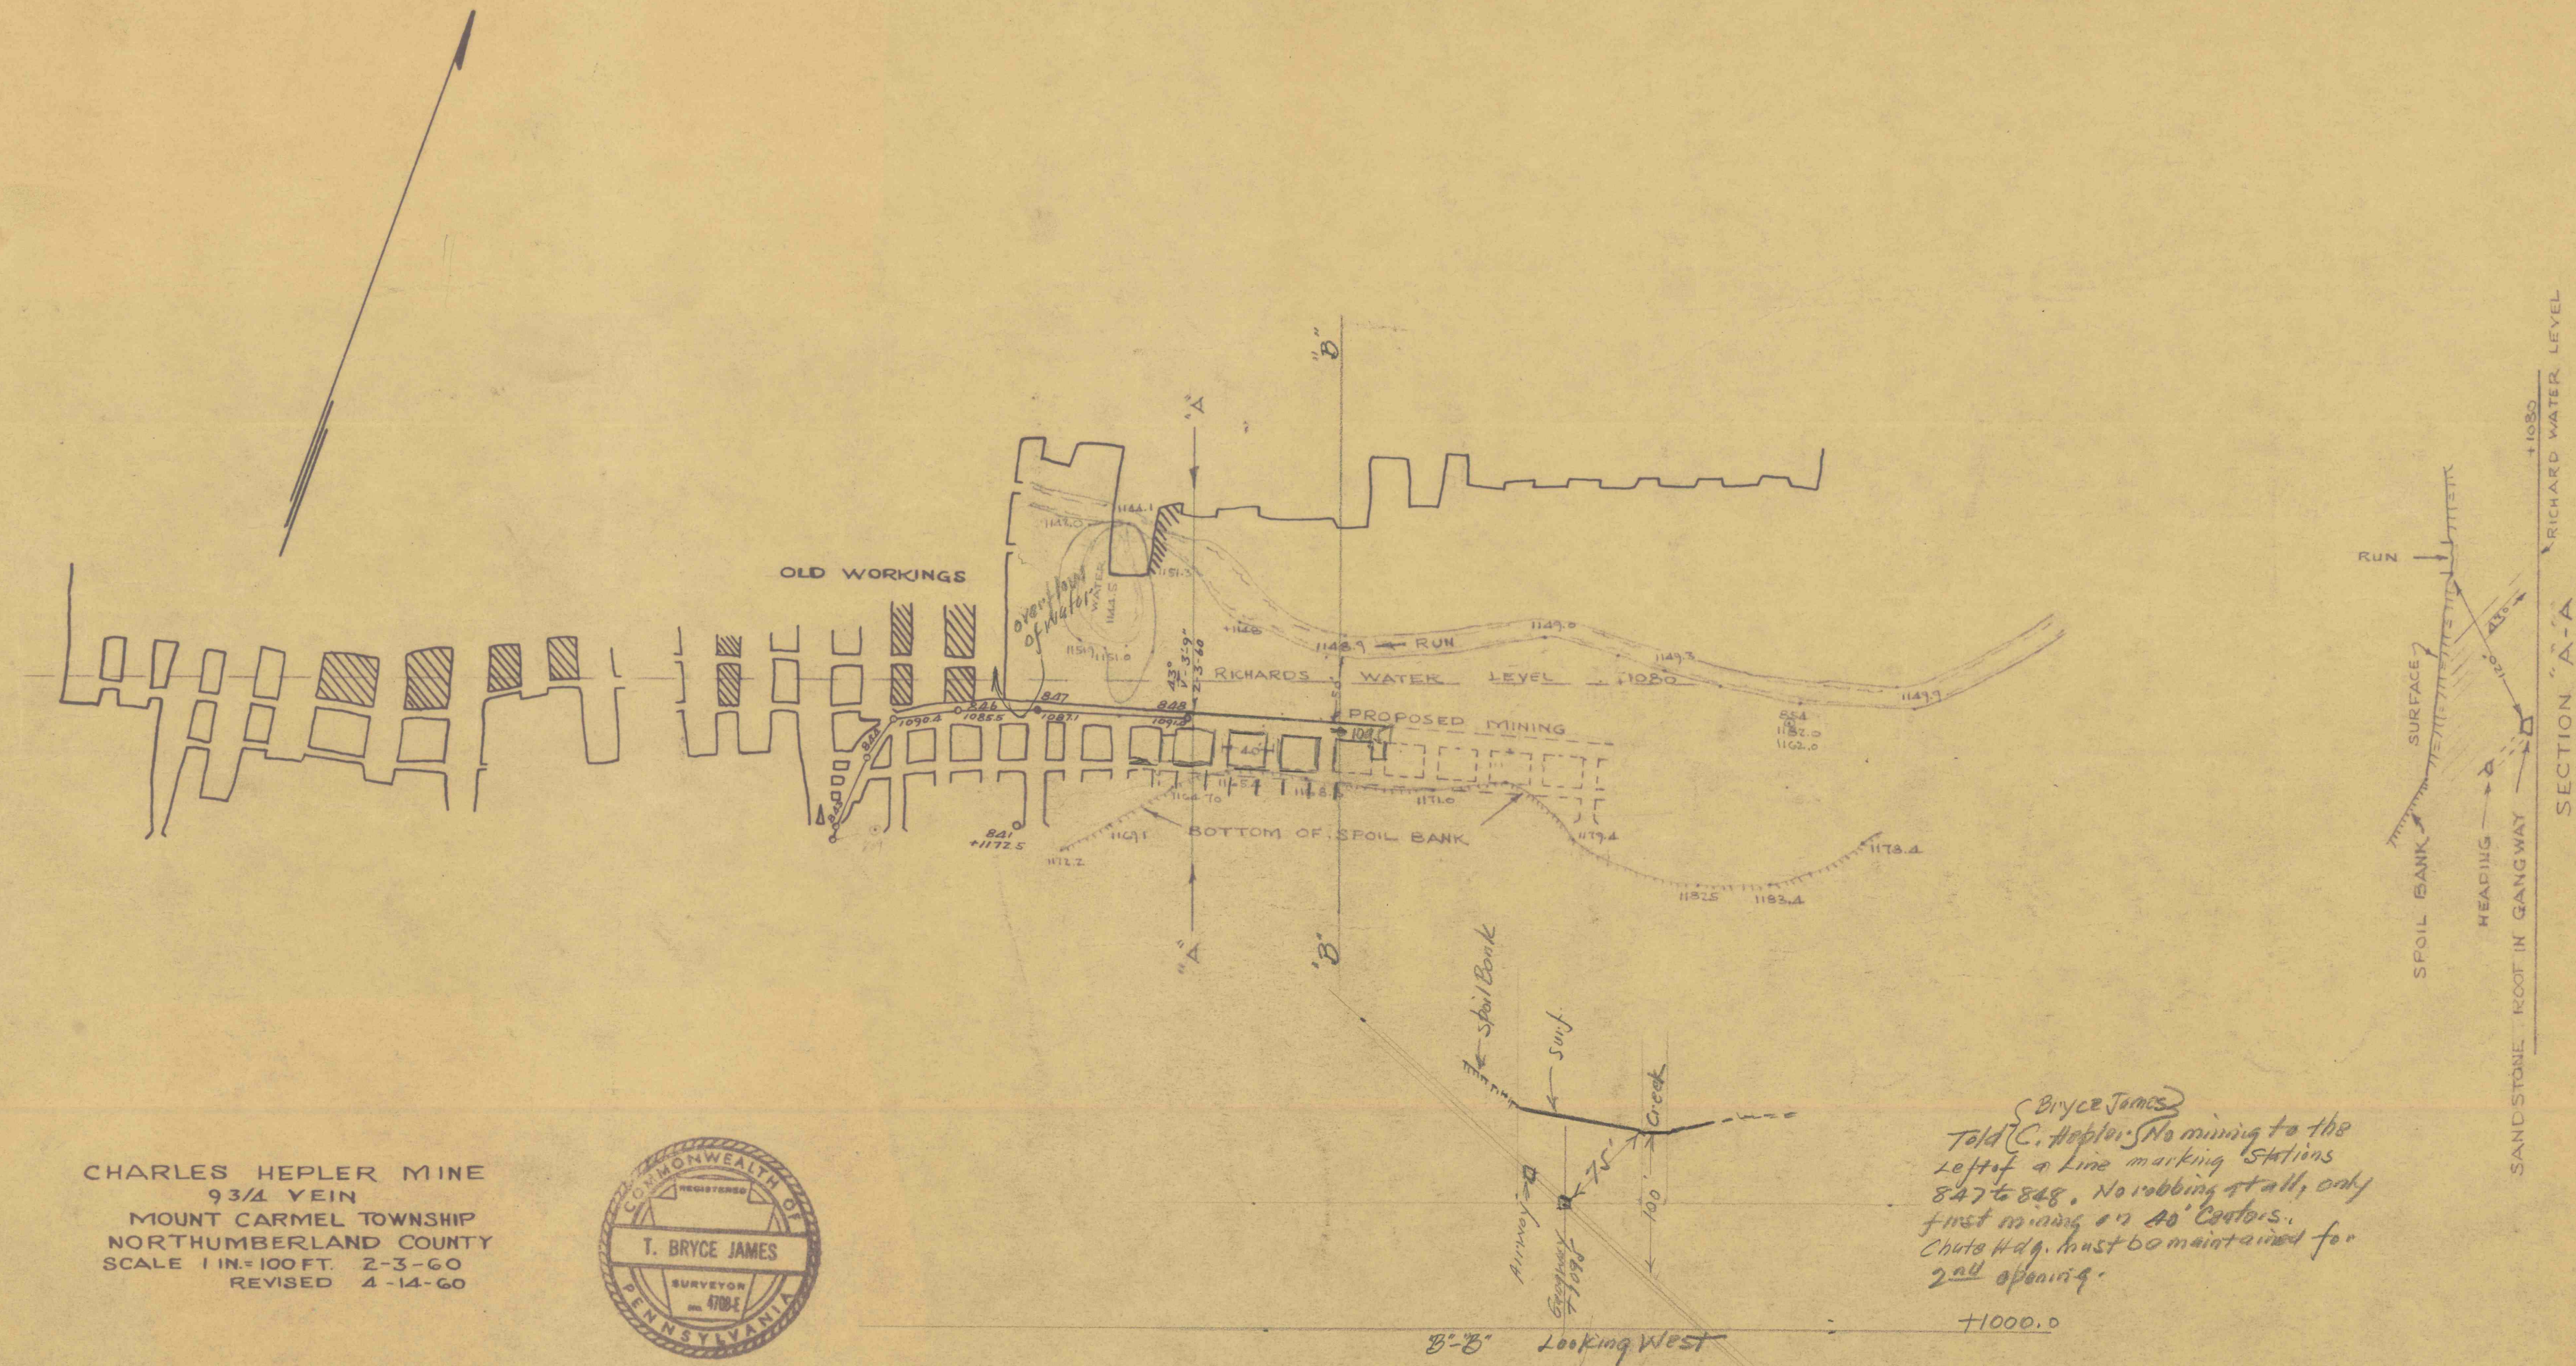

CHARLES HEPLER MINE
93 1/4 VEIN
MOUNT CARMEL TOWNSHIP
NORTHUMBERLAND COUNTY
SCALE 1 IN.=100 FT. 2-3-60
REVISED 4-14-60

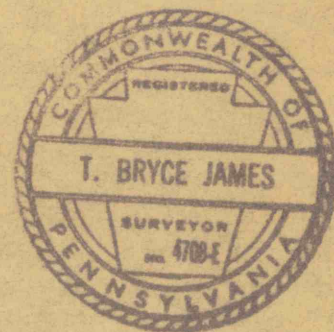

(Bryce James)
Told C. Apple. No mining to the
left of a line marking stations
847 to 848. No robbing at all, only
first mining on 40' centers.
Chute Hdg. must be maintained for
2nd opening.

+1000.0