


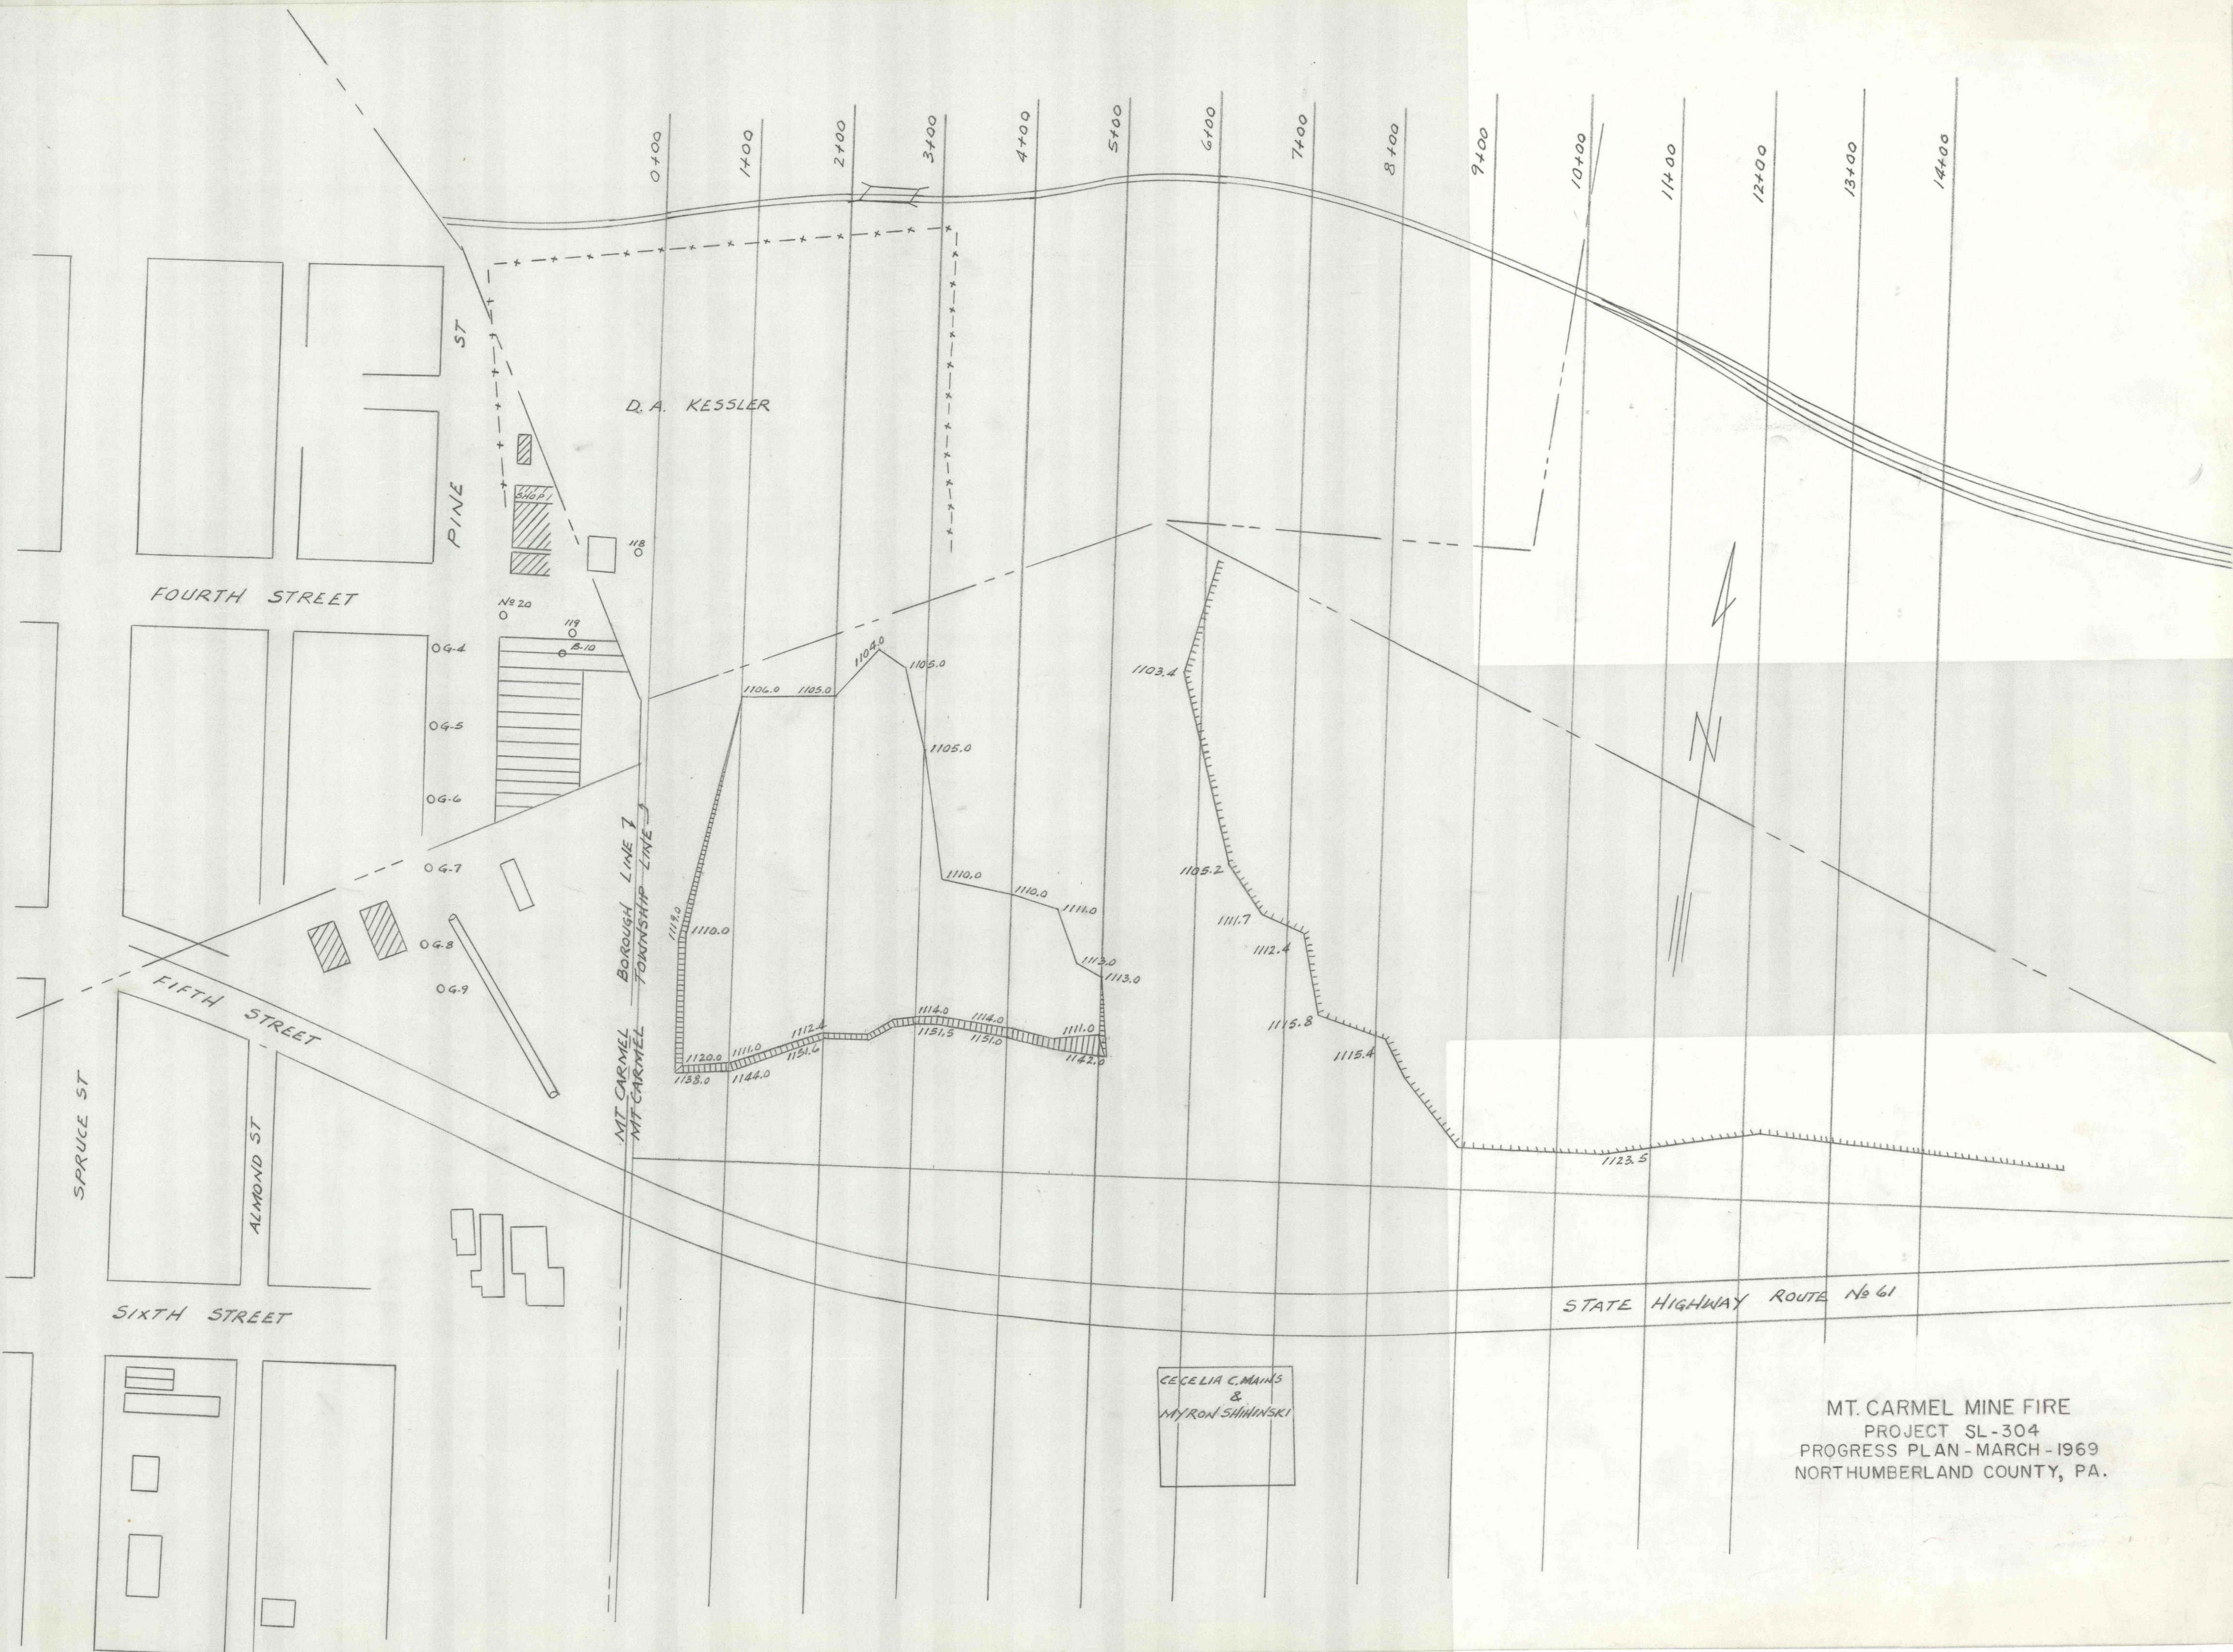

MT. CARMEL MINE FIRE
PROJECT SL-304
PROGRESS PLAN - MARCH - 1969
NORTHUMBERLAND COUNTY, PA.