


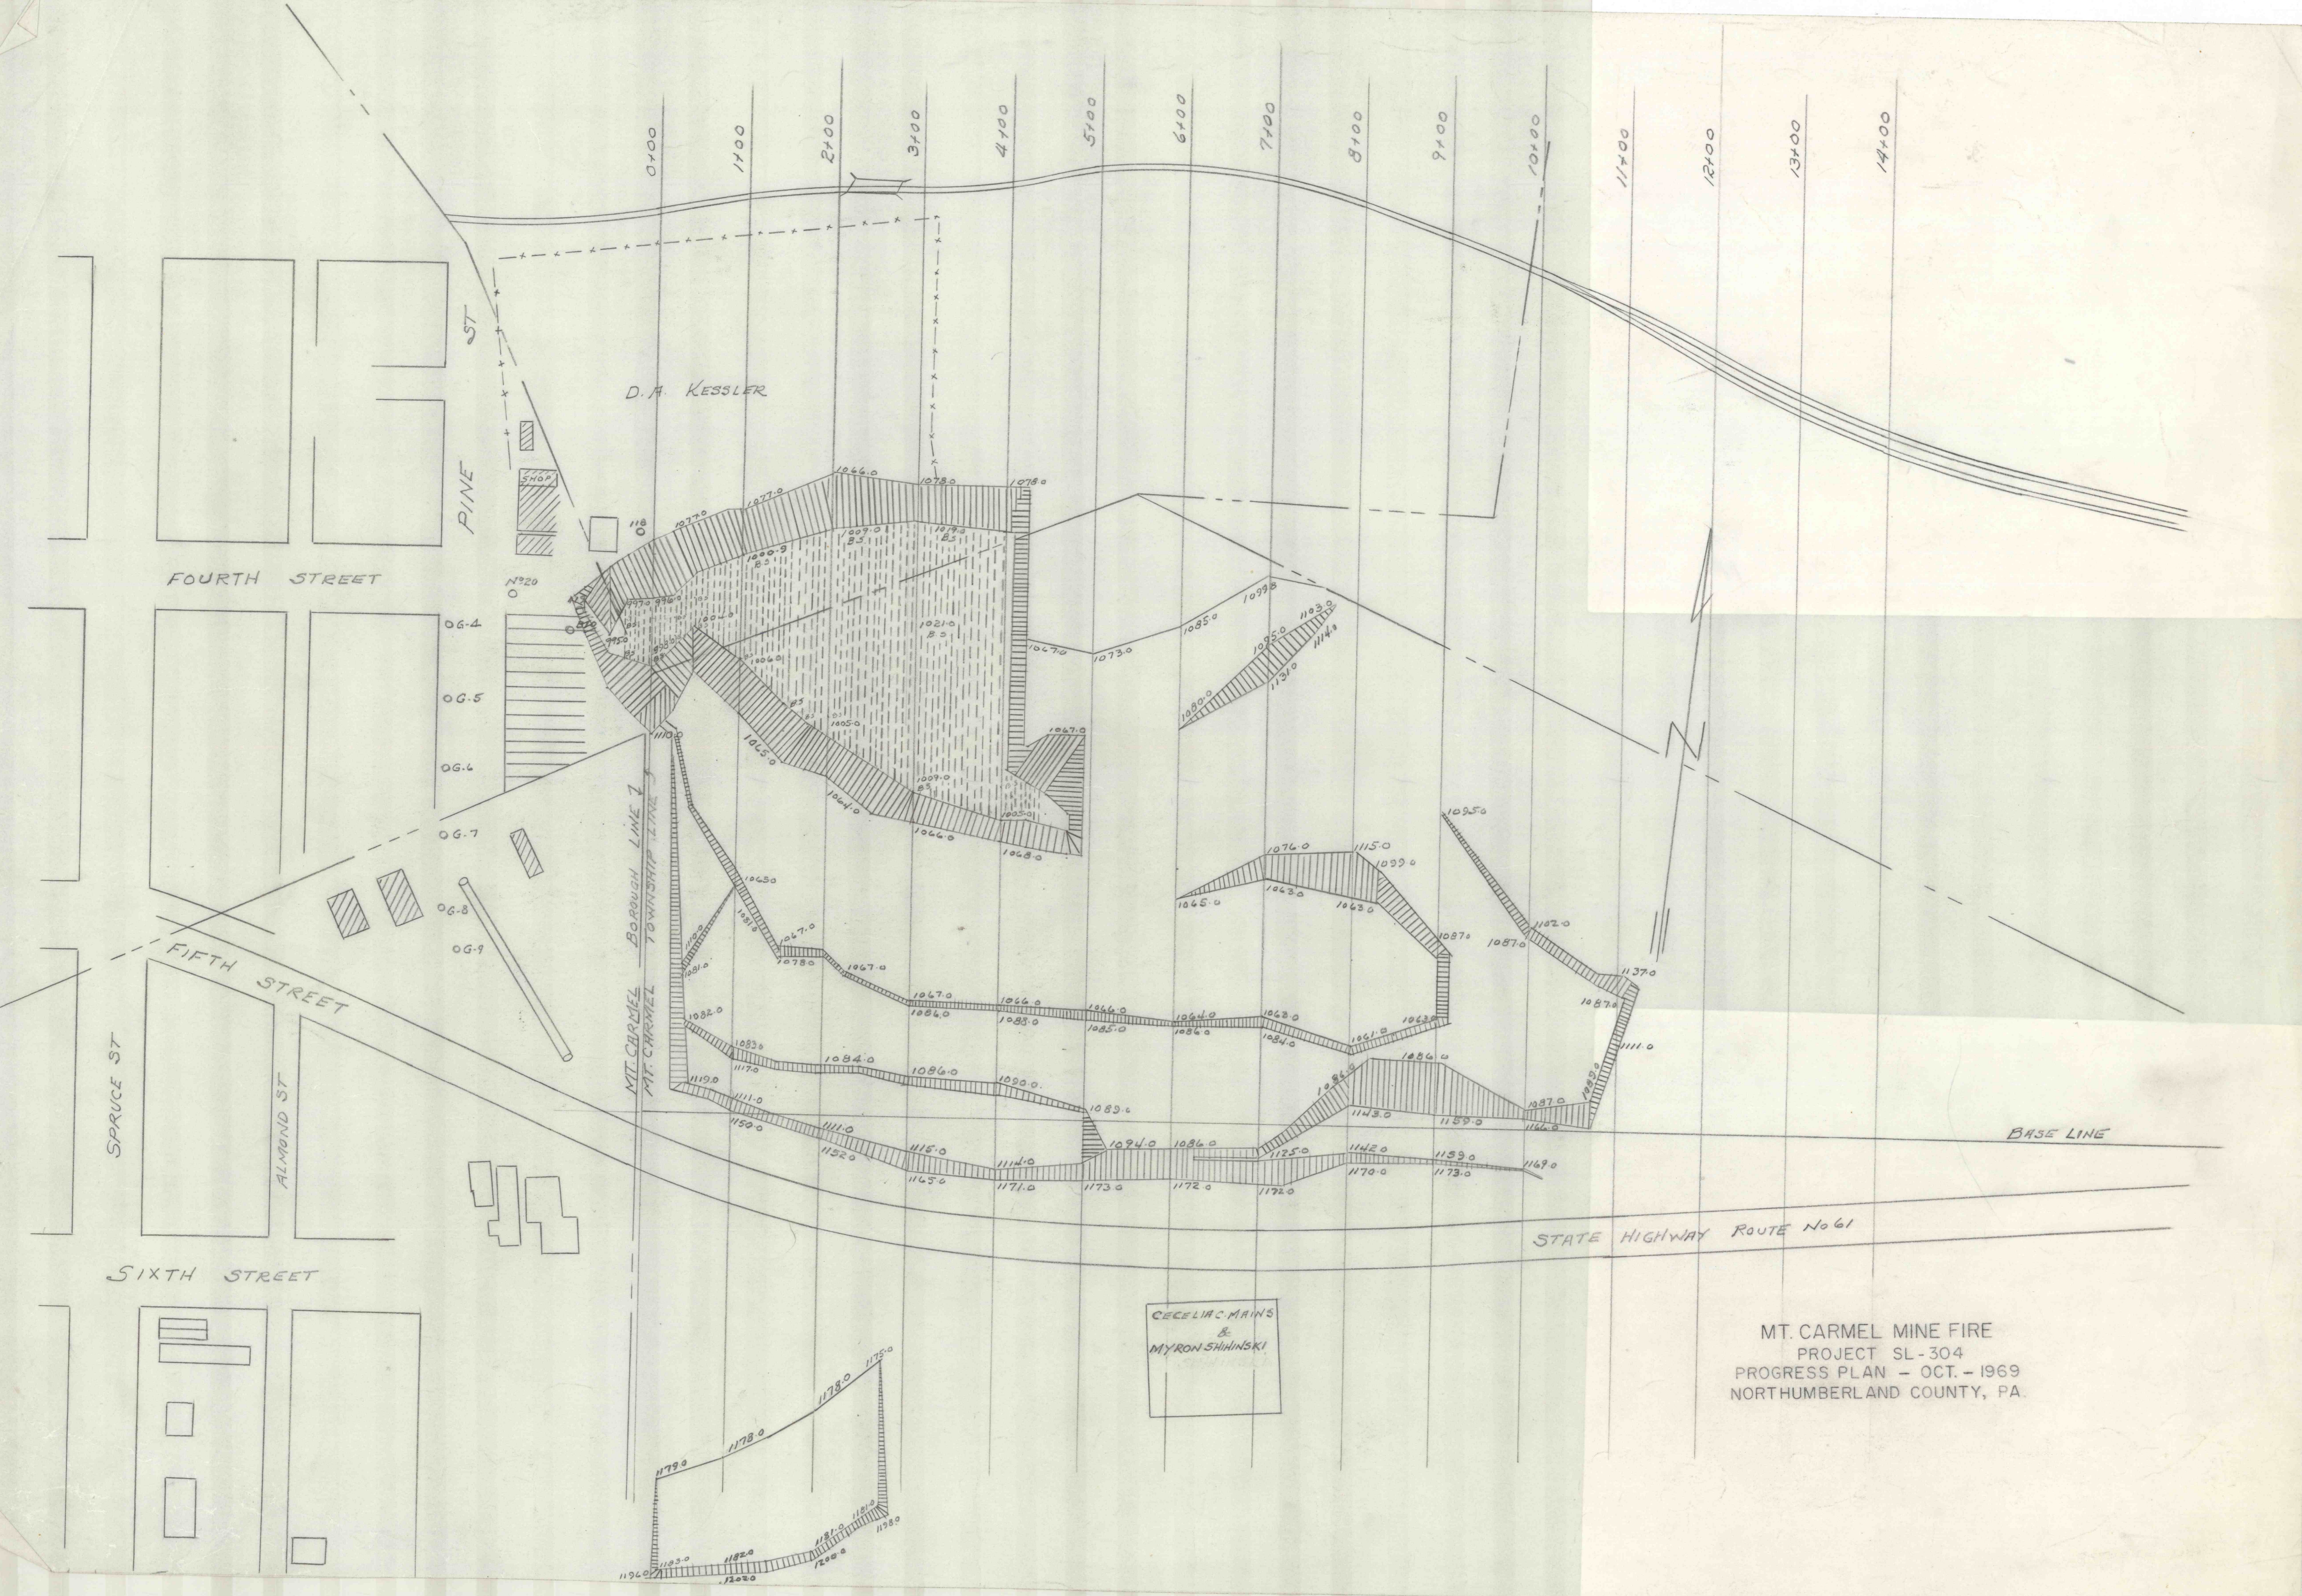

D. A. KESSLER

PINE ST

FOURTH STREET

OG-4

OG-5

OG-6

OG-7

OG-8

OG-9

FIFTH STREET

SPRUCE ST

ALMOND ST

SIXTH STREET

MT. CARMEL BOROUGH LINE
MT. CARMEL TOWNSHIP LINE

BASE LINE

STATE HIGHWAY ROUTE No 61

CECELIA C. MAINS
&
MYRON SHIHINSKI

MT. CARMEL MINE FIRE
PROJECT SL-304
PROGRESS PLAN - OCT. - 1969
NORTHUMBERLAND COUNTY, PA.