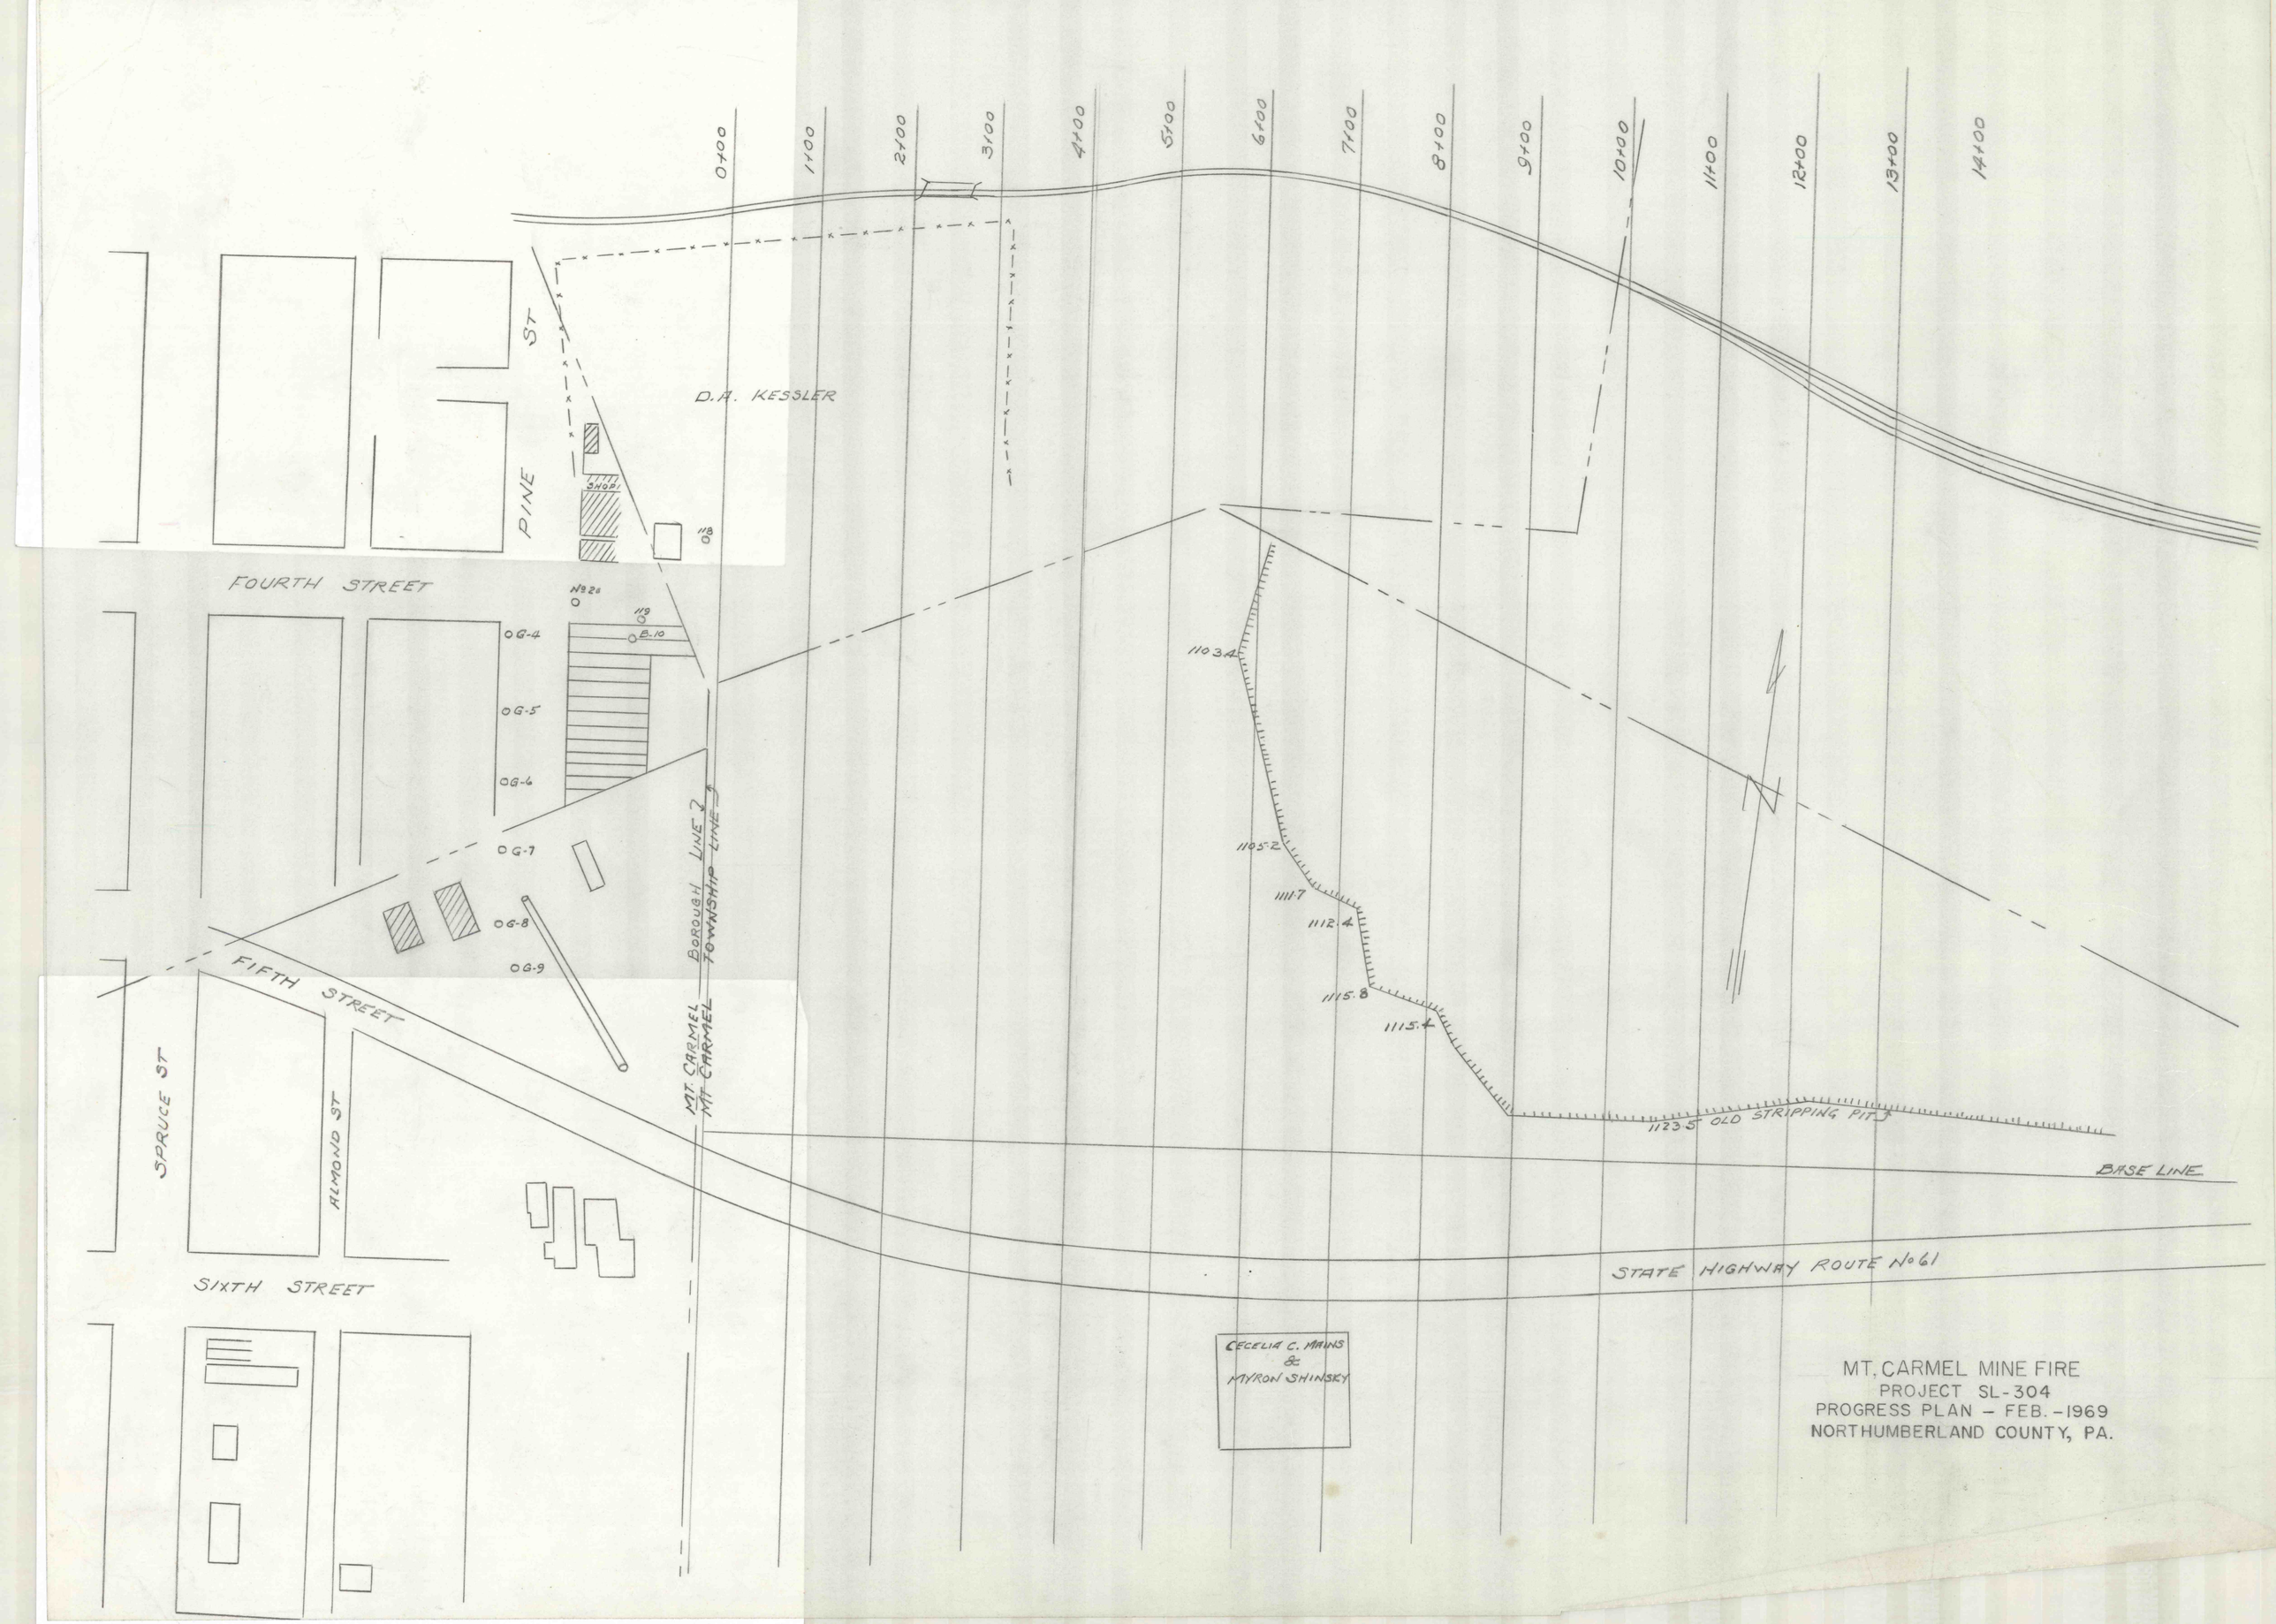

MT. CARMEL MINE FIRE
PROJECT SL-304
PROGRESS PLAN – FEB.-1969
NORTHUMBERLAND COUNTY, PA.