
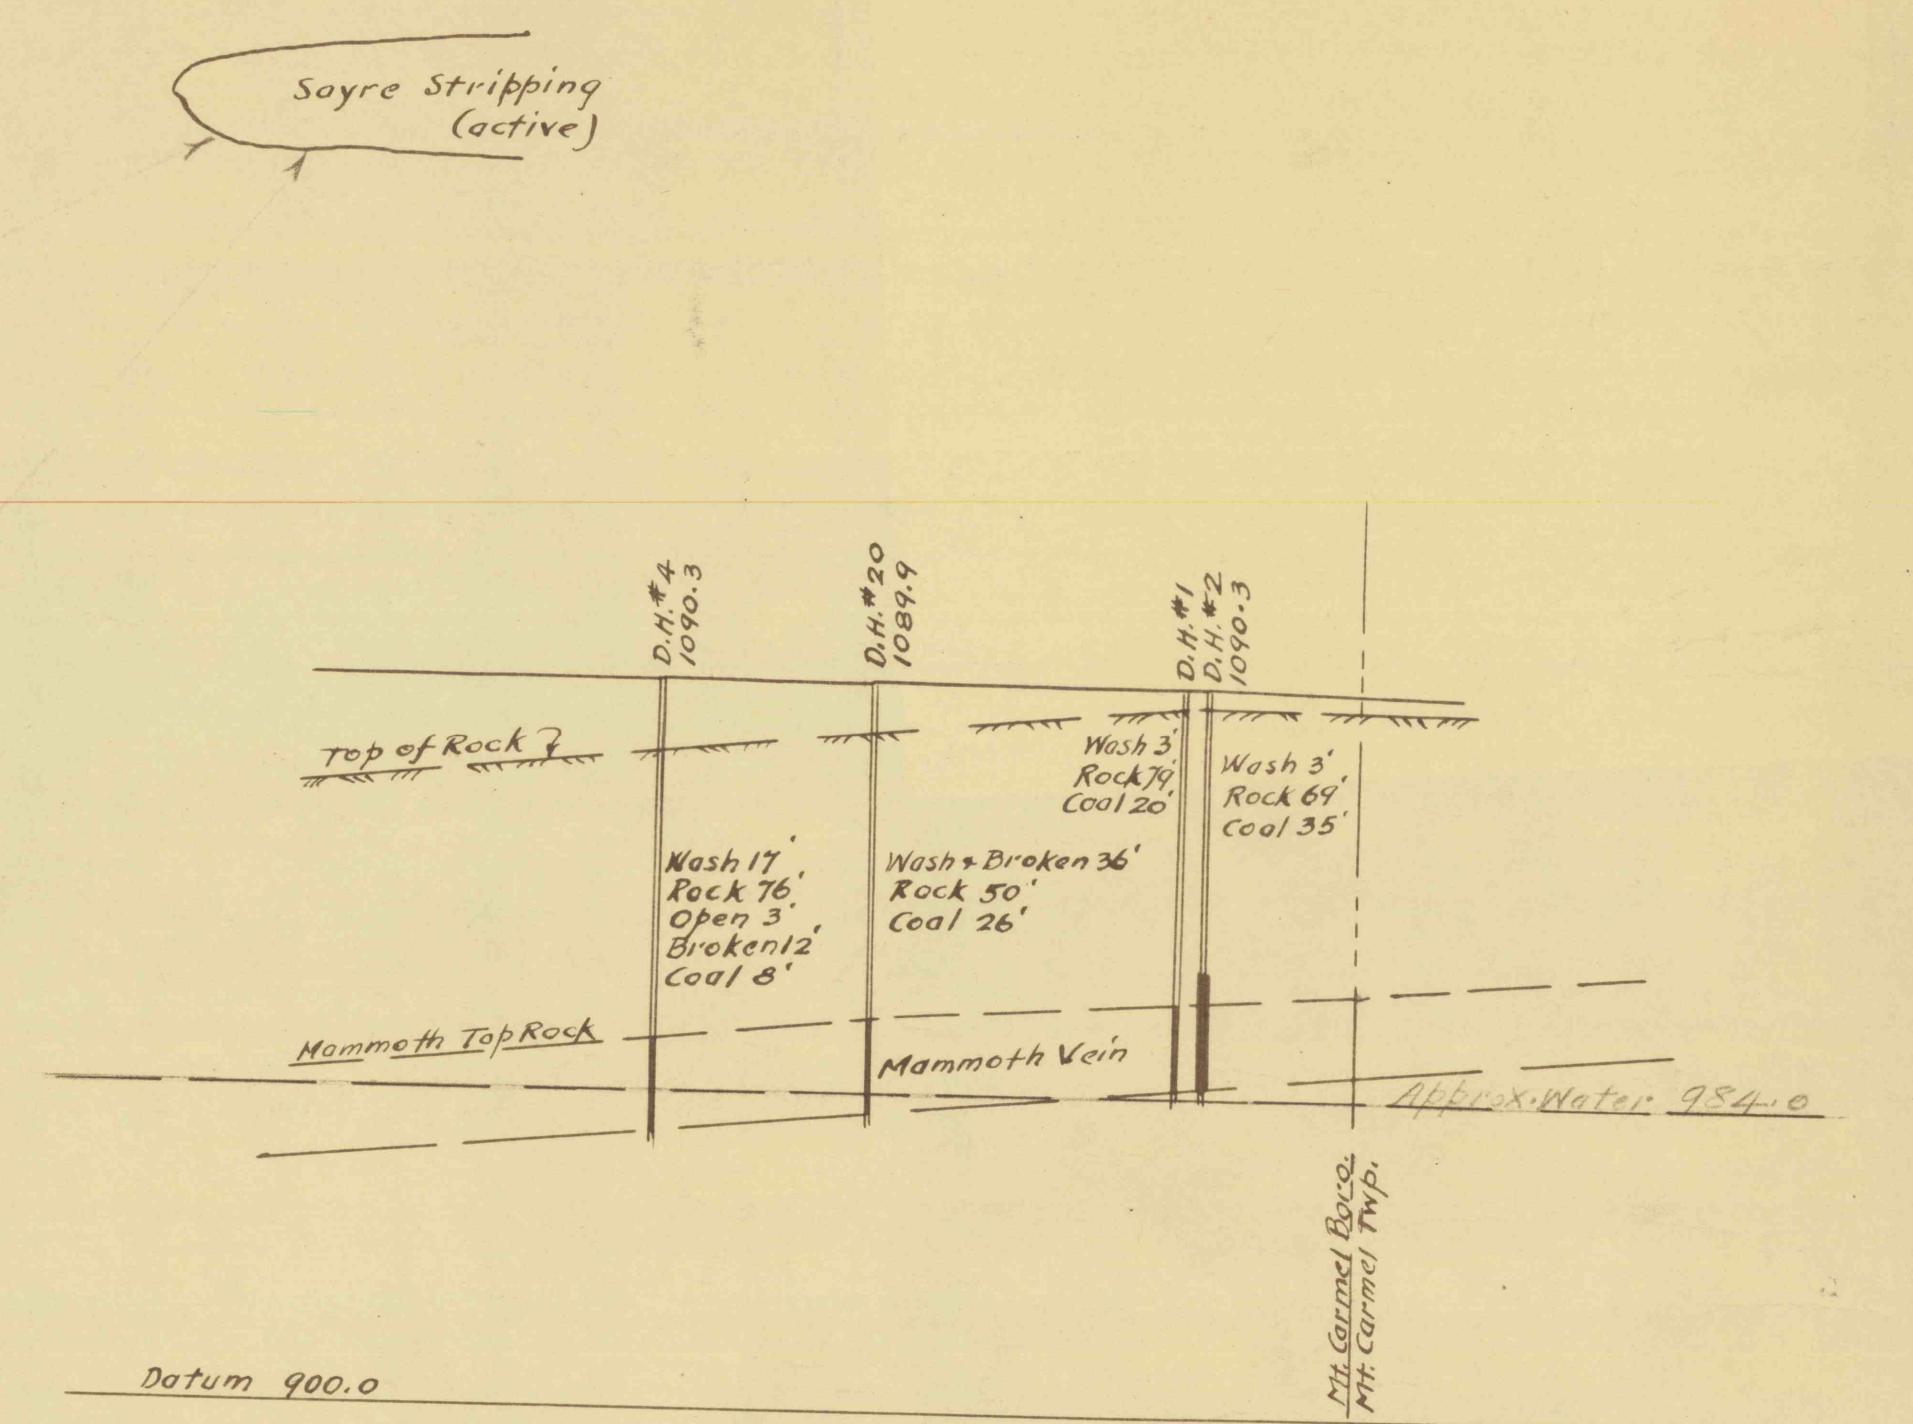


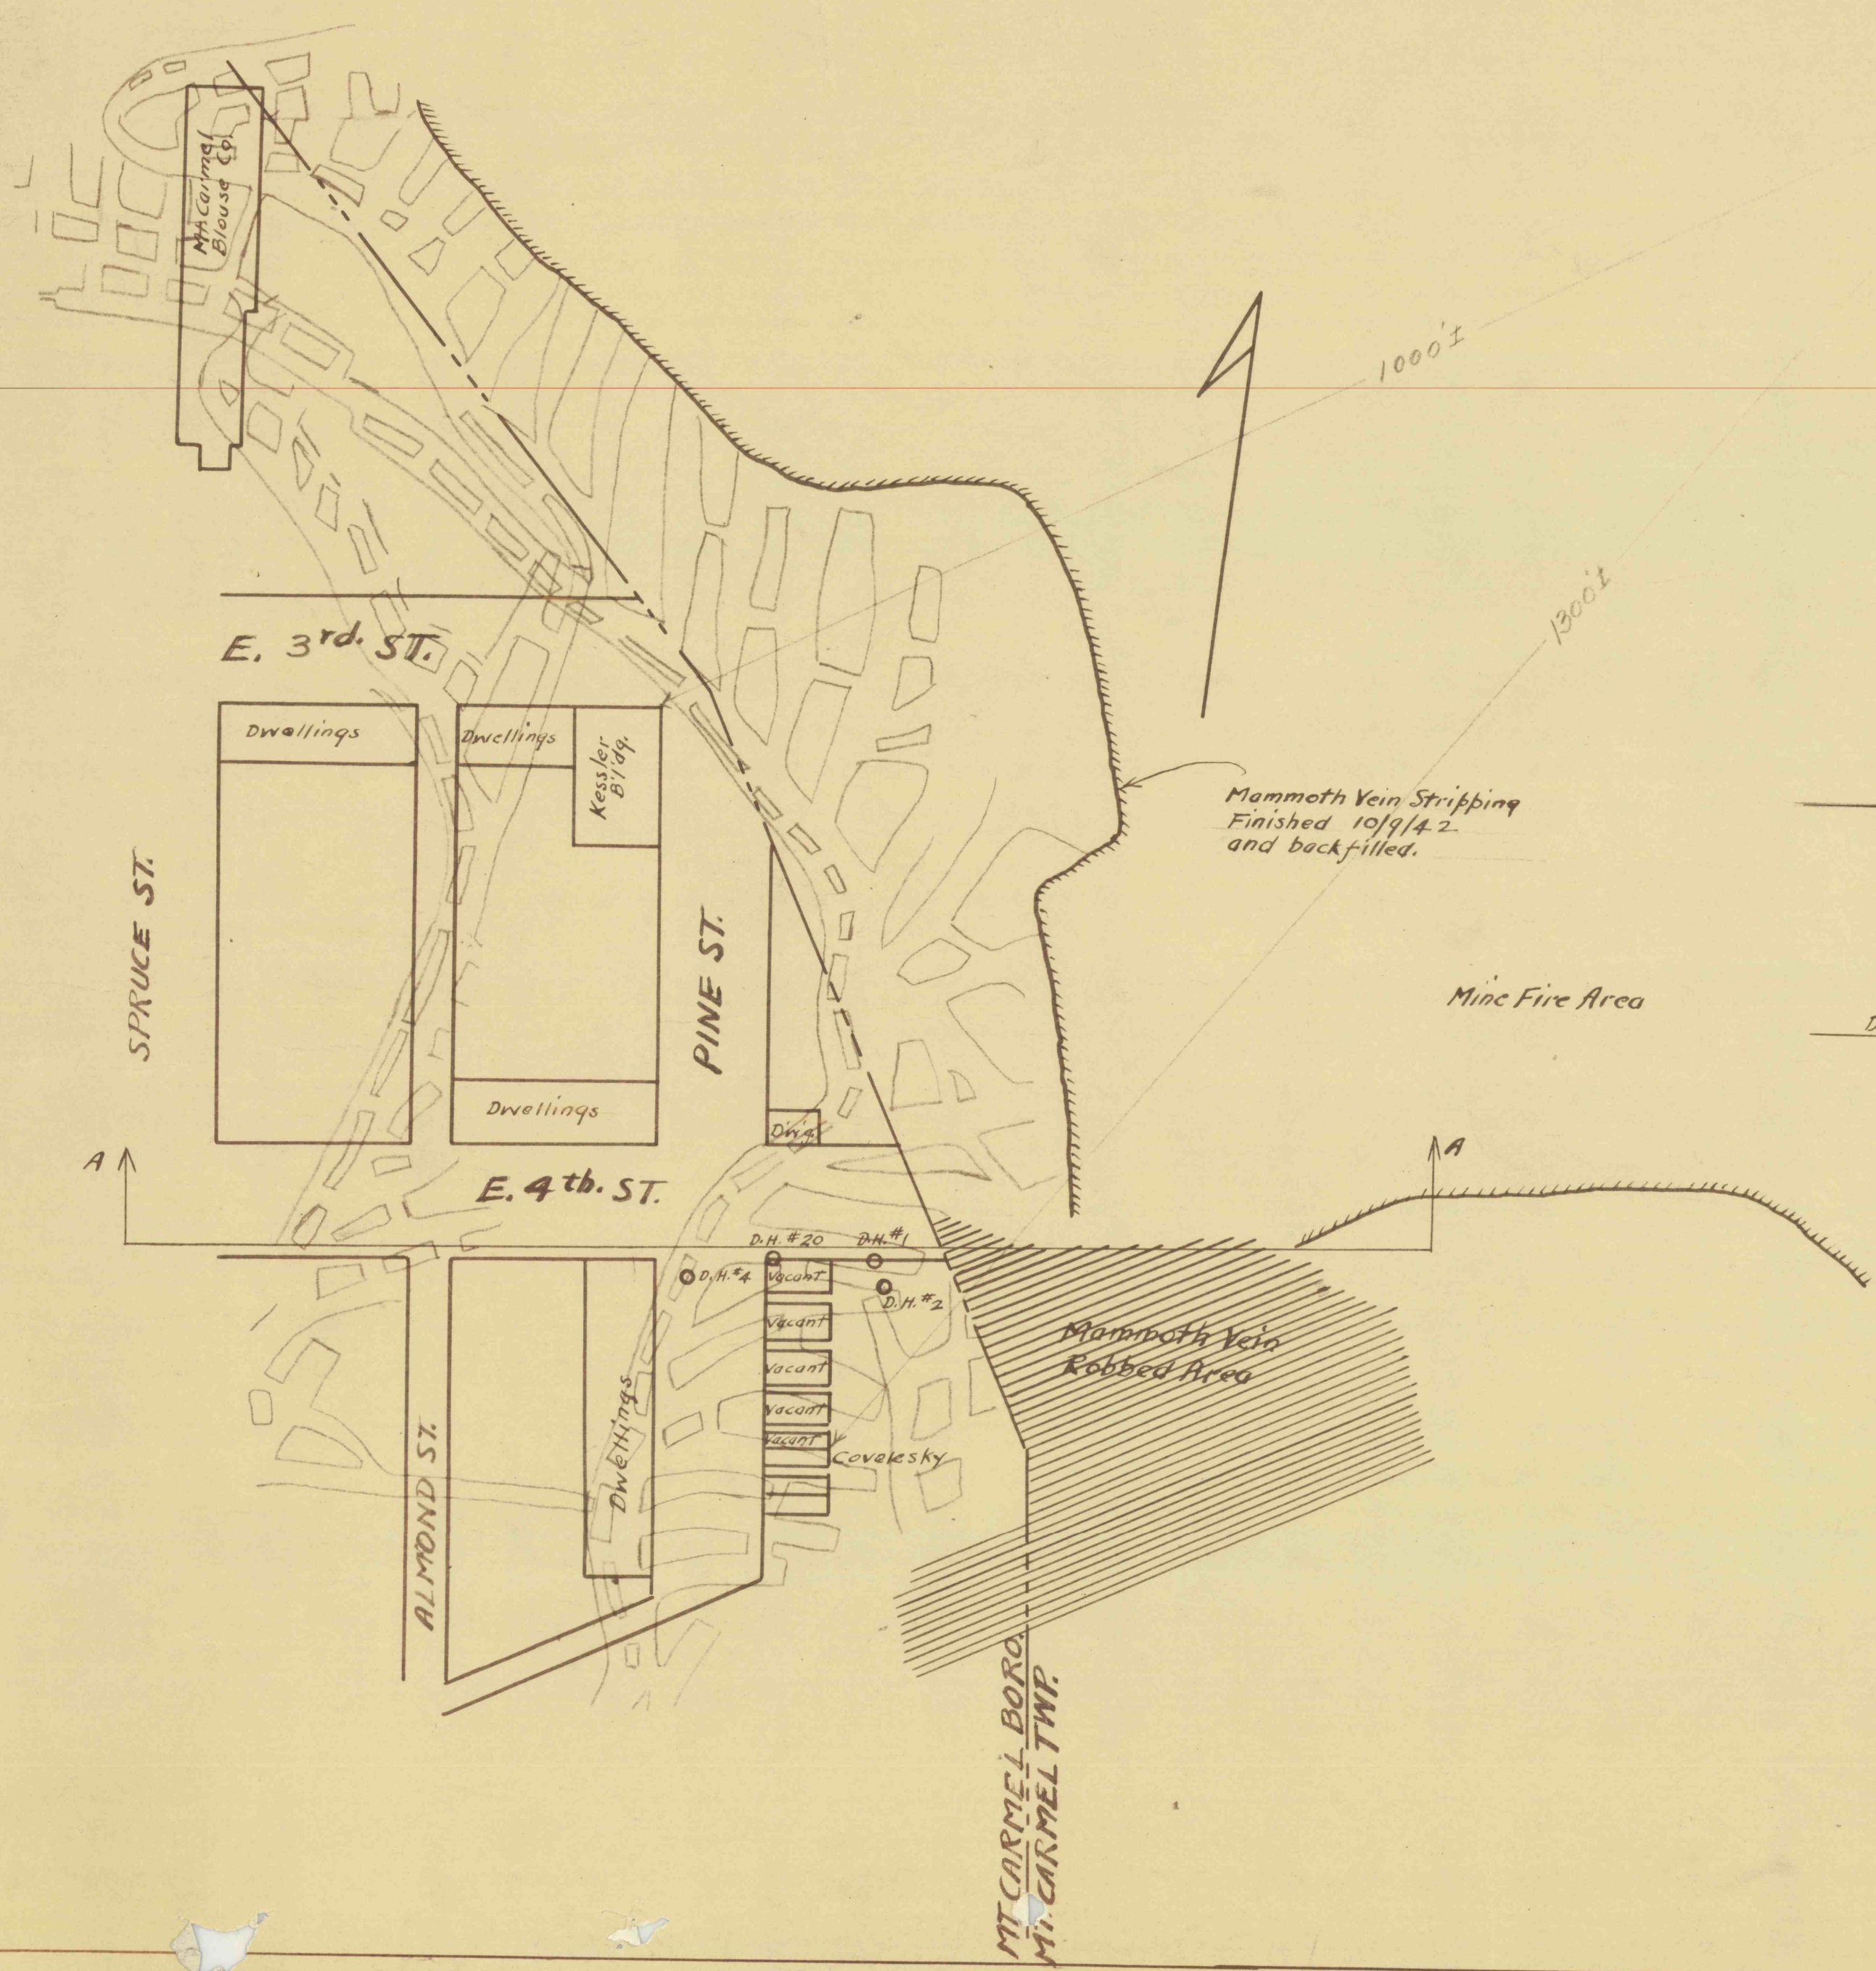

SURFACE AND MAMMOTH VEIN
NEAR 4th AND PINE STS. MT. CARMEL BORO.
RELATIVE- BLASTING COMPLAINT- JOSEPHINE COVELESKY
 1" = 100' 4/7/61
 G.P.G.