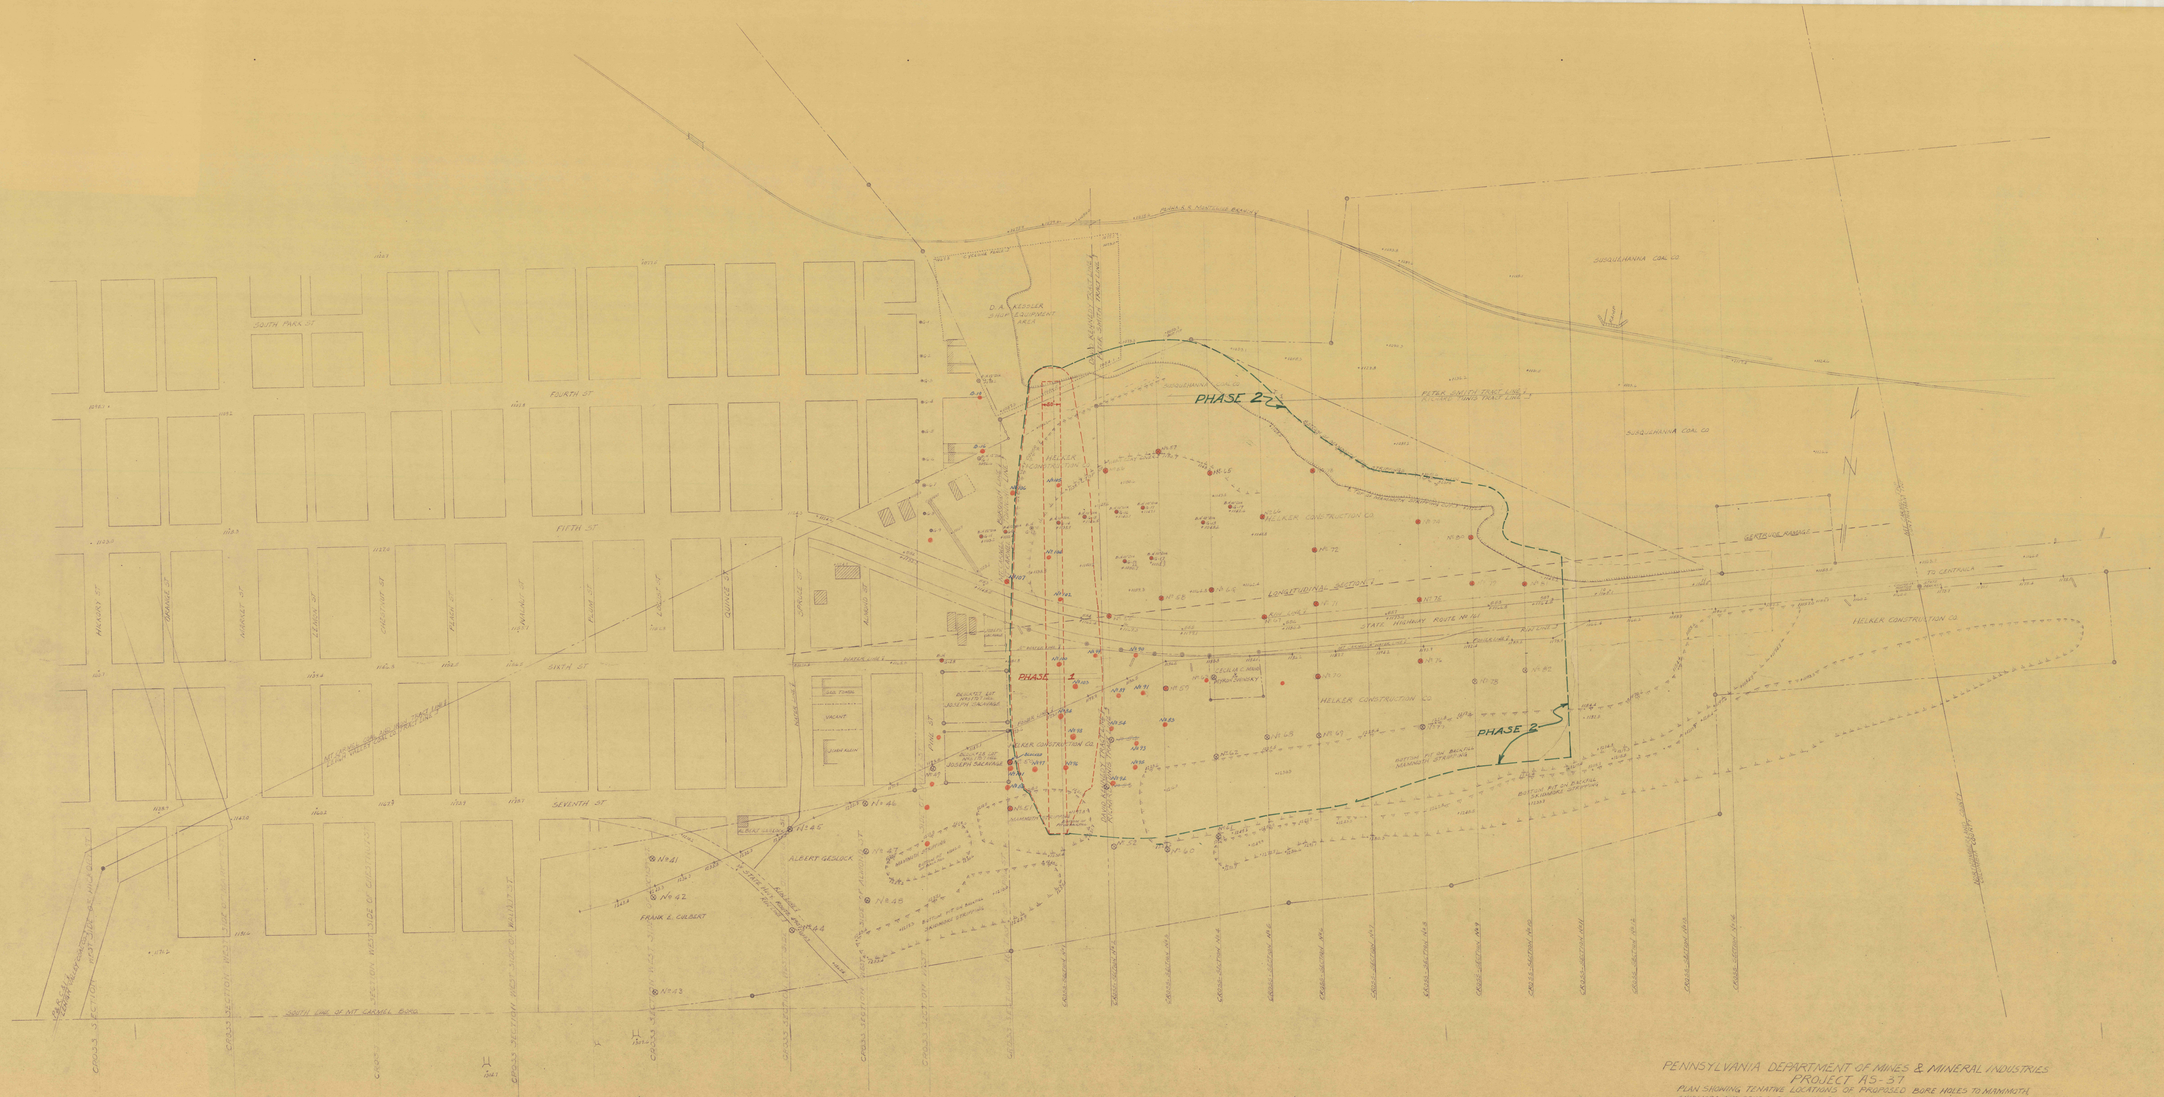

PENNSYLVANIA DEPARTMENT OF MINES & MINERAL INDUSTRIES
PROJECT AS-37

PLAN SHOWING TENATIVE LOCATIONS OF PROPOSED BORE HOLES TO MANHOLES, SKIDMORE AND SEVEN FOOT VEINS FOR THE PURPOSE OF DETERMINING THE LOCATION AND EXTENT OF AN UNDERGROUND FIRE IN THE ABANDONED MT CARMEL MINE LOCATED IN MT CARMEL BORO AND MT CARMEL TOWNSHIP NORTHUMBERLAND CO.

SCALE 1" = 100'

MAY 1, 1965