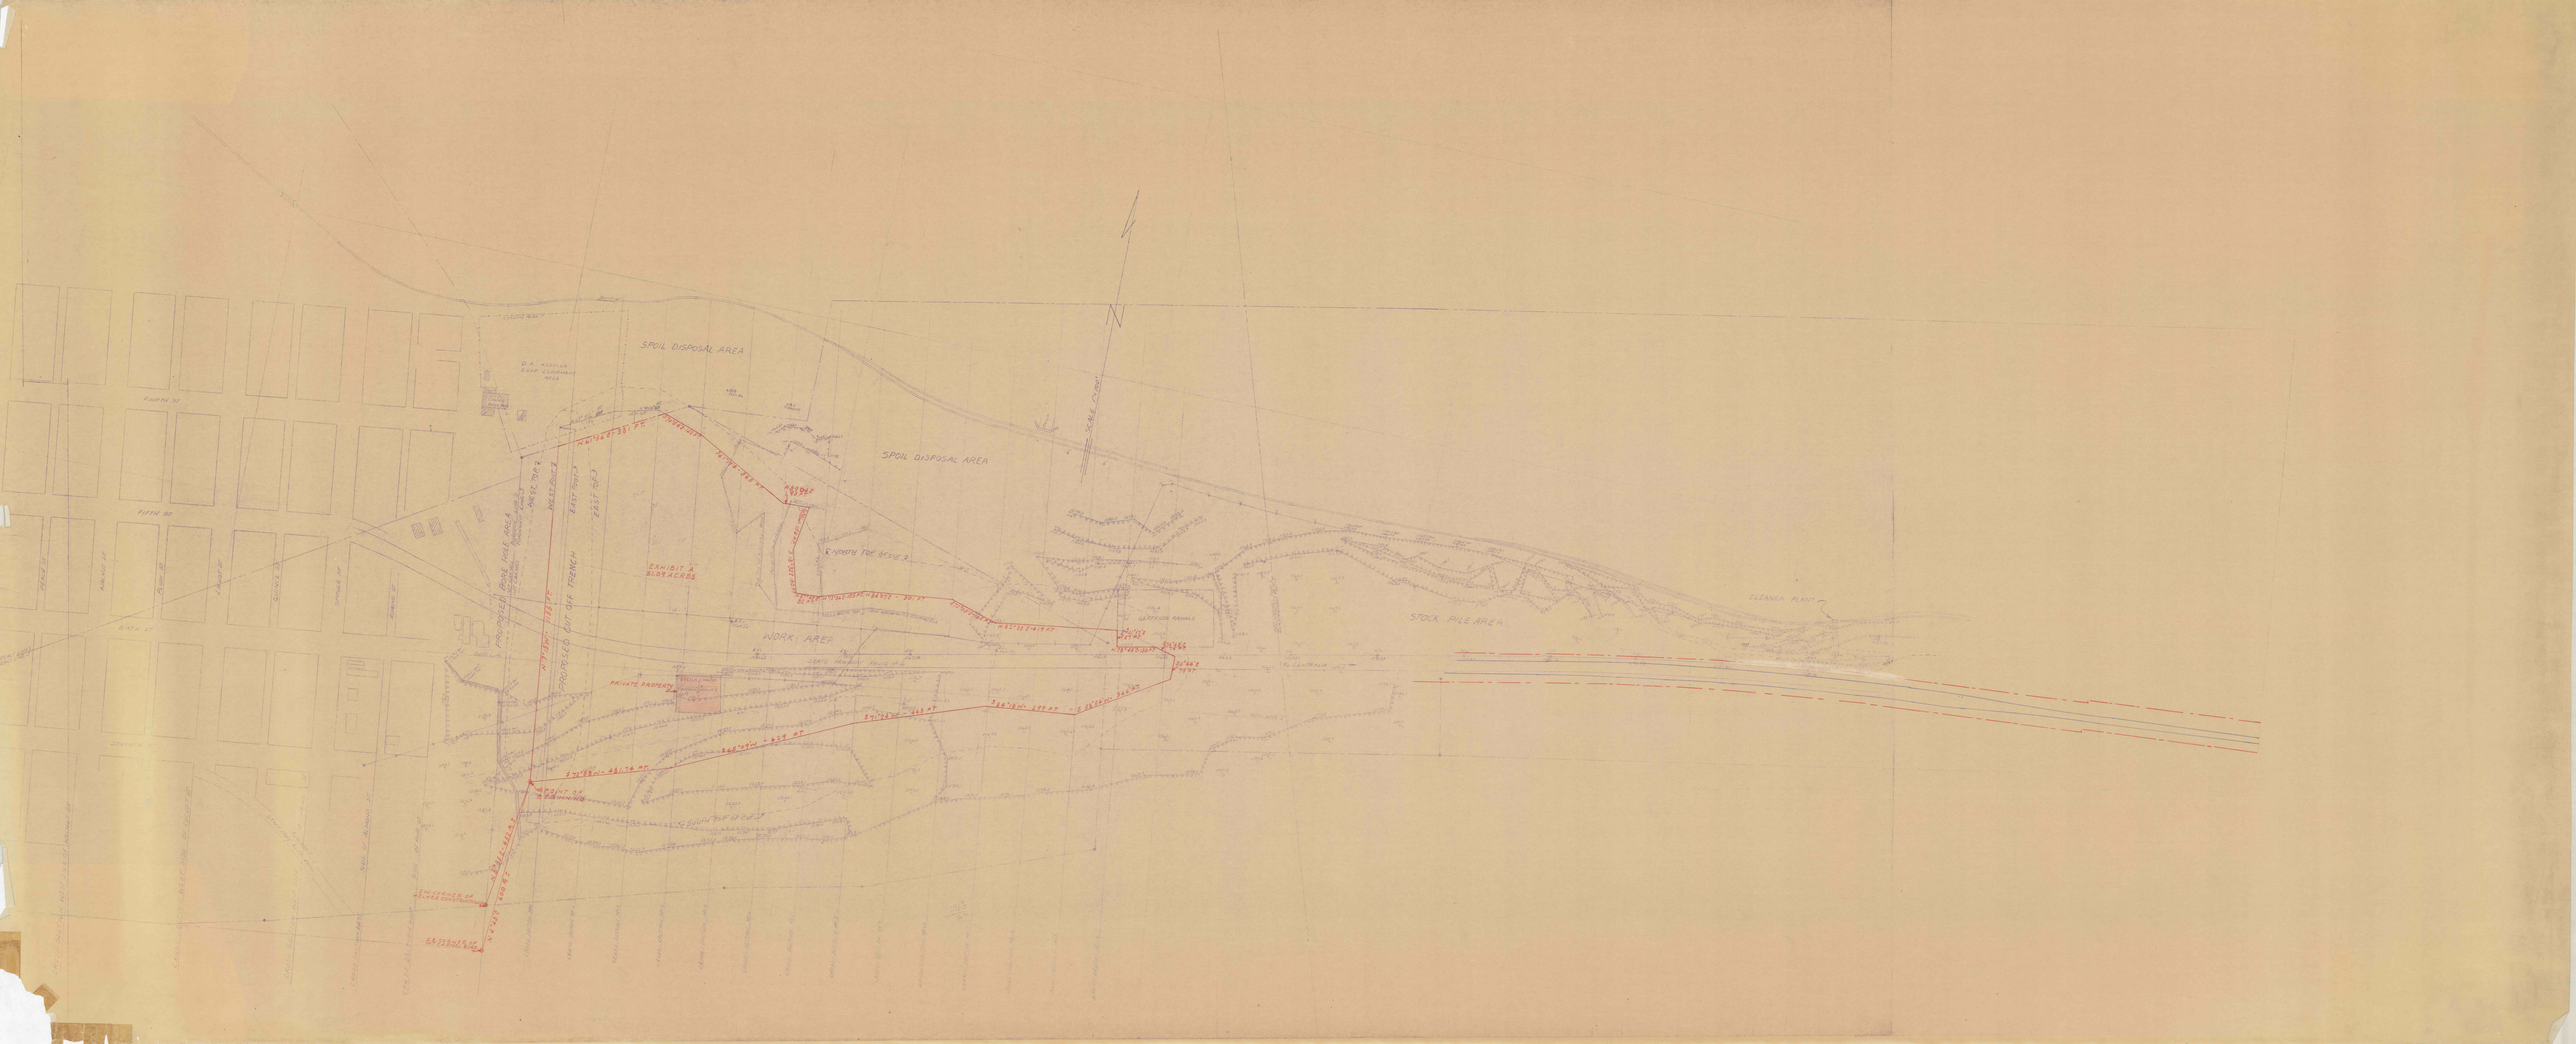
SPOIL DISPOSAL AREA
SPOIL DISPOSAL AREA
N
SCALE 1"=200'
FOURTH ST
FIFTH ST
PROPOSED PIPE LINE AREA
PROPOSED CUT OFF TRENCH
EXHIBIT "A"
8.807 ACRES
WORK AREA
PRIVATE PROPERTY
STOCK PILE AREA
CLEANER PLANT
STATE HIGHWAY ROUTE 99
TO CENTRALIA