


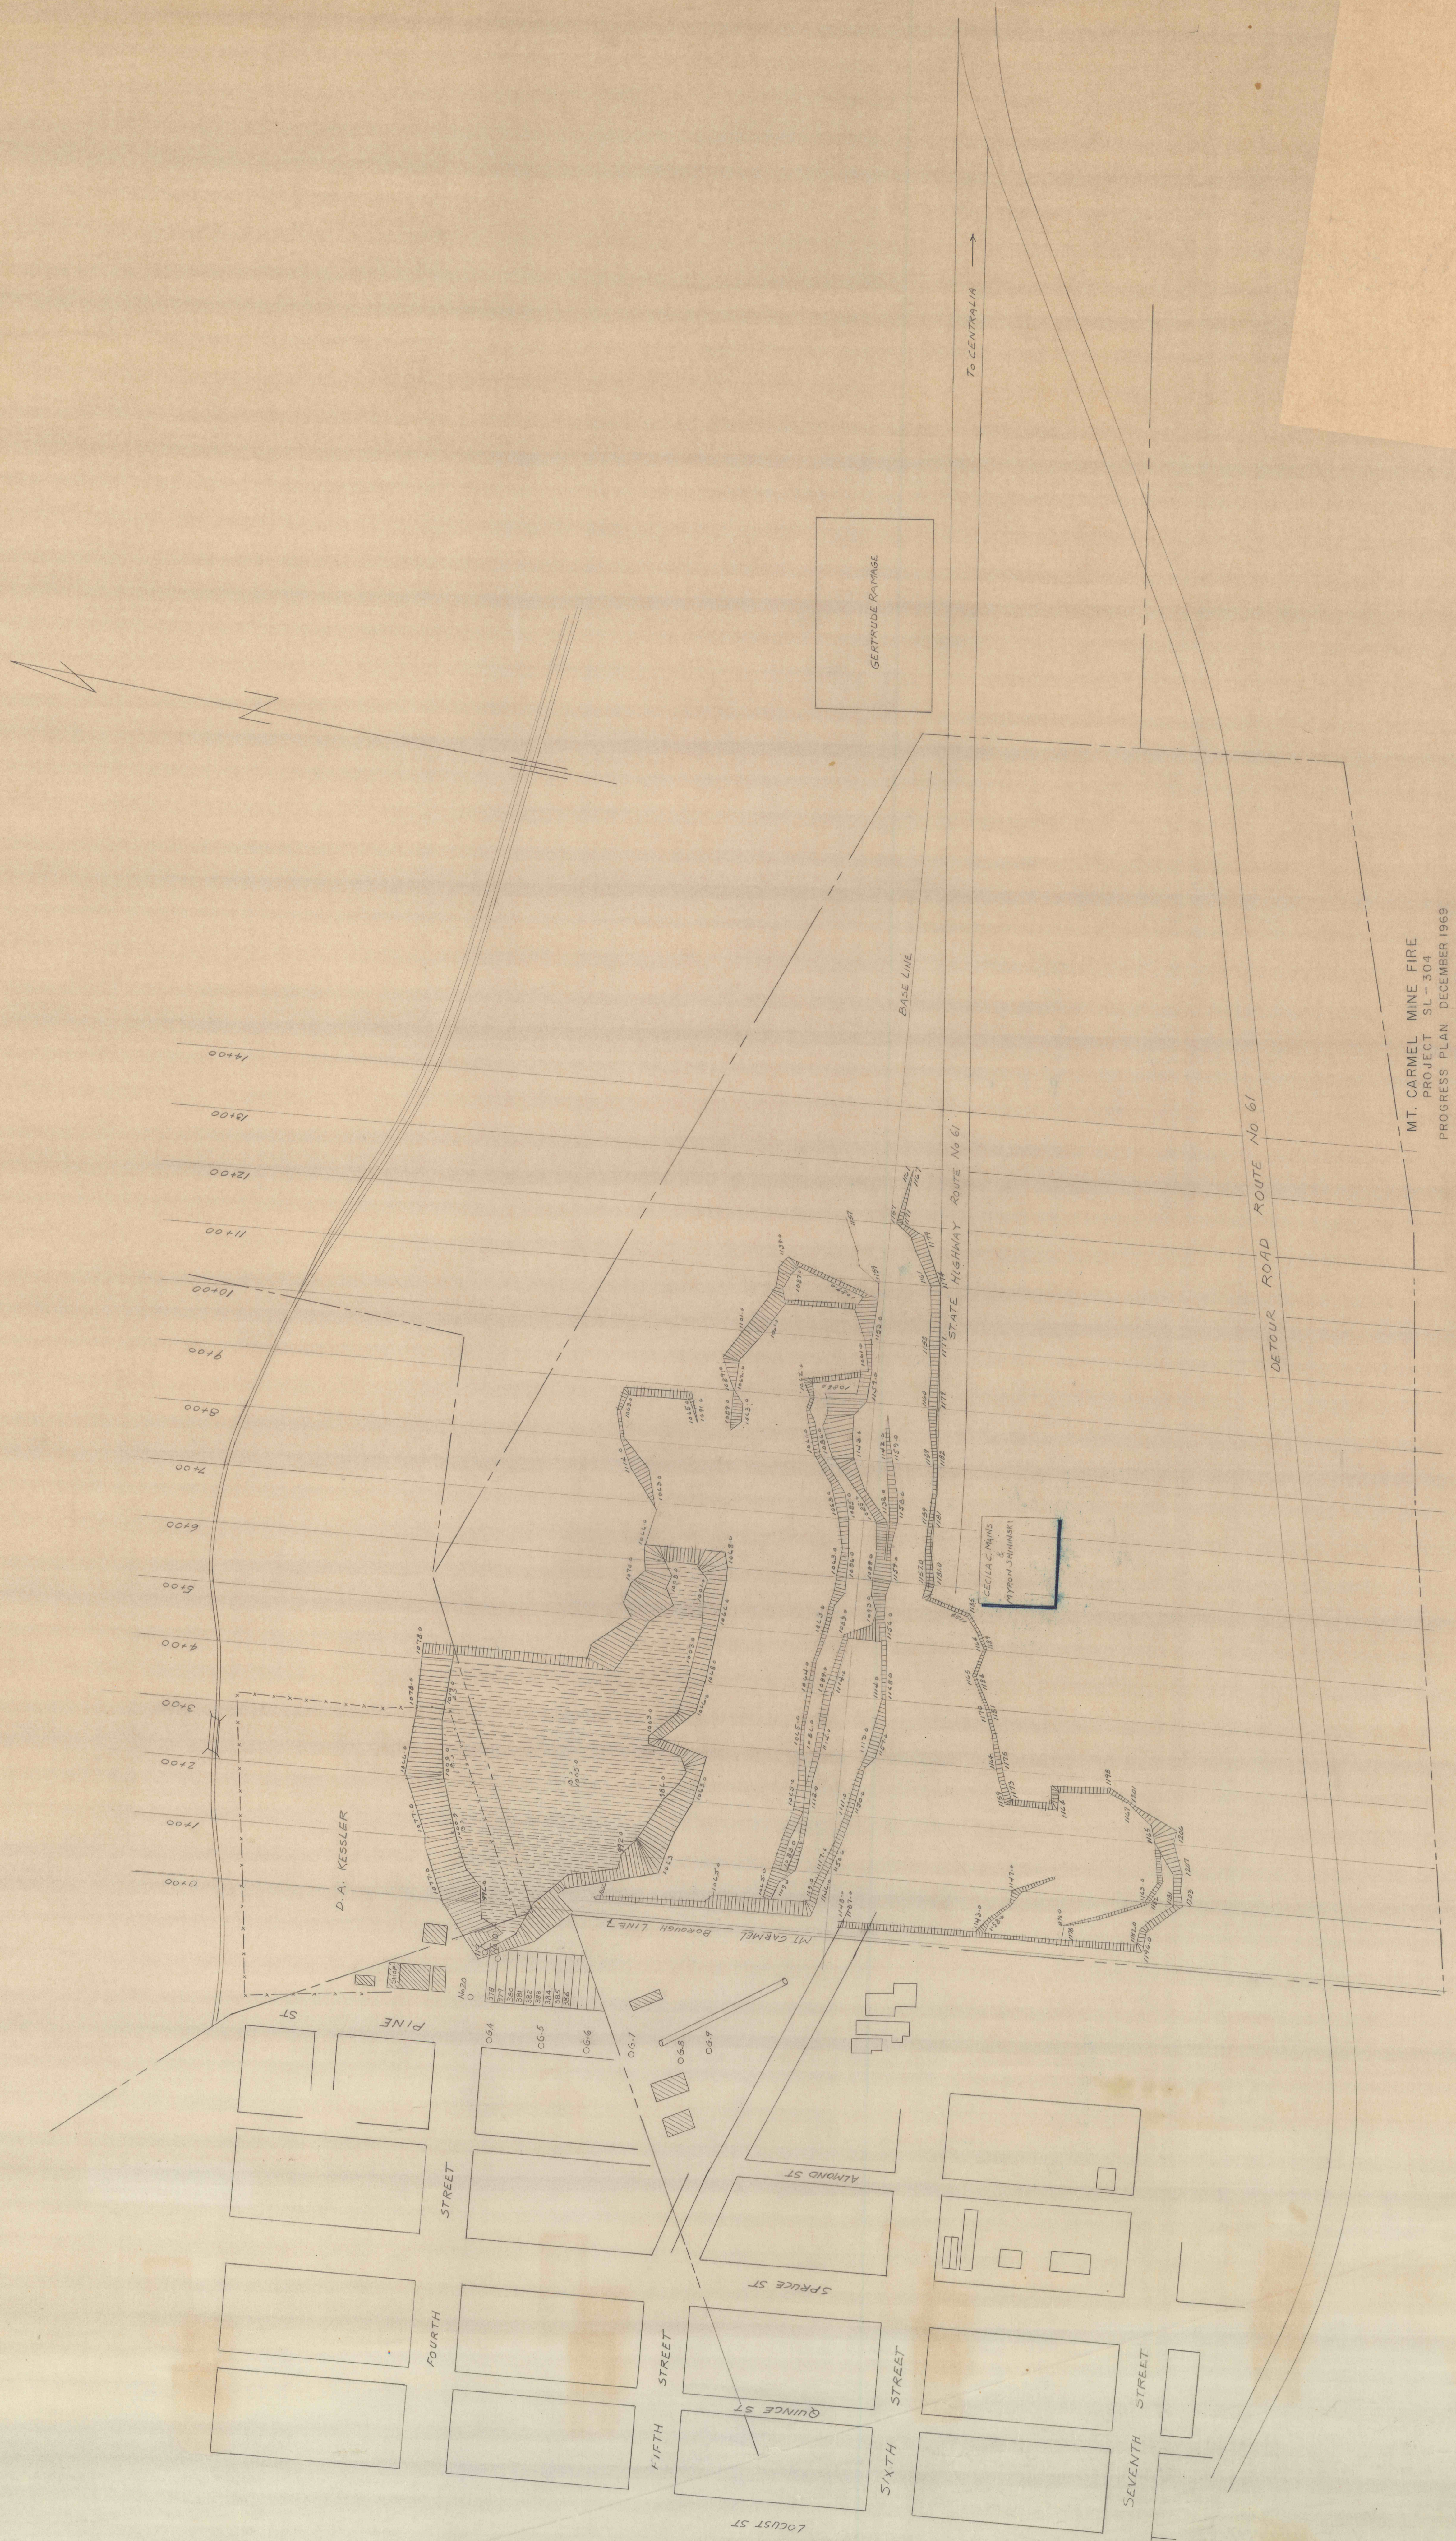

MT. CARMEL MINE FIRE
 PROJECT SL-304

