


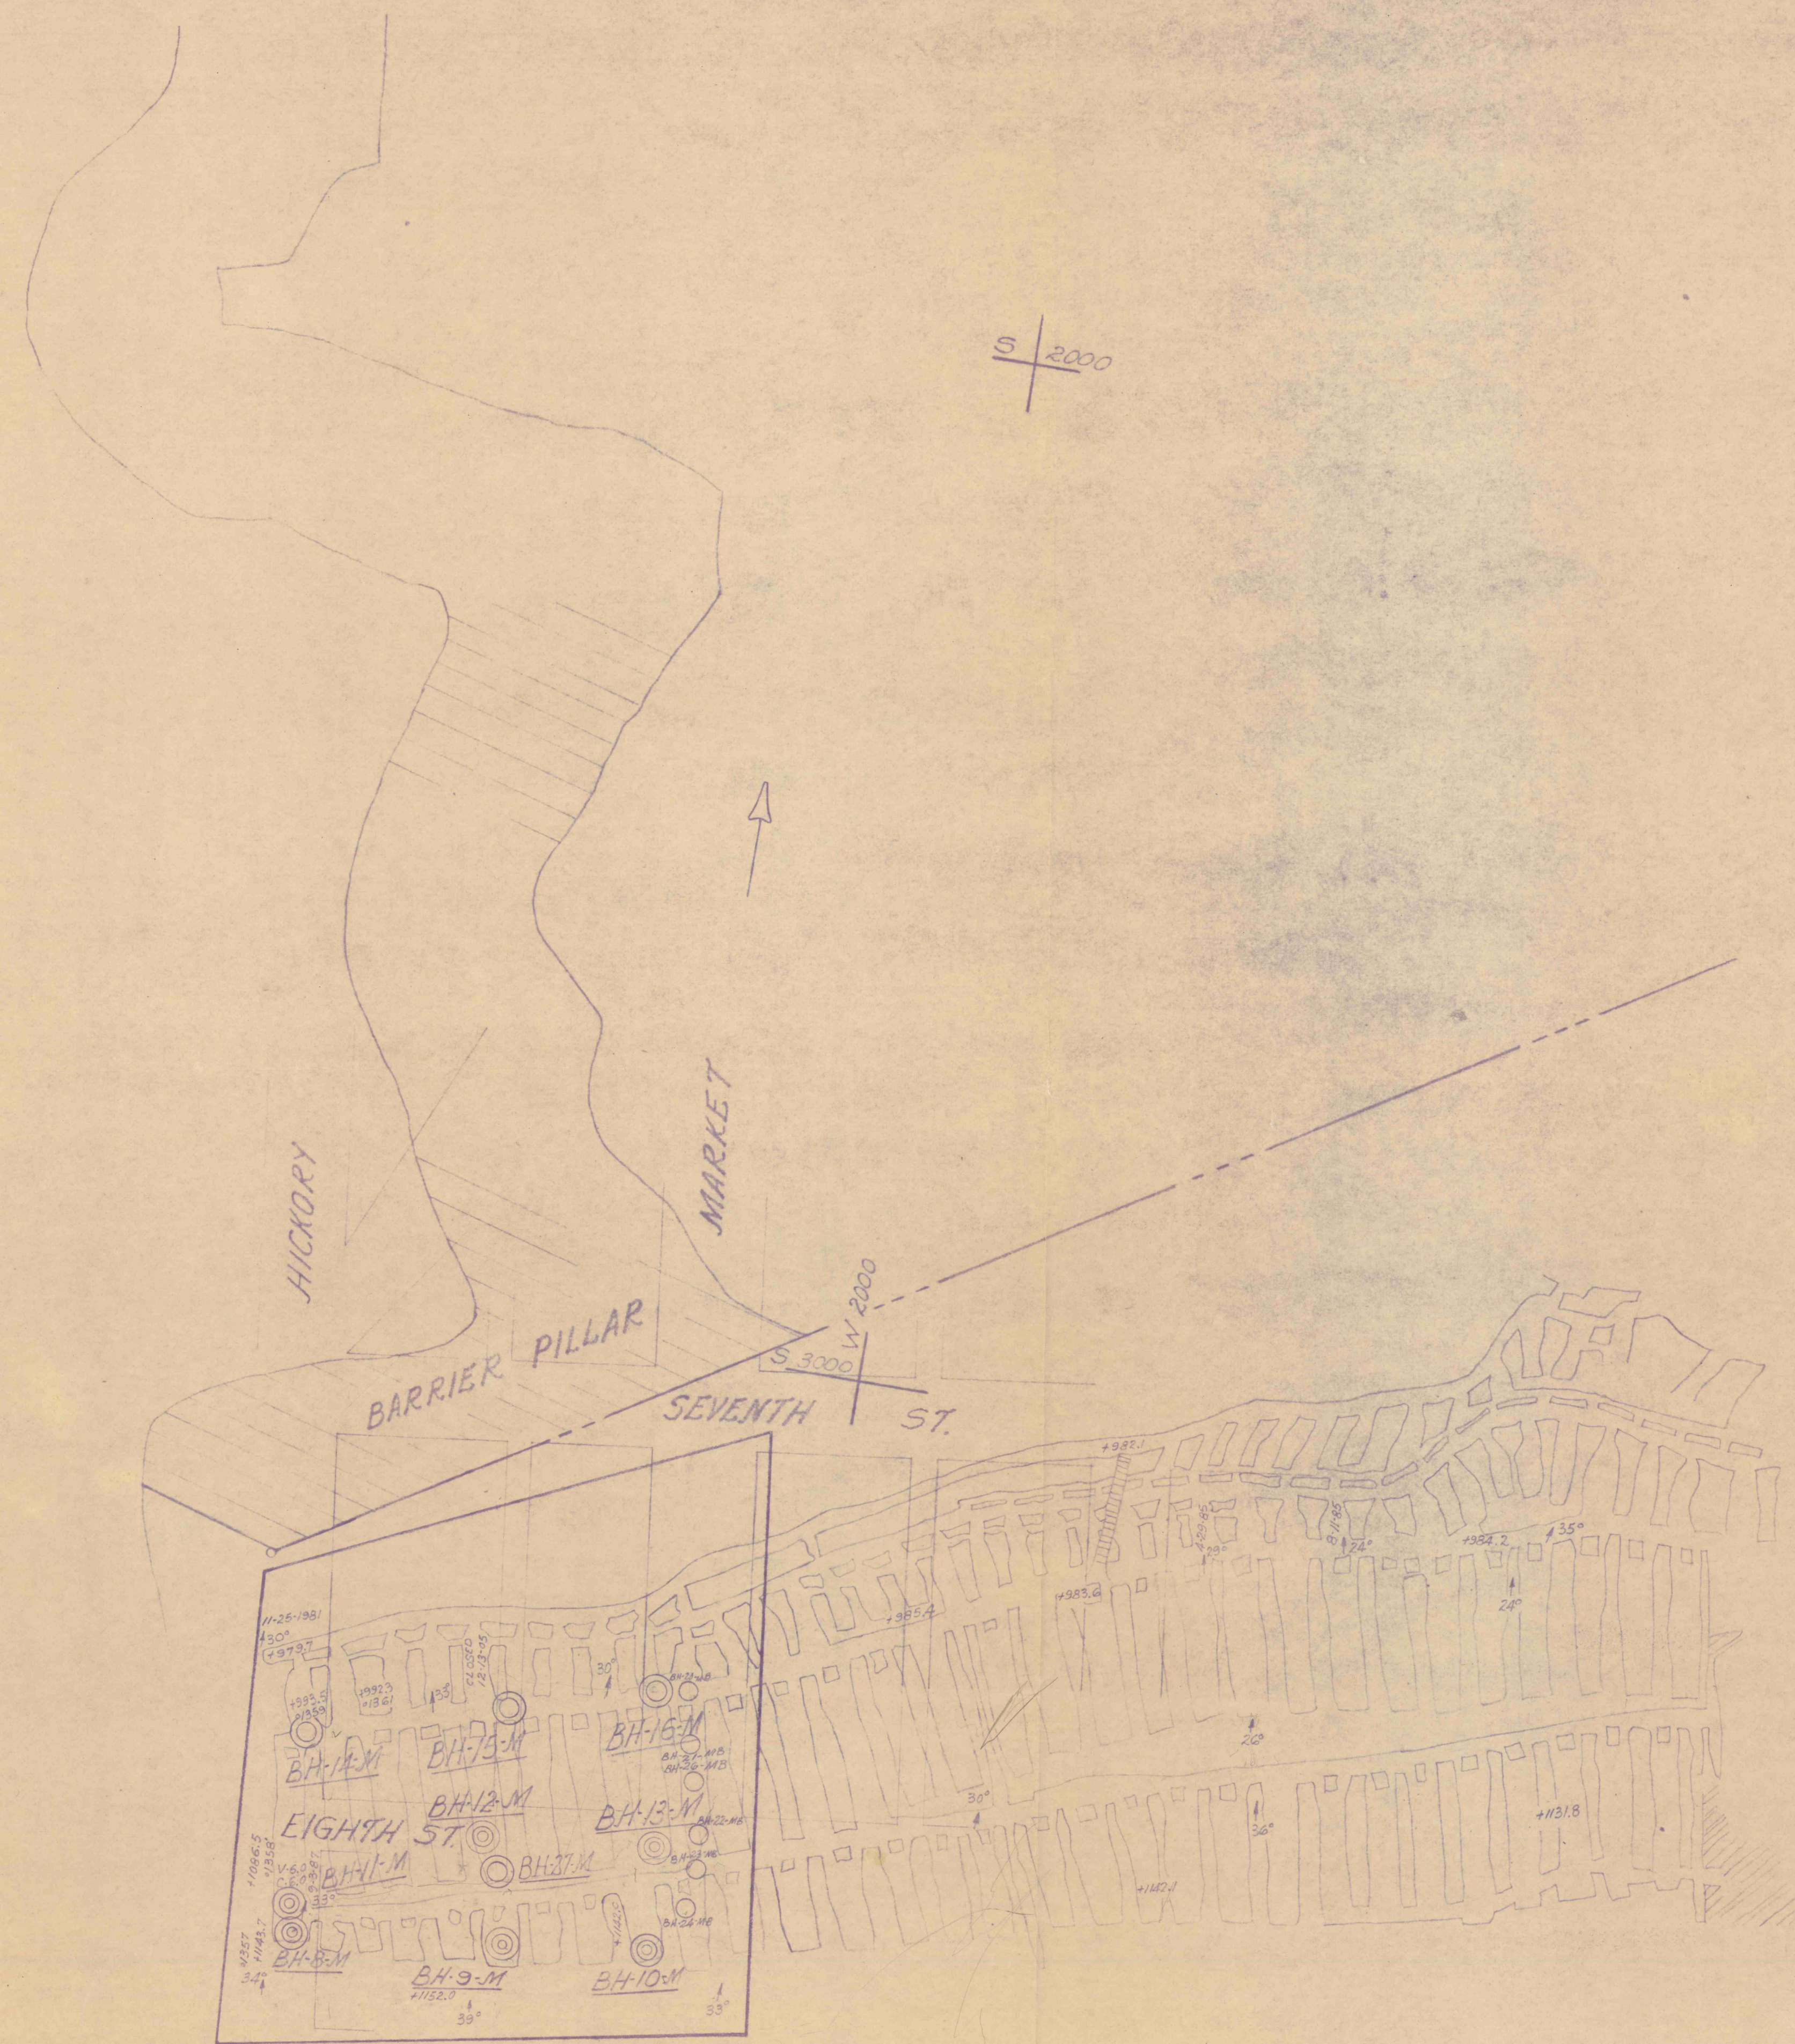

COMMONWEALTH OF PENNSYLVANIA DEPARTMENT OF ENVIRONMENTAL RESOURCES OFFICE OF RESOURCE MANAGEMENT		
No. ASP-18		
FLUSHING PROJECT		
ABANDONED SAYRE MINE		
MIDDLE SPLIT VEIN		
HICKORY & EIGHTH BOROUGH OF MT. CARMEL		NORTHUMBERLAND COUNTY PENNSYLVANIA
DESIGNED		DATE
DRAWN	M.A.Z.	DUBM
		RECOM
GROUP LEADER	APPR	DIRECTOR BUREAU OF CONST.
		DEPUTY SECRETARY OF RESOURCE MGMT.

SCALE 1" = 100'