

ISAAC MILLER.

C

R

I

B

C

Bellmore Colliery


Columbus Colliery No 2 Workings

Mount Carmel Colliery

MINING WORKINGS
IN THE SKIDMORE VEIN
AT THE
MT CARMEL COLLIERY

For the use of Inspector of Mines
Eng Dept Shamokin Div Lehigh Valley
Scale - 100'

Revised To - 1933

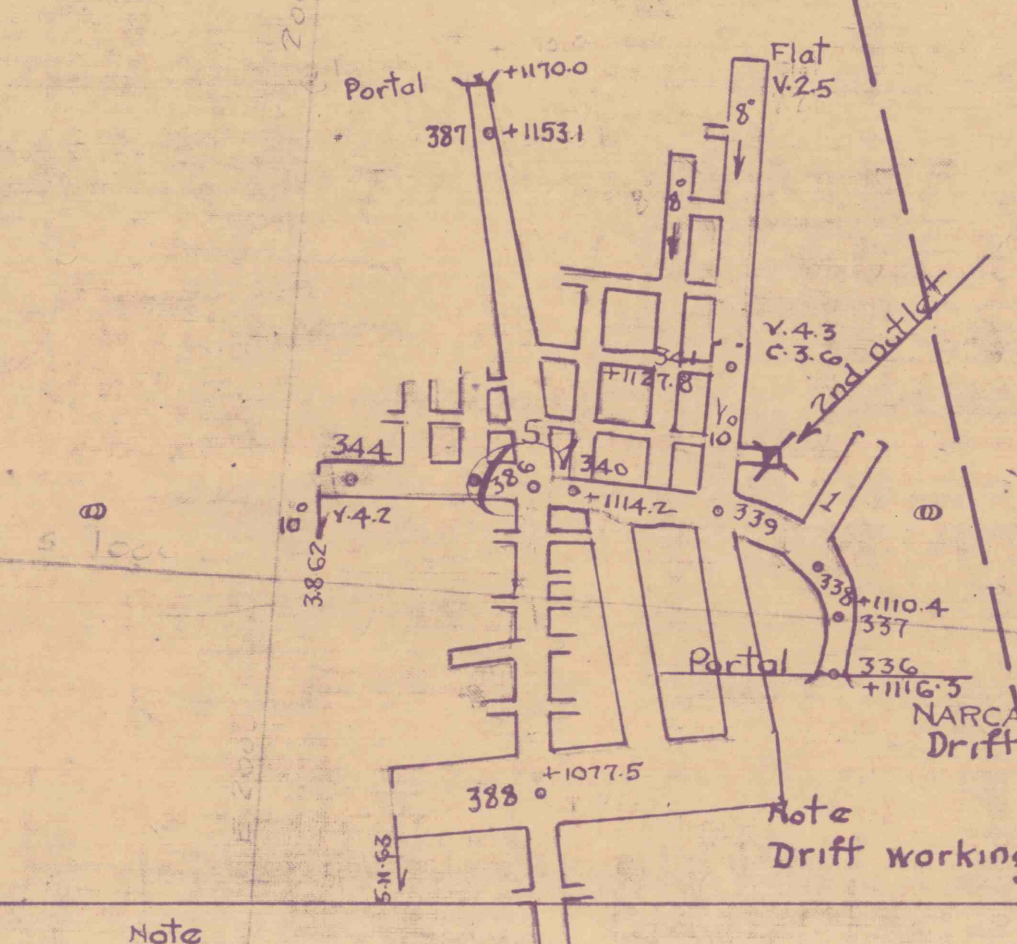

Note:
Face of Shaft - 389±55 ft. 511±57
1110±61 elevation